LINROY
SUBDIVISION.

SECTION 19 T.P.27S.-RG.5W WM.

SCALE- 1" = 50'.

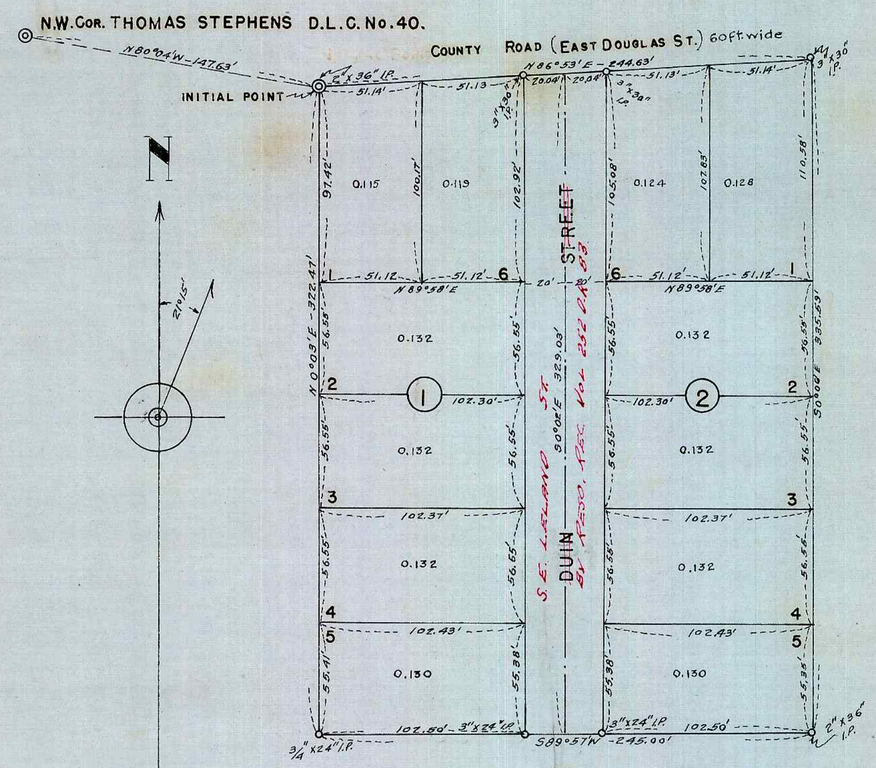

DEDICATION.

KNOW ALL MEN BY THESE PRESENTS, THAT WE R. L. DUNN (BOTH UNMARRIED) AND L.W. INGELS, OWNERS OF THE LANDS SHOWN ON THE ANNEXED PLAT, HAVE CAUSED THE SAME TO BE SURVEYED AND PLATTED BY THE NAME OF LINROY SUBDIVISION AND WE HEREBY DEDICATE TO THE PUBLIC USE FOREVER THE ROADS SHOWN THEREON.

R. L. Dunn
R. L. DUNN

L. W. Ingels
L. W. INGELS

WITNESS

ACKNOWLEDGMENT.

STATE OF OREGON } ss
COUNTY OF DOUGLAS }

ON THE 5th DAY OF June 1946, BEFORE ME APPEARED R.L. DUNN AND L.W. INGELS, (BOTH UNMARRIED) ALL TO ME PERSONALLY KNOWN, WHO BEING DULY SWORN DID SAY, THAT THEY ARE THE OWNERS OF THE LANDS SHOWN ON THE ANNEXED PLAT AND ACKNOWLEDGED THAT THE ABOVE INSTRUMENT WAS THEIR FREE ACT AND DEED.

IN TESTIMONY WHEREOF I HAVE HEREUNTO SET MY HAND AND SEAL THE DAY AND YEAR ABOVE WRITTEN.

Roy Agee
COUNTY CLERK

CERTIFICATE OF SURVEYOR.

I, EDWIN S. WOODFORD, BEING FIRST DULY SWORN: DEPOSE AND SAY, THAT I HAVE SURVEYED AND MARKED WITH PROPER MONUMETS THE LANDS SHOWN ON THE ANNEXED PLAT OF WHICH THE FOLLOWING IS A CORRECT DESCRIPTION.

BEGINNING AT A POINT FROM WHICH THE NORTHWEST CORNER OF THE THOMAS STEPHENS D.L.C. No 40 T.P. 27S - RG. 5W WM., BEARS N 80° 04' W - 147.63 FT.

THENCE N 86° 53' E - 244.63, ALONG THE SOUTH LINE OF THE COUNTY ROAD, THENCE S 0° 06' E - 335.59' TO A POINT, THENCE S 89° 57' W - 245.00' TO A POINT, THENCE N 0° 03' E - 332.47' TO THE PLACE OF BEGINNING. CONTAINING 1.851 ACRES MORE OR LESS.

Edwin S Woodford
CIVIL ENGINEER

SUBSCRIBED AND SWORN TO BEFORE ME THIS 29th DAY OF May 1946.

Roy Agee
COUNTY CLERK

REGISTERED PROFESSIONAL ENGINEER 622 OREGON DEC. 8, 1939 Edwin S. Woodford

FILED June 7 1946

Roy Agee
COUNTY CLERK.

State of Oregon } ss
County of Douglas }

I, ROY AGEE COUNTY CLERK OF DOUGLASS COUNTY OREGON HEREBY CERTIFY THAT THIS COPY OF LINROY SUBDIVISION HAS BEEN COMPARED BY ME WITH THE ORIGINAL THEREOF AND THAT IT IS A CORRECT COPY THEREFROM, AND OF THE WHOLE OF SUSH ORIGIONAL AS FILED IN MY OFFICE AND CUSTODY.

IN TESTIMONY WHEREOF, I HAVE HEREUNTO SET MY HAND AND AFFIXED MY OFFICIAL SEAL THIS 7th DAY OF June 1946.

Roy Agee
COUNTY CLERK

APPROVALS.

APPROVED June 6 1946.
COUNTY SURVEYOR.

APPROVED June 5 1946.
COUNTY ASSESSOR.

APPROVED June 6 1946.
COUNTY JUDGE.

APPROVED MAY 4, 1946.
CITY ENGINEER ROSEBURG OREGON.

6/36
6-36

VOL 6 PAGE 36

VOL 6 PAGE 36