

State of Oregon) s.s.
(County of Douglas))
I, Victor M. McInd, being first duly sworn and say that I am the Surveyor who surveyed the plat of Trask Acres Subdivision and that this is an exact copy of the final plat thereof.

Subscribed and sworn to before me this 13th day of June 1978

Victor M. McInd
Jorda L. Taylor
NOTARY PUBLIC

MY COMMISSION EXPIRES 5-16-81

TRASK ACRES

IN SECTION 5, T 30 S, R 5 W, W.M. JUNE, 1978

State of Oregon) s.s.
(County of Douglas))

I, Doris Wadsworth, County Clerk of Douglas County, do hereby certify that the copy of plat has been compared by me with the original thereof and that it is an exact copy of the whole thereof as the same appears on file in my office and custody.

Witness my hand and official seal this 21st day of June, 1978

Doris Wadsworth
County Clerk

DEDICATION

Know all men by these present that we, Delbert C. Trask and Frances Trask are the owners of the land shown and described on the annexed plat and that we have caused the same to be surveyed and to be platted by the name of "TRASK ACRES" and that we here by dedicate to the use of the public forever the streets shown hereon.

Delbert C. Trask
Delbert C. Trask

Frances Trask
Frances Trask



ACKNOWLEDGEMENT

STATE OF OREGON) S.S.
COUNTY OF DOUGLAS)

On the 13th day of June, 1978, before me appeared Delbert C. Trask, Frances Trask, to me known to be the persons described in and who executed the foregoing dedication, who being duly sworn, did say that they executed the same for the purpose set forth therein.

Jorda L. Taylor
Notary Public for State of Oregon

My Commission expires 5-16-81

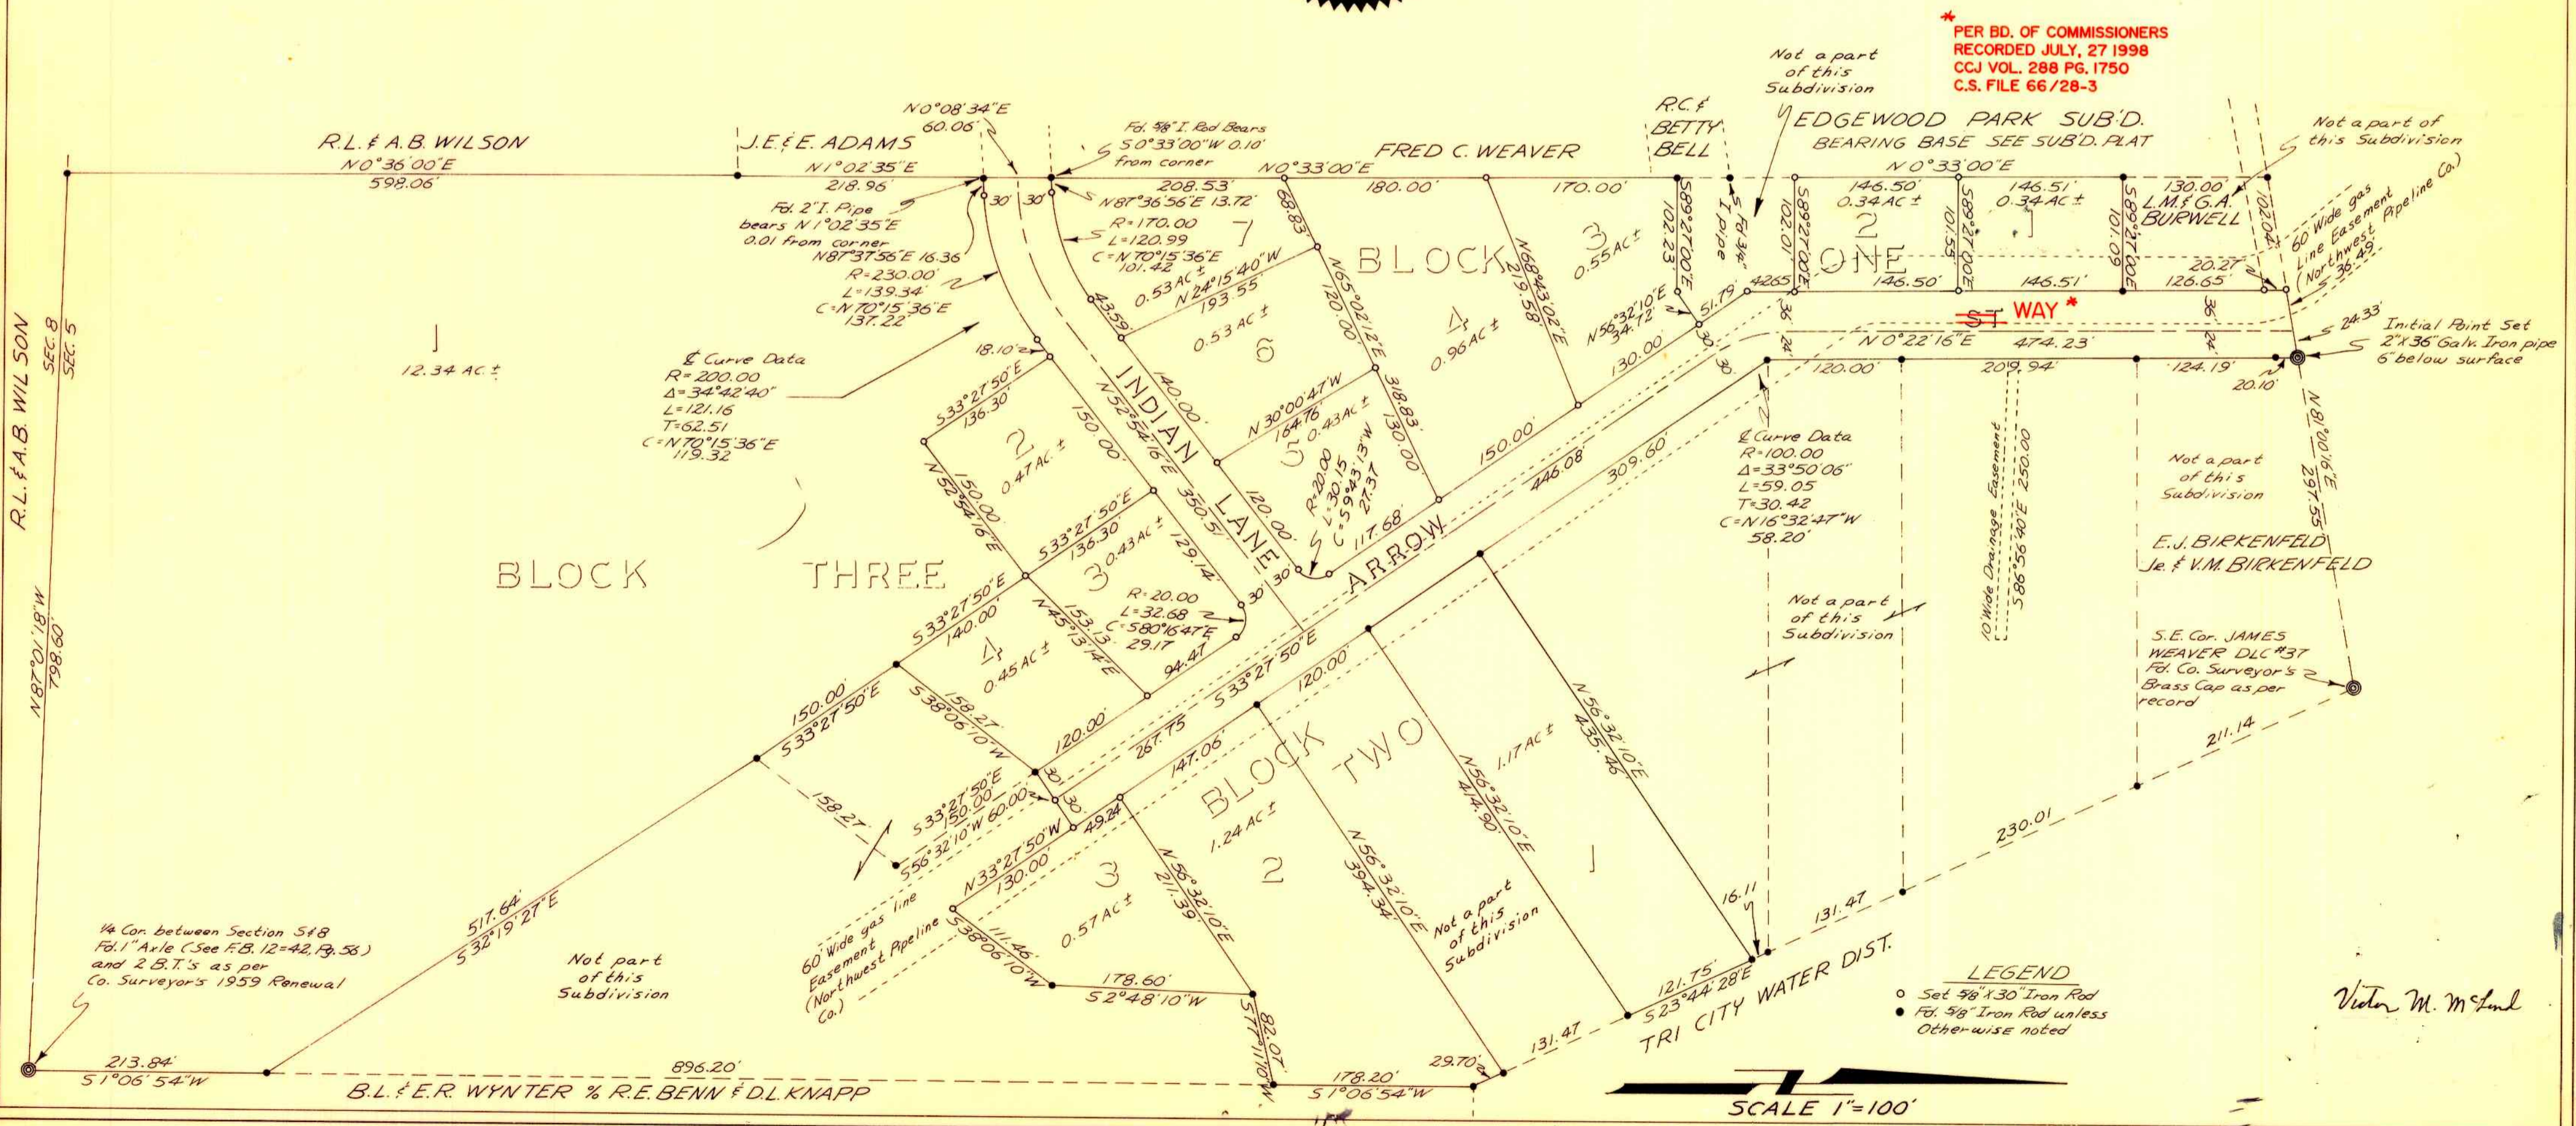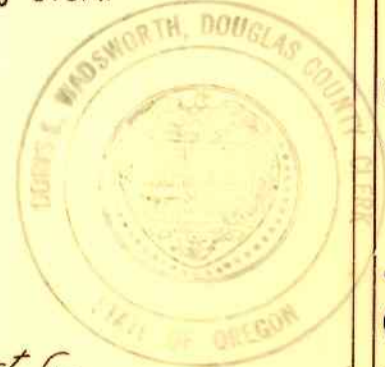

* PER BD. OF COMMISSIONERS
RECORDED JULY, 27 1998
CCJ VOL. 288 PG. 1750
C.S. FILE 66/28-3

LEGEND
o Set 5/8" x 30" Iron Rod
Otherwise noted

SCALE 1"=100'

Victor M. McInd