COUNTY SURVEYORS FILE DATA
DO NOT REMOVE FROM OFFICE

DONRUSS SUBDIVISION

for Lance & Bonita Seter
NE 1/4 of Sec. 36, T.26S., R.07W., W.M.
DOUGLAS COUNTY, OREGON
FEBRUARY 2004

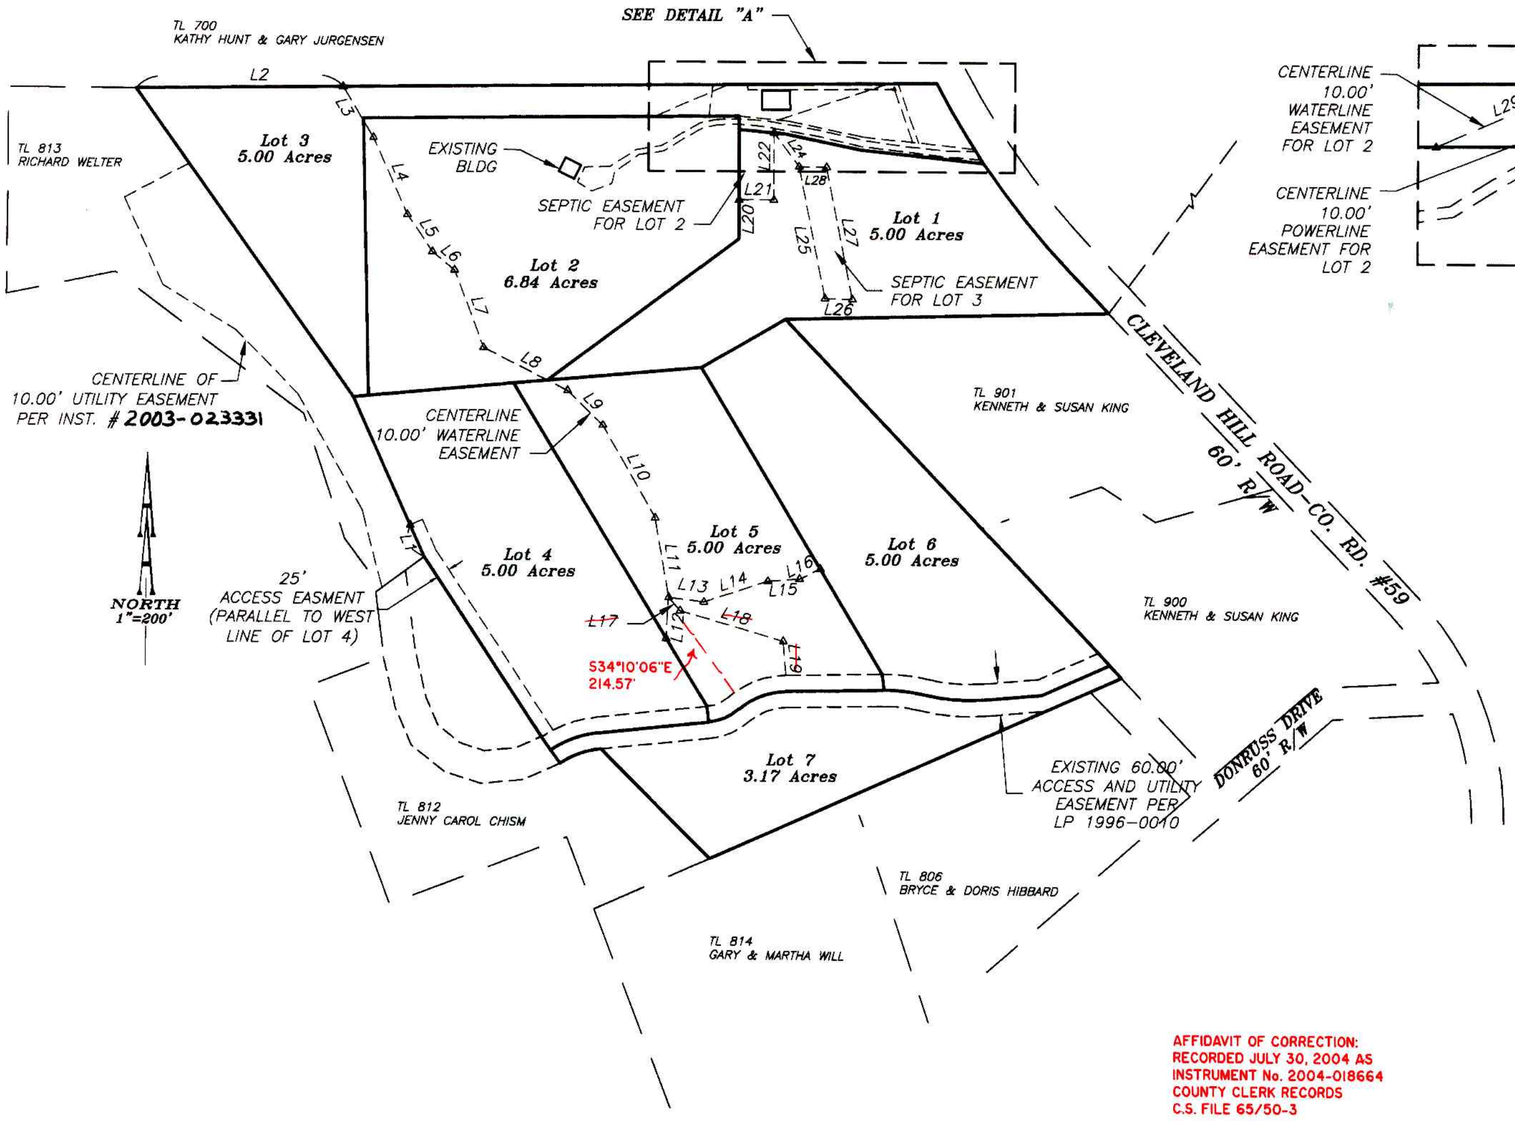

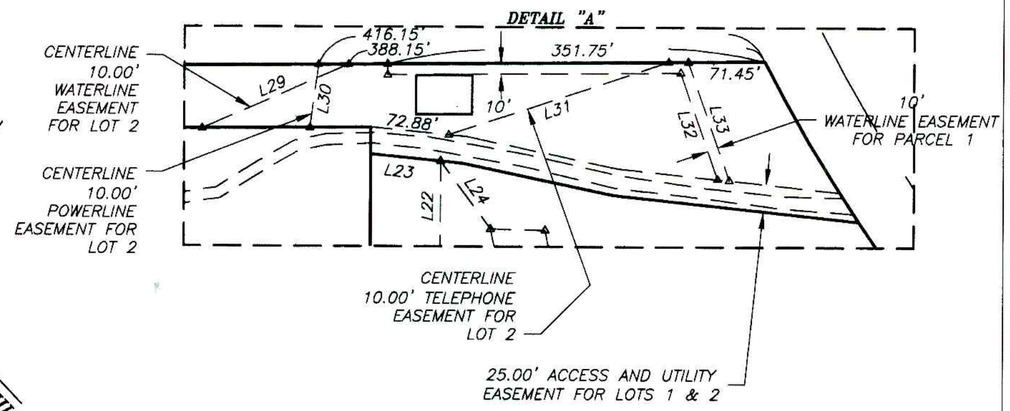

EASEMENTS

NUMBER	DIRECTION	DISTANCE
L1	N24°08'50"W	64.78'
L2	N89°28'40"E	385.53'
L3	S30°55'52"E	110.74'
L4	S23°58'25"E	157.04'
L5	S34°12'55"E	82.89'
L6	S50°49'14"E	53.53'
L7	S20°43'37"E	154.48'
L8	S63°11'23"E	175.55'
L9	S45°41'00"E	91.67'
L10	S29°42'33"E	198.19'
L11	S09°51'19"E	149.80'
L12	S03°17'16"W	76.81'
L13	S82°37'05"E	65.44'
L14	N71°37'02"E	124.85'
L15	N85°52'22"E	59.71'
L16	N63°59'04"E	42.91'
~~L17~~	~~S41°02'50"E~~	~~32.81'~~

NUMBER	DIRECTION	DISTANCE
~~L18~~	~~S73°39'59"E~~	~~199.72'~~
~~L19~~	~~S04°19'12"E~~	~~63.16'~~
L20	NORTH	72.05'
L21	EAST	65.00'
L22	NORTH	125.00'
L23	S84°29'46"E	65.30'
L24	S36°39'58"E	78.30'
L25	S11°18'15"E	249.86'
L26	S88°45'47"E	51.05'
L27	N11°18'15"W	249.86'
L28	N88°45'47"W	51.05'
L29	S66°20'24"W	149.01'
L30	S07°32'25"W	59.14'
L31	N71°38'04"E	215.76'
L32	N19°19'27"W	104.84'
L33	N19°19'27"W	116.73'

AFFIDAVIT OF CORRECTION:
RECORDED JULY 30, 2004 AS
INSTRUMENT No. 2004-018664
COUNTY CLERK RECORDS
C.S. FILE 65/50-3

REGISTERED
PROFESSIONAL
LAND SURVEYOR
OREGON
JULY 14, 1978
HERMAN A. PIESKE
1651
EXP. DATE: 12-31-04

SURVEYING & ENGINEERING, INC.
ENGINEERING • SURVEYING • PLANNING
3076 NE DIAMOND LAKE BLVD.
ROSEBURG, OREGON 97470
TEL (541)672-2096
FAX (541)672-0611

VOL. 21 PAGE 22 B

VOL. 21 PAGE 22 B