


LINE TABLE		
LINE	BEARING	LENGTH
L36	S05°52'29"W	265.00'
L37	S72°22'30"E	199.20'
L38	S65°05'41"E	273.05'
L39	S72°22'30"E	20.41'
L40	S72°22'30"E	147.57'
L42	S72°22'30"E	222.86'
L43	N83°47'05"W	60.25'
L44	N83°47'05"W	55.59'
L45	N11°24'10"E	262.39'
L46	N43°09'55"E	90.00'
L47	N61°58'00"W	227.61'
L48	N43°09'55"E	241.22'
L49	S43°26'19"E	126.18'
L50	N19°01'08"E	167.15'
L51	N55°58'33"W	38.67'
L52	N61°58'00"W	12.66'
L53	N11°32'16"E	107.81'
L54	N67°20'43"E	93.43'
L55	N77°34'53"E	110.42'
L56	N47°43'15"E	29.80'
L57	S25°26'15"E	448.88'
L58	S69°56'32"E	84.66'
L59	N68°17'39"E	140.03'
L60	N26°46'13"W	576.12'
L66	S55°58'33"E	38.67'
L67	S19°01'08"W	168.67' 165.86' *
L72	S65°05'41"E	36.24'
L73	S72°22'30"E	17.40'

AFFIDAVIT OF CORRECTION: *
RECORDED JAN 03, 2005 AS
INSTRUMENT No. 2005-000001
COUNTY CLERK RECORDS
C.S. FILE 65/53-1

CURVE TABLE				
CURVE	CHORD BEARING	CHORD LENGTH	RADIUS	CURVE LENGTH
C2	N18°28'43"W	121.75'	100.00'	130.89'
C3	S42°54'03"E	45.25'	100.00'	45.64'
C6	S47°50'54"E	24.74'	87.50'	24.82'
C7	N18°28'43"W	136.96'	112.50'	147.25'
* C6	N39°37'45"W	63.33'	112.50'	64.19'
* C7	N18°28'43"W	106.53'	87.50'	114.53'

NOTE:
LOT 8 TO ACCESS FROM
WOODSTOCK DRIVE

NOTE C:
15' WIDE UTILITY EASEMENT

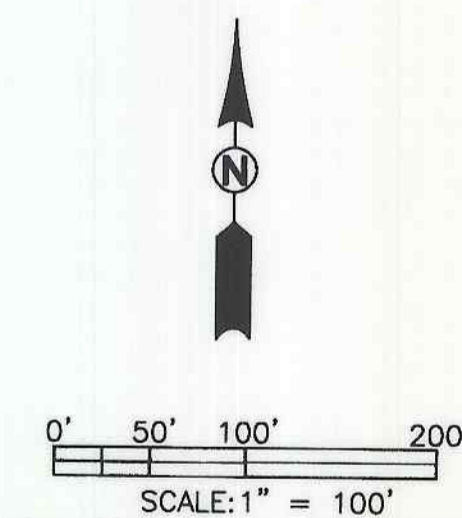

<p>REGISTERED PROFESSIONAL LAND SURVEYOR</p> <p><i>Jerry Lee Estabrook</i></p> <p>OREGON JUNE 30, 1995 JERRY LEE ESTABROOK 2703</p> <p>EXPIRES: 12/31/2005</p>	<p>OLIVE HEIGHTS SUBDIVISION LYING IN THE SE 1/4 OF SECTION 2, TOWNSHIP 27, SOUTH, RANGE 6 WEST, WILLAMETTE MERIDIAN, DOUGLAS COUNTY, OREGON</p>	
	<p>SURVEYED FOR: OLIVE HEIGHTS, INC. 164 CLYDE WILLIAM LN. ROSEBURG, OREGON 97470</p>	<p>SURVEYED BY: i.e. ENGINEERING 741 SE Jackson Street Roseburg, Oregon 97470 PHONE (541) 673-0166 FAX (541) 440-9392 iemail@ieengineering.com</p>
<p>SCALE: AS SHOWN</p>	<p>DATE: FEB., 2003</p>	<p>DWG. BY: MLJ JOB NO: 1918-01 PAGE: 3 OF 4</p>