COUNTY SURVEYORS FILE DATA
DO NOT REMOVE FROM OFFICE

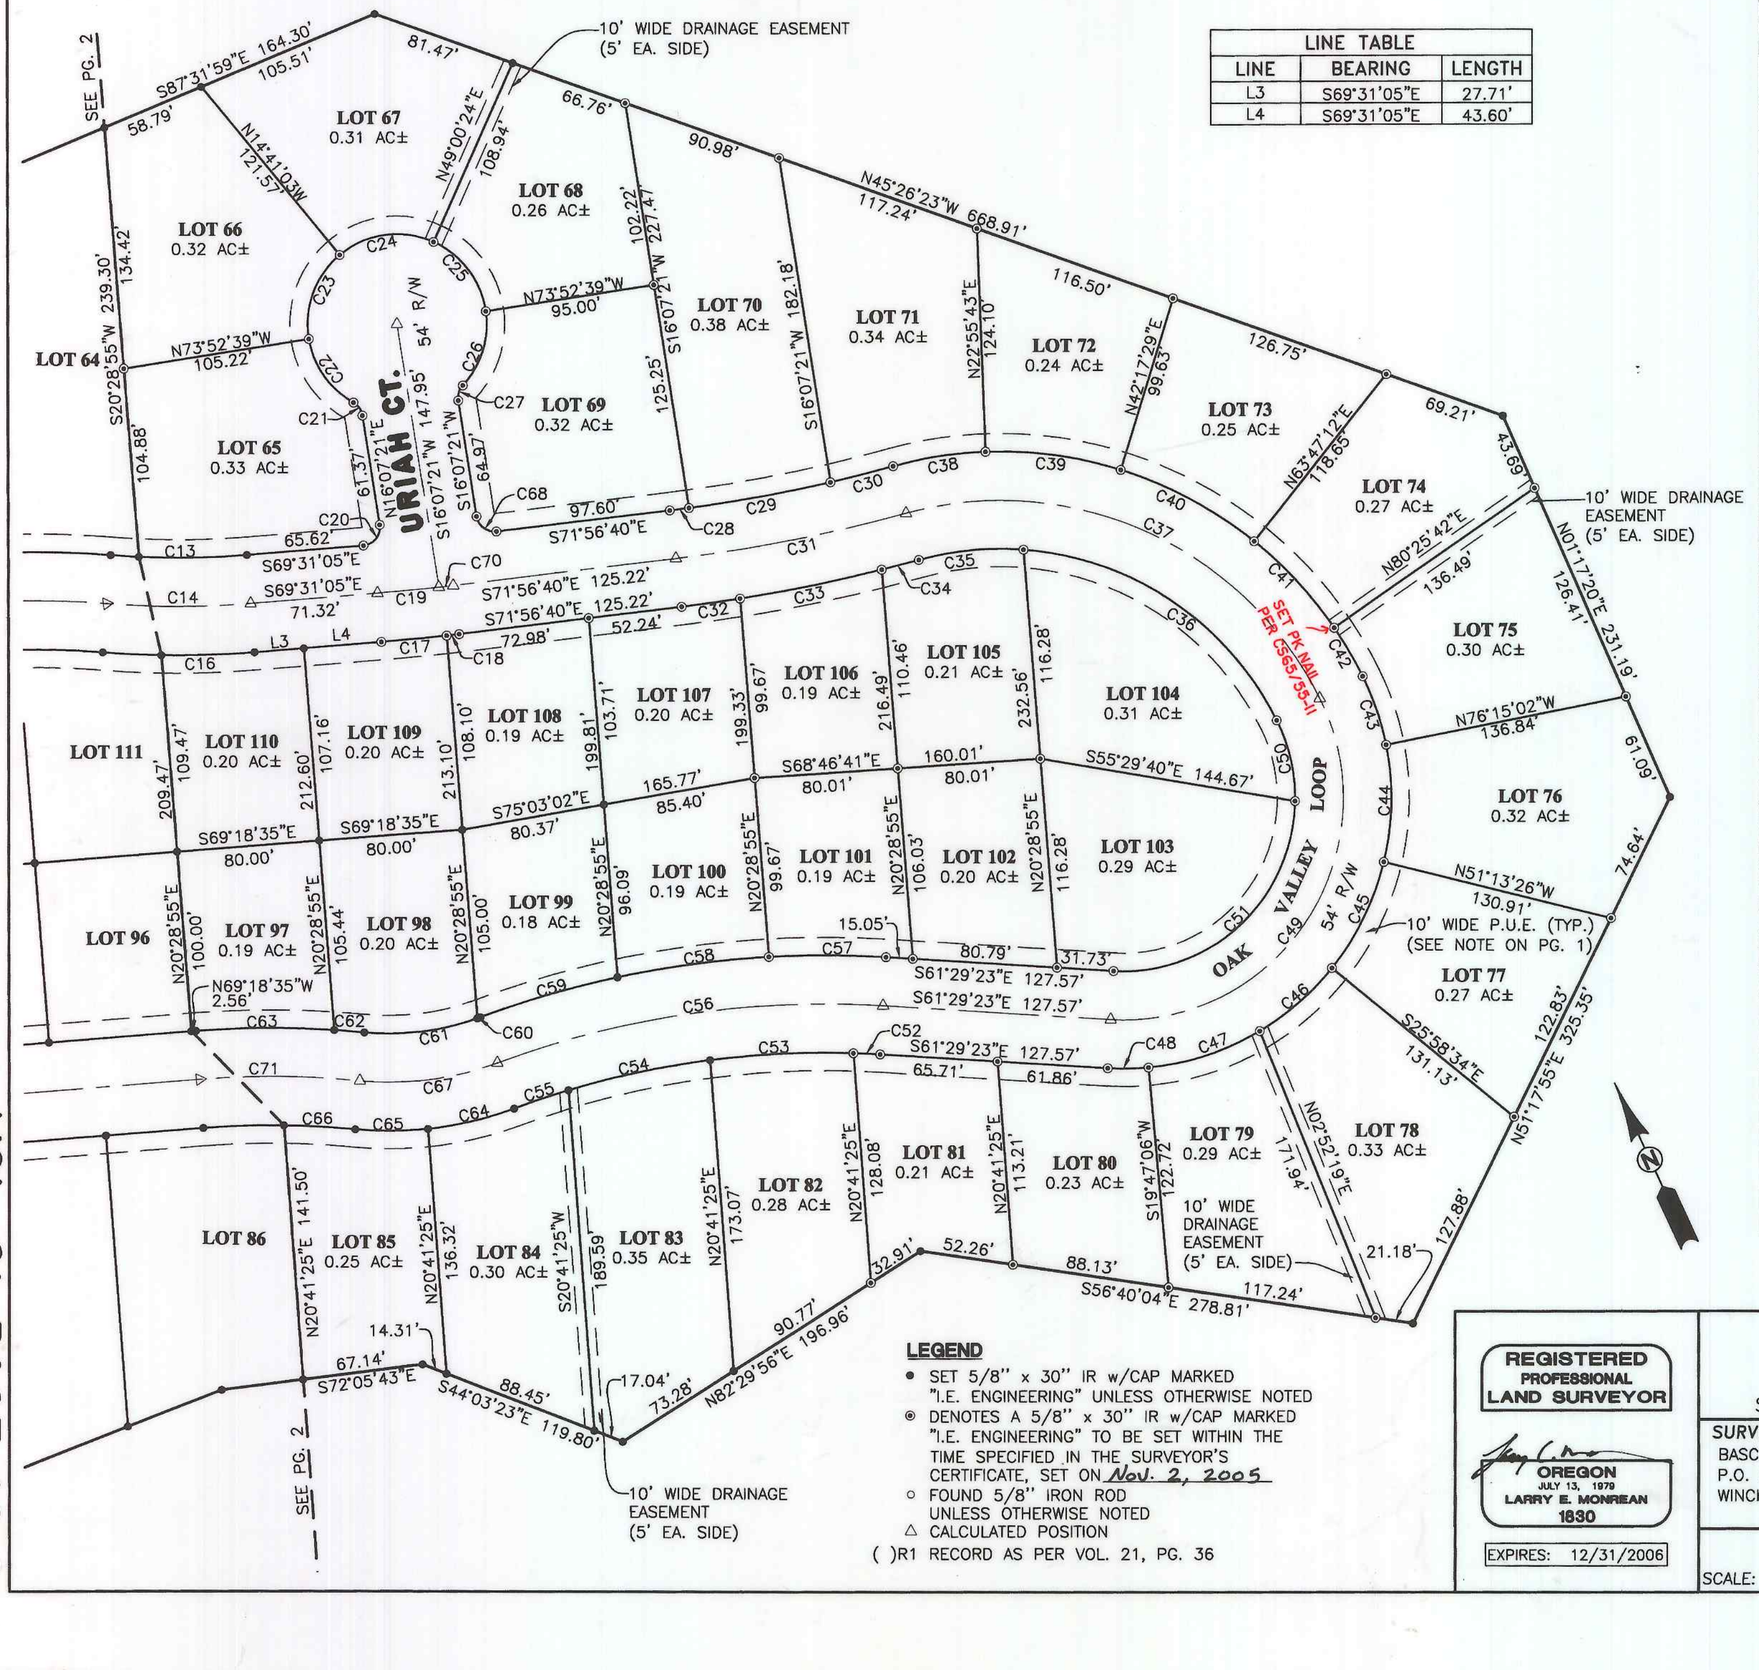

LINE TABLE		
LINE	BEARING	LENGTH
L3	S69°31'05"E	27.71'
L4	S69°31'05"E	43.60'

CURVE TABLE				
CURVE	CHORD BEARING	CHORD LENGTH	RADIUS	CURVE LENGTH
C13	S65°50'44"E	60.59'	473.00'	60.64'
C14	S64°52'58"E	80.81'	500.00'	80.90'
C16	S66°40'16"E	52.35'	527.00'	52.37'
C17	S70°32'01"E	36.40'	1027.00'	36.40'
C18	S71°44'49"E	7.09'	1027.00'	7.09'
C19	N70°29'52"W	34.19'	1000.00'	34.19'
C20	N63°18'08"E	14.67'	10.00'	16.47'
C21	N09°50'28"W	8.76'	10.00'	9.06'
C22	N10°09'01"W	43.29'	50.00'	44.78'
C23	N45°24'36"E	49.86'	50.00'	52.20'
C24	S72°50'19"E	52.76'	50.00'	55.58'
C25	S12°07'35"E	48.28'	50.00'	50.38'
C26	S42°23'42"W	43.29'	50.00'	44.78'
C27	S42°05'09"W	8.76'	10.00'	9.06'
C28	S72°17'57"E	10.79'	871.63'	10.79'
C29	S75°17'06"E	80.02'	871.63'	80.05'
C30	S79°06'27"E	36.24'	871.63'	36.25'
C31	S76°07'18"E	130.91'	898.63'	131.03'
C32	S72°57'43"E	32.87'	925.63'	32.87'
C33	S76°28'27"E	80.59'	925.63'	80.62'
C34	S79°38'03"E	21.48'	925.63'	21.48'
C35	N70°30'12"W	58.87'	173.00'	59.15'
C36	N31°11'13"W	170.49'	173.00'	178.27'
C37	N40°58'56"W	253.44'	200.00'	274.48'
C38	N73°41'06"W	52.29'	227.00'	52.41'
C39	S57°23'24"E	76.35'	227.00'	76.71'
C40	N36°57'39"W	84.66'	227.00'	85.16'
C41	S17°53'33"E	65.70'	227.00'	65.93'
C42	S05°37'07"E	31.30'	227.00'	31.32'
C43	S06°02'30"W	40.24'	150.00'	40.36'
C44	S26°15'46"W	65.00'	150.00'	65.52'
C45	S51°24'00"W	65.57'	150.00'	66.10'
C46	S74°17'08"W	53.44'	150.00'	53.73'
C47	S82°50'02"E	65.54'	150.00'	66.07'
C48	S65°51'09"E	22.82'	150.00'	22.84'
C49	N58°25'20"E	213.23'	123.00'	257.99'
C50	N12°13'10"E	46.08'	96.00'	46.53'
C51	N72°18'27"E	138.58'	96.00'	154.83'
C52	N62°21'00"W	15.01'	500.00'	15.01'
C53	N67°48'01"W	80.03'	500.00'	80.11'
C54	N77°01'15"W	80.73'	500.00'	80.82'
C55	N83°29'28"W	32.10'	500.00'	32.11'
C56	N73°24'37"W	217.71'	527.00'	219.29'
C57	N64°52'09"W	65.31'	554.00'	65.35'
C58	N72°39'18"W	85.13'	554.00'	85.21'
C59	N81°11'46"W	79.89'	554.00'	79.96'
C60	S84°58'16"E	1.83'	146.00'	1.83'
C61	S72°04'12"E	63.41'	146.00'	63.92'
C62	N60°24'02"W	16.87'	554.00'	16.87'
C63	N65°17'29"W	77.65'	554.00'	77.71'
C64	S78°13'33"E	49.47'	200.00'	49.60'
C65	N65°19'28"W	40.40'	200.00'	40.47'
C66	N61°49'23"W	40.04'	500.00'	40.05'
C67	S72°25'46"E	77.25'	173.00'	77.91'
C68	S27°54'40"E	13.90'	10.00'	15.37'
C70	N71°42'39"W	8.16'	1000.00'	8.16'
C71	S64°25'08"E	89.61'	489.50'	89.99'

LEGEND

- ● SET 5/8" x 30" IR w/CAP MARKED "I.E. ENGINEERING" UNLESS OTHERWISE NOTED
- ◉ DENOTES A 5/8" x 30" IR w/CAP MARKED "I.E. ENGINEERING" TO BE SET WITHIN THE TIME SPECIFIED IN THE SURVEYOR'S CERTIFICATE, SET ON Nov. 2, 2005
- ○ FOUND 5/8" IRON ROD UNLESS OTHERWISE NOTED
- △ CALCULATED POSITION
- ( )R1 RECORD AS PER VOL. 21, PG. 36

REGISTERED PROFESSIONAL LAND SURVEYOR

OREGON JULY 13, 1979 LARRY E. MONREAN 1830

EXPIRES: 12/31/2006

TAFT SUBDIVISION, PHASE 3

LYING IN THE NW 1/4 SEC. 31 AND SW 1/4 SEC. 30, T26S, R5W, W.M., DOUGLAS COUNTY, OREGON

SURVEYED FOR:
BASCO BROS., L.L.C.
P.O. BOX 131
WINCHESTER, OR 97495

SURVEYED BY:
i.e. ENGINEERING
741 SE Jackson Street
Roseburg, Oregon 97470
PHONE (541) 673-0166
FAX (541) 440-9392
iemail@ieengineering.com

SCALE: AS SHOWN | DATE: JAN., 2005 | DWG. BY:JAC | JOB NO:1733-06T2 | PAGE: 3 OF 3

VOL. 21 PAGE 48 C