COUNTY SURVEYORS FILE DATA
DO NOT REMOVE FROM OFFICE

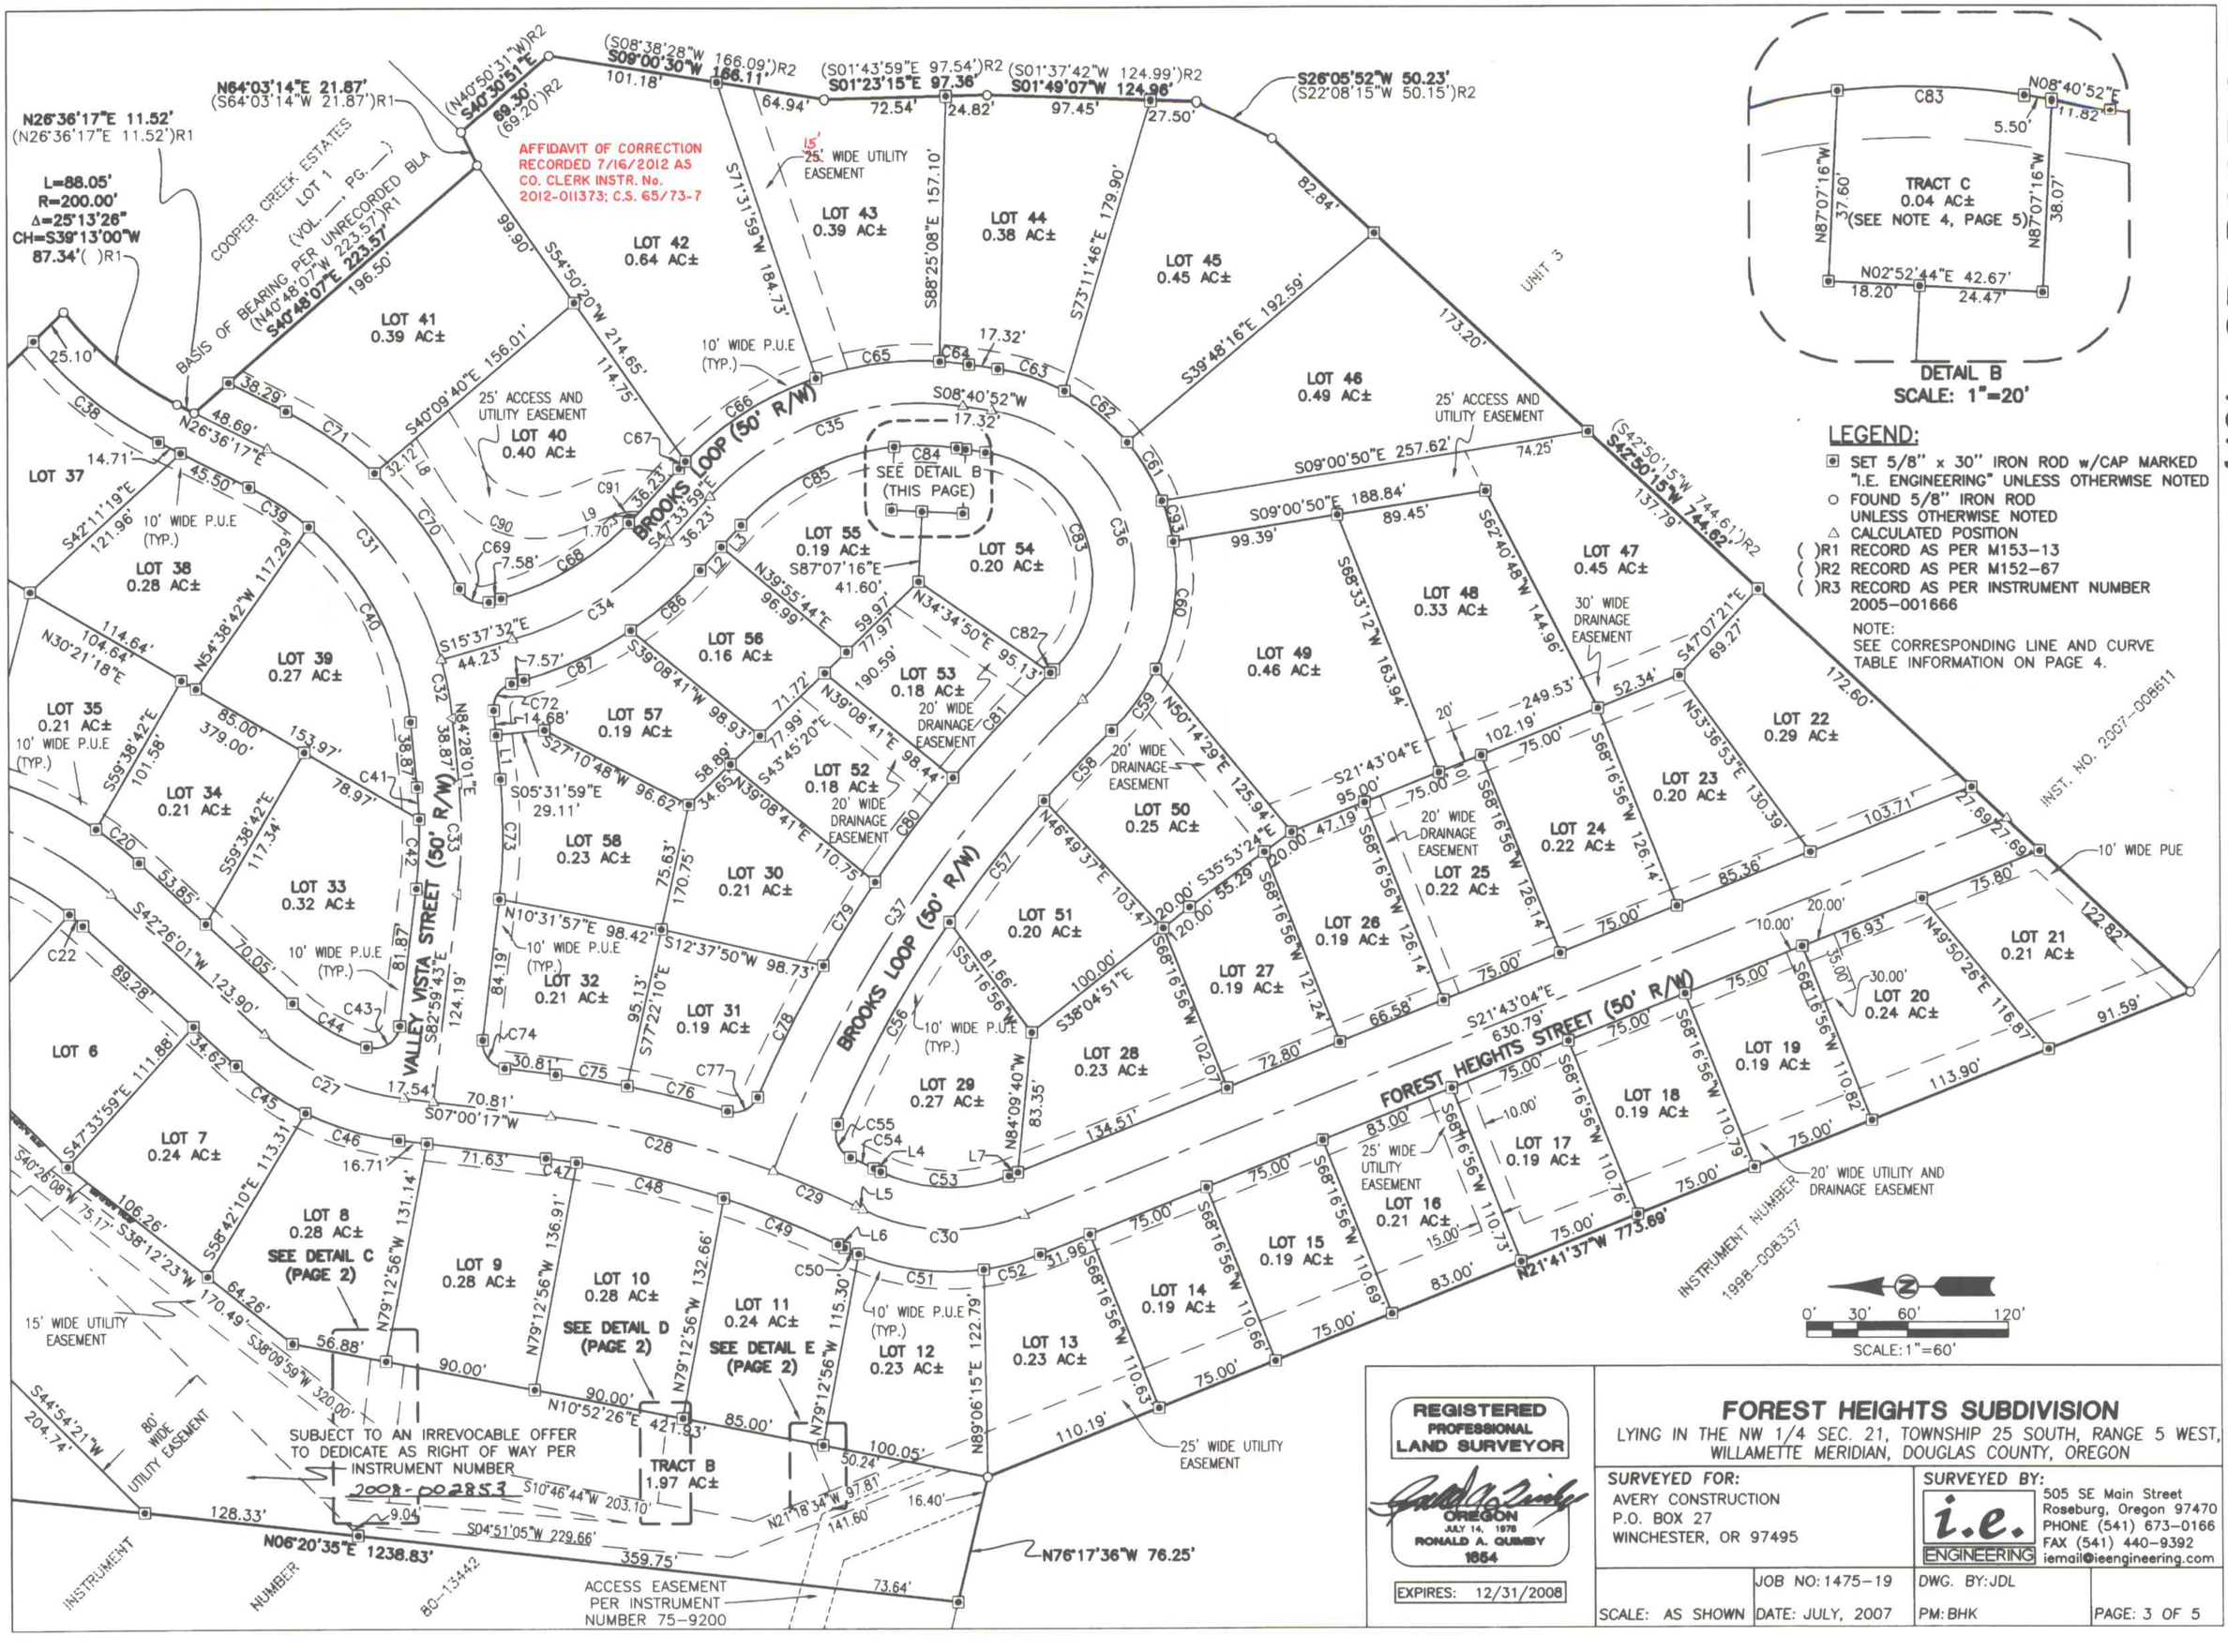

DETAIL B
SCALE: 1"=20'

LEGEND:

- ⊡ SET 5/8" x 30" IRON ROD w/CAP MARKED "I.E. ENGINEERING" UNLESS OTHERWISE NOTED
- ○ FOUND 5/8" IRON ROD UNLESS OTHERWISE NOTED
- △ CALCULATED POSITION
- ( )R1 RECORD AS PER M153-13
- ( )R2 RECORD AS PER M152-67
- ( )R3 RECORD AS PER INSTRUMENT NUMBER 2005-001666

NOTE:
SEE CORRESPONDING LINE AND CURVE TABLE INFORMATION ON PAGE 4.

REGISTERED PROFESSIONAL LAND SURVEYOR
OREGON JULY 14, 1978 RONALD A. QUIMBY 1864
EXPIRES: 12/31/2008

FOREST HEIGHTS SUBDIVISION

LYING IN THE NW 1/4 SEC. 21, TOWNSHIP 25 SOUTH, RANGE 5 WEST, WILLAMETTE MERIDIAN, DOUGLAS COUNTY, OREGON

SURVEYED FOR:
AVERY CONSTRUCTION
P.O. BOX 27
WINCHESTER, OR 97495

SURVEYED BY:
i.e. ENGINEERING
505 SE Main Street
Roseburg, Oregon 97470
PHONE (541) 673-0166
FAX (541) 440-9392
iemail@ieengineering.com

SCALE: AS SHOWN	JOB NO: 1475-19	DWG. BY: JDL	
	DATE: JULY, 2007	PM: BHK	PAGE: 3 OF 5

VOL. 23 PAGE 9 C