S-18 L

T. 31 S. R. 5 W. W.M.

Survey To Mark lines + Temporary corners

for

Bureau of Land Management. Roseburg, Oregon.

Scale 8" = 1 Mile July 1973

FILED
SEP 14 1990
COUNTY SURVEYOR
DOUGLAS COUNTY, ORE.

REGISTERED OREGON LAND SURVEYOR
Wilford N. Haines
MARTIN DEAD
WILFORD N. HAINES

◎ Monuments Found

• Set 5/8" Steel Rods for Temporary monuments

1 B.L.M. Sign S8 bears N.54°E. 10.5 ft on 14" D. Fir

2 BLM sign S8 bears East 6.0 ft on 24" D. Fir

3 B.L.M. sign S8 bears N.67°E 11.2 ft on 8" inc. Cedar

4 B.L.M. sign S8 bears N. 86°30' E. 225.0 ft. on 11" D. Fir

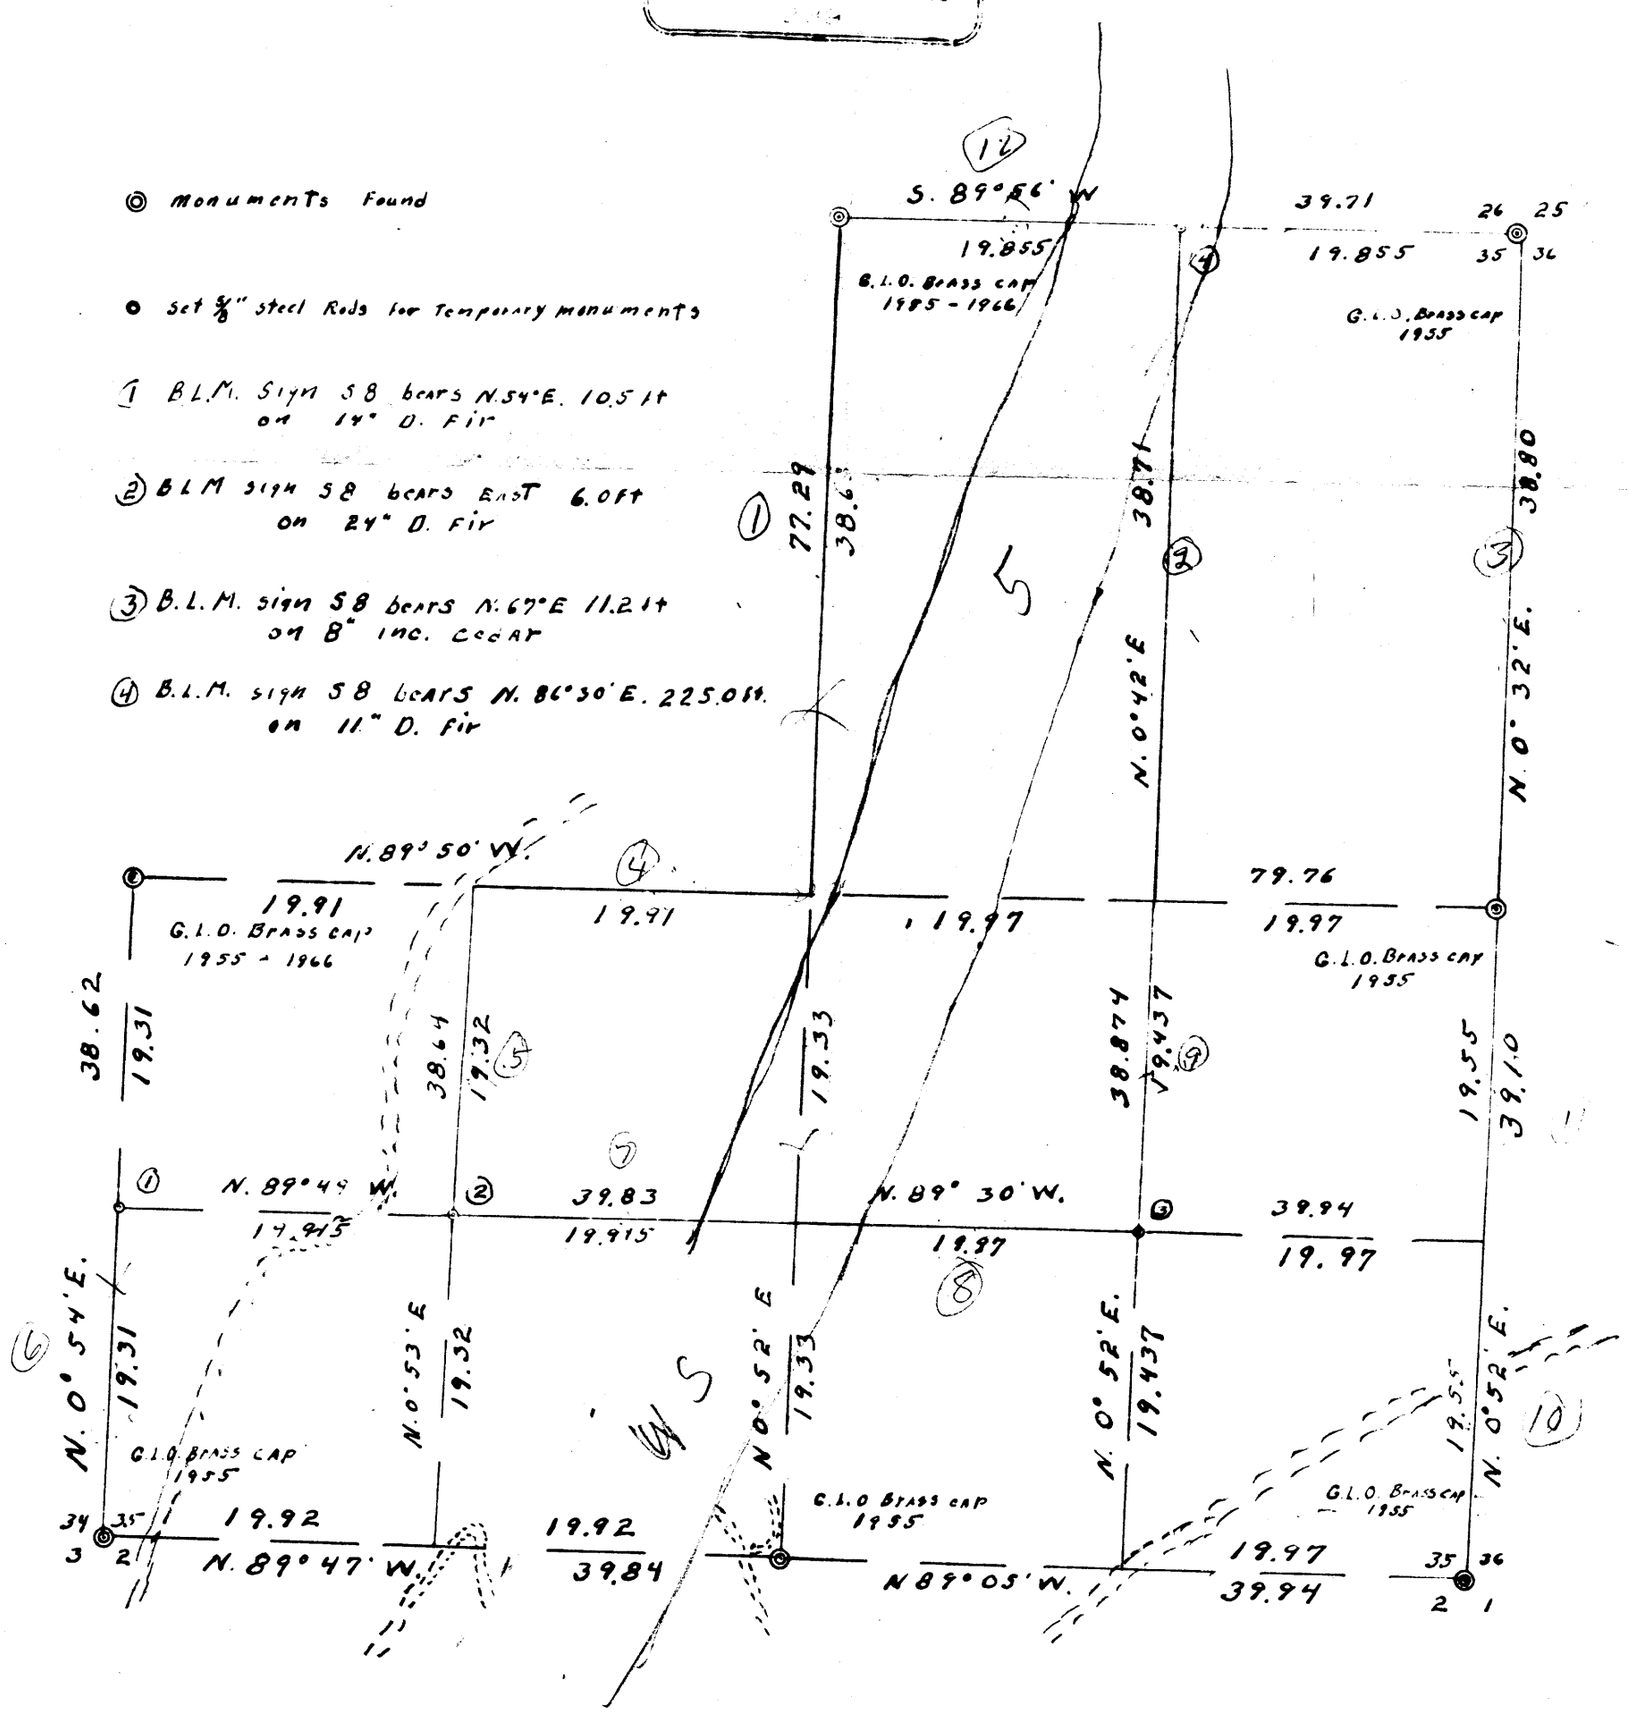

1	38.63
2	38.71
3	38.80
4	19.91
5	19.32
6	19.31
7	19.57
8	19.87
9	19.44
10	19.55
11	19.55
12	19.55
	292.77

H. EN. 12

3.65

FILED
SEP 14 1990
COUNTY SURVEYOR
DOUGLAS COUNTY, ORE.

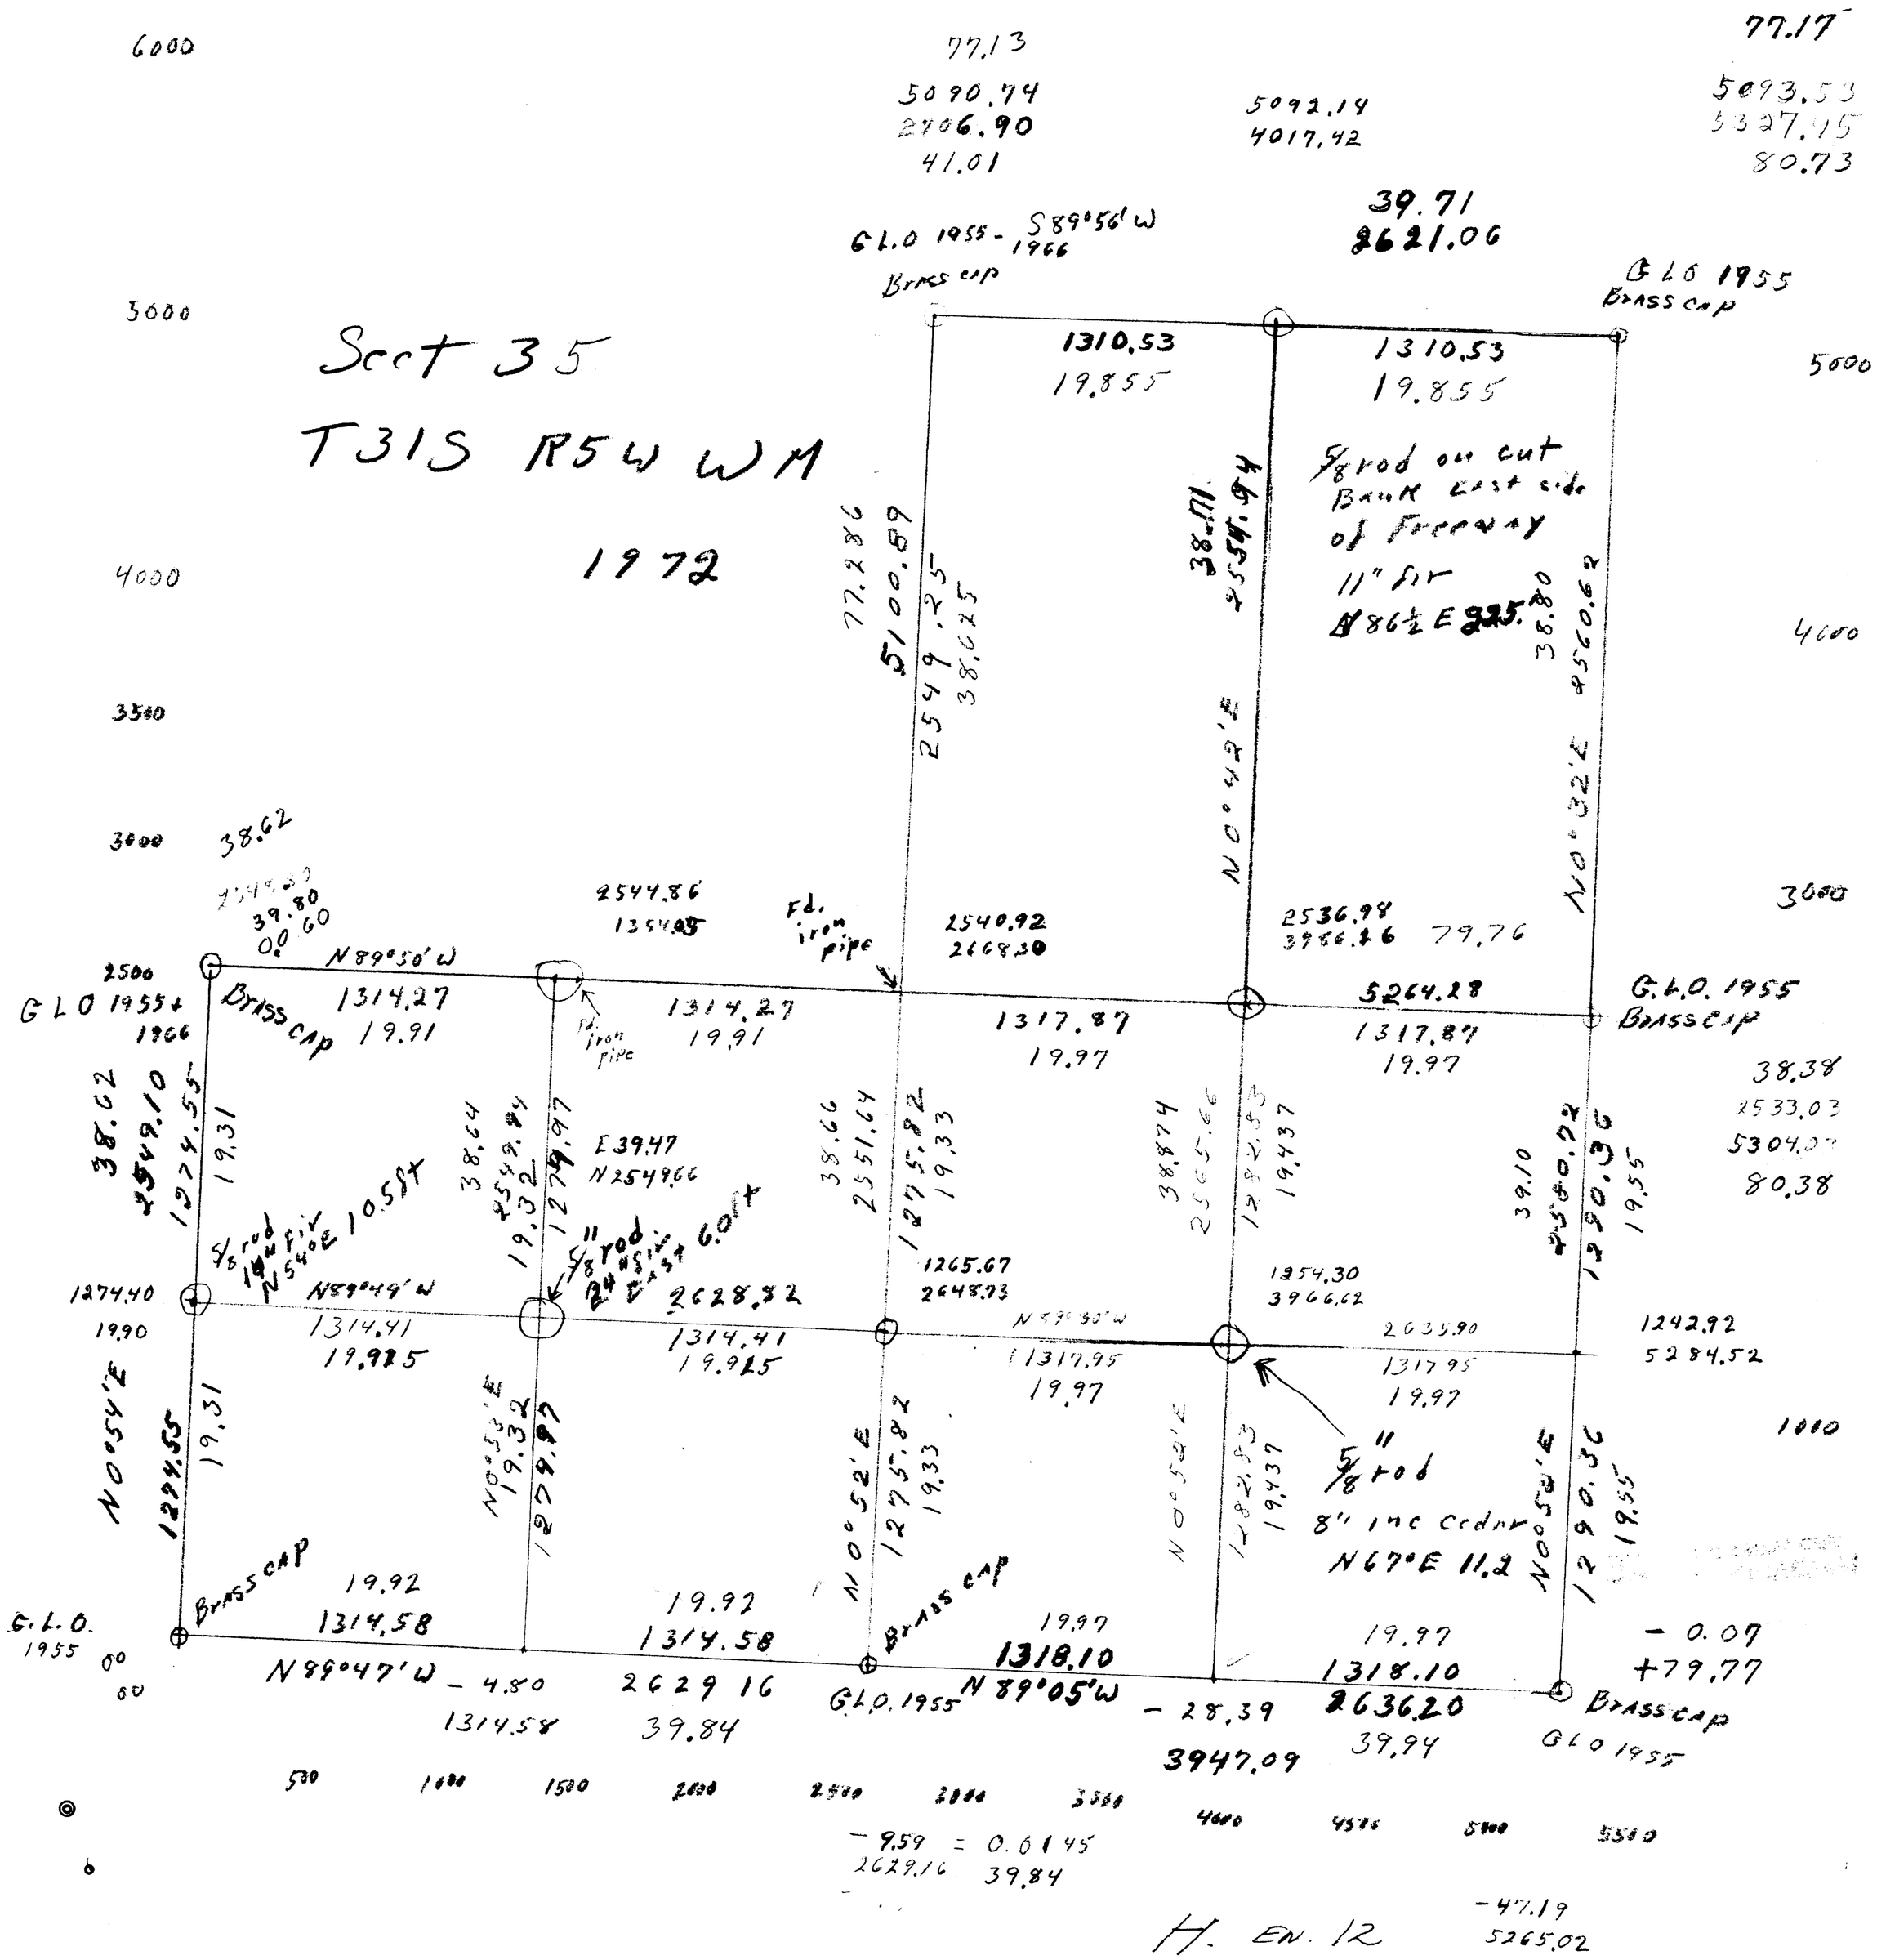

H. EN. 12