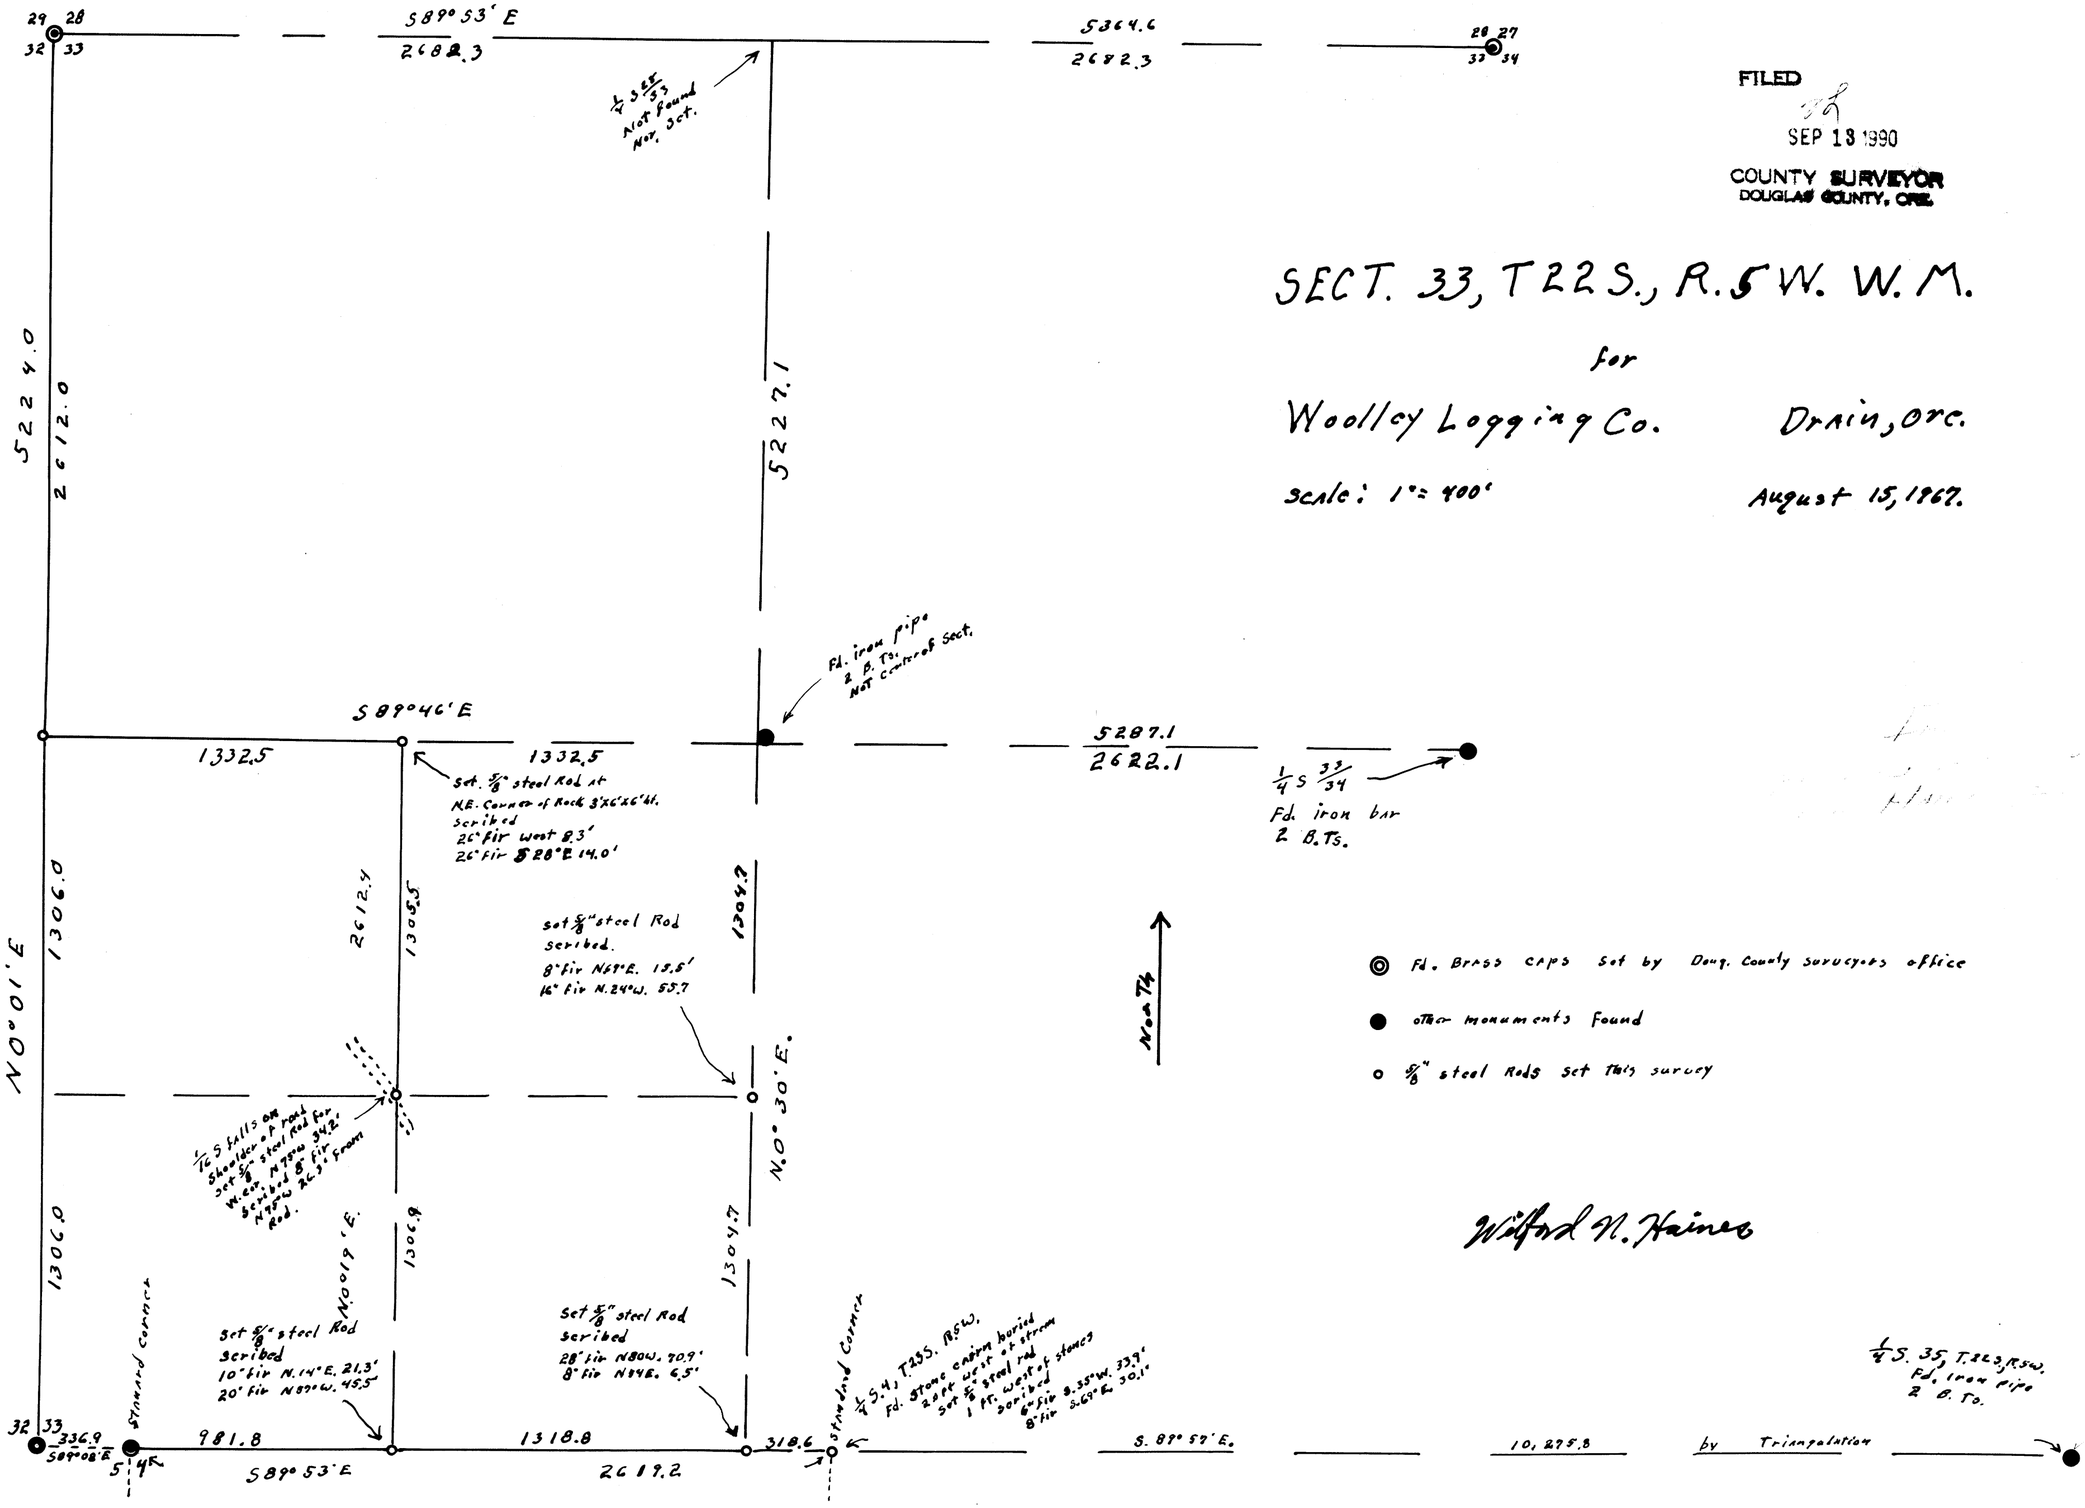

FILED
SEP 13 1990
COUNTY SURVEYOR
DOUGLAS COUNTY, ORE.

SECT. 33, T22S., R.5W. W.M.

for

Woolley Logging Co. Drain, Ore.

Scale: 1" = 400' August 15, 1967.

Wilford N. Haines

H EN. 3

F.B. 14-110

H EN. 3