COUNTY SURVEYORS FILE DATA
DO NOT REMOVE FROM OFFICE

C.S. 47/42
MAP FILE M1-1

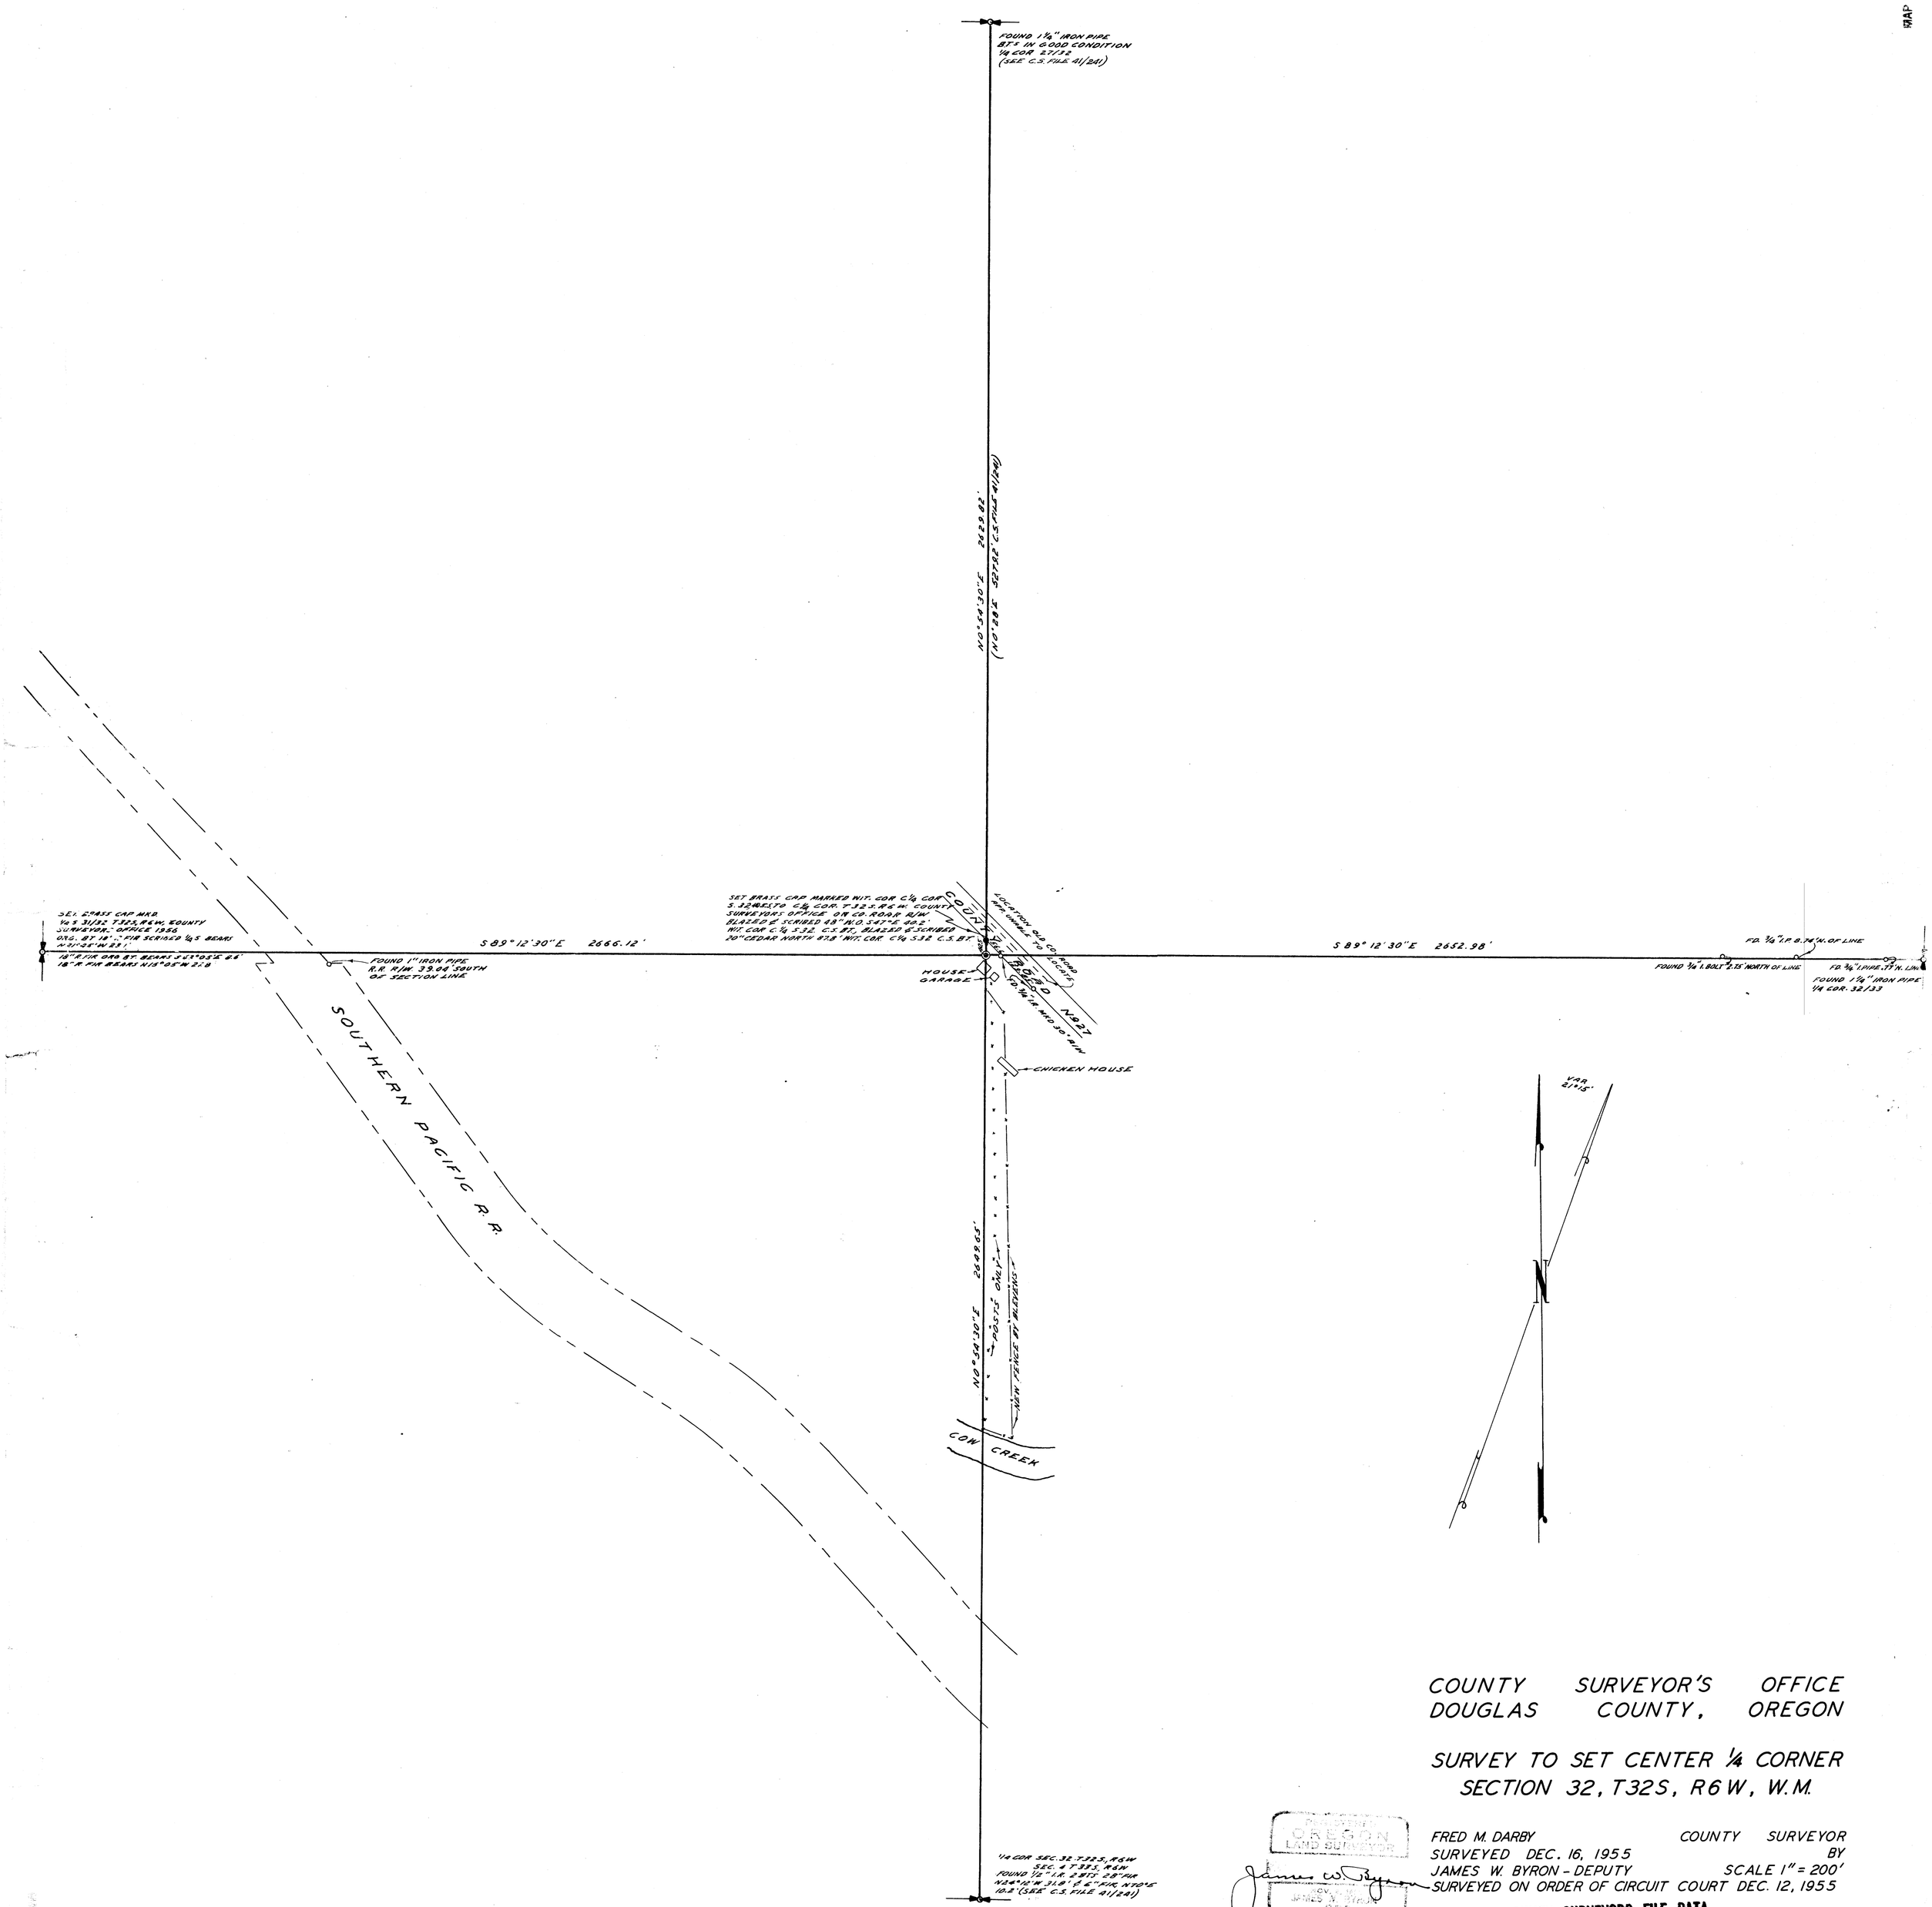

COUNTY SURVEYOR'S OFFICE
DOUGLAS COUNTY, OREGON

SURVEY TO SET CENTER 1/4 CORNER
SECTION 32, T32S, R6W, W.M.

FRED M. DARBY COUNTY SURVEYOR
SURVEYED DEC. 16, 1955 BY
JAMES W. BYRON - DEPUTY SCALE 1" = 200'
SURVEYED ON ORDER OF CIRCUIT COURT DEC. 12, 1955

REGISTERED OREGON LAND SURVEYOR
James W. Byron
JAMES W. BYRON
303

COUNTY SURVEYORS FILE DATA
DO NOT REMOVE FROM OFFICE

C.S. 47/42
M1-1

C.S. File No. 47/42 M1-1