COUNTY SURVEYOR'S OFFICE
DOUGLAS COUNTY, OREGON

SURVEY FOR DEED DESCRIPTION
SECTION 3, T22S., R12W., W.M.

FRED M. DARBY — COUNTY SURVEYOR
SURVEYED AUG. 9, 1956 — BY
JAMES W. BYRON - DEPUTY — SCALE 1" = 200'
SURVEYED FOR WARREN WAGGONER

James W. Byron

NOTE: THE BRASS CAP AT THE 1/4 COR. SEC. 3/34 WAS SET IN 1956, BUT NOT RECORDED UNTIL NOV. 10, 1967.
James W. Byron

SET BRASS CAP FOR 1/4 COR. SEC. 3/34 POSITION OF CORNER ESTABLISHED FROM TIE SHOWN ON AMENDED PLAT OF R.R. ADDITION & MON. AT 10TH & WINCHESTER FOR CONTROLS. BEARING OBJECTS ARE CHISLED "+" IN CONC. ON EAST ABUTMENT OF BRIDGE, BEARS S.35°16'W 191.1'; S.55°28'W 159.0'; N.W. CORNER OF TEXACO SERVICE STATION BEARS N.59°22'E 236.3'.

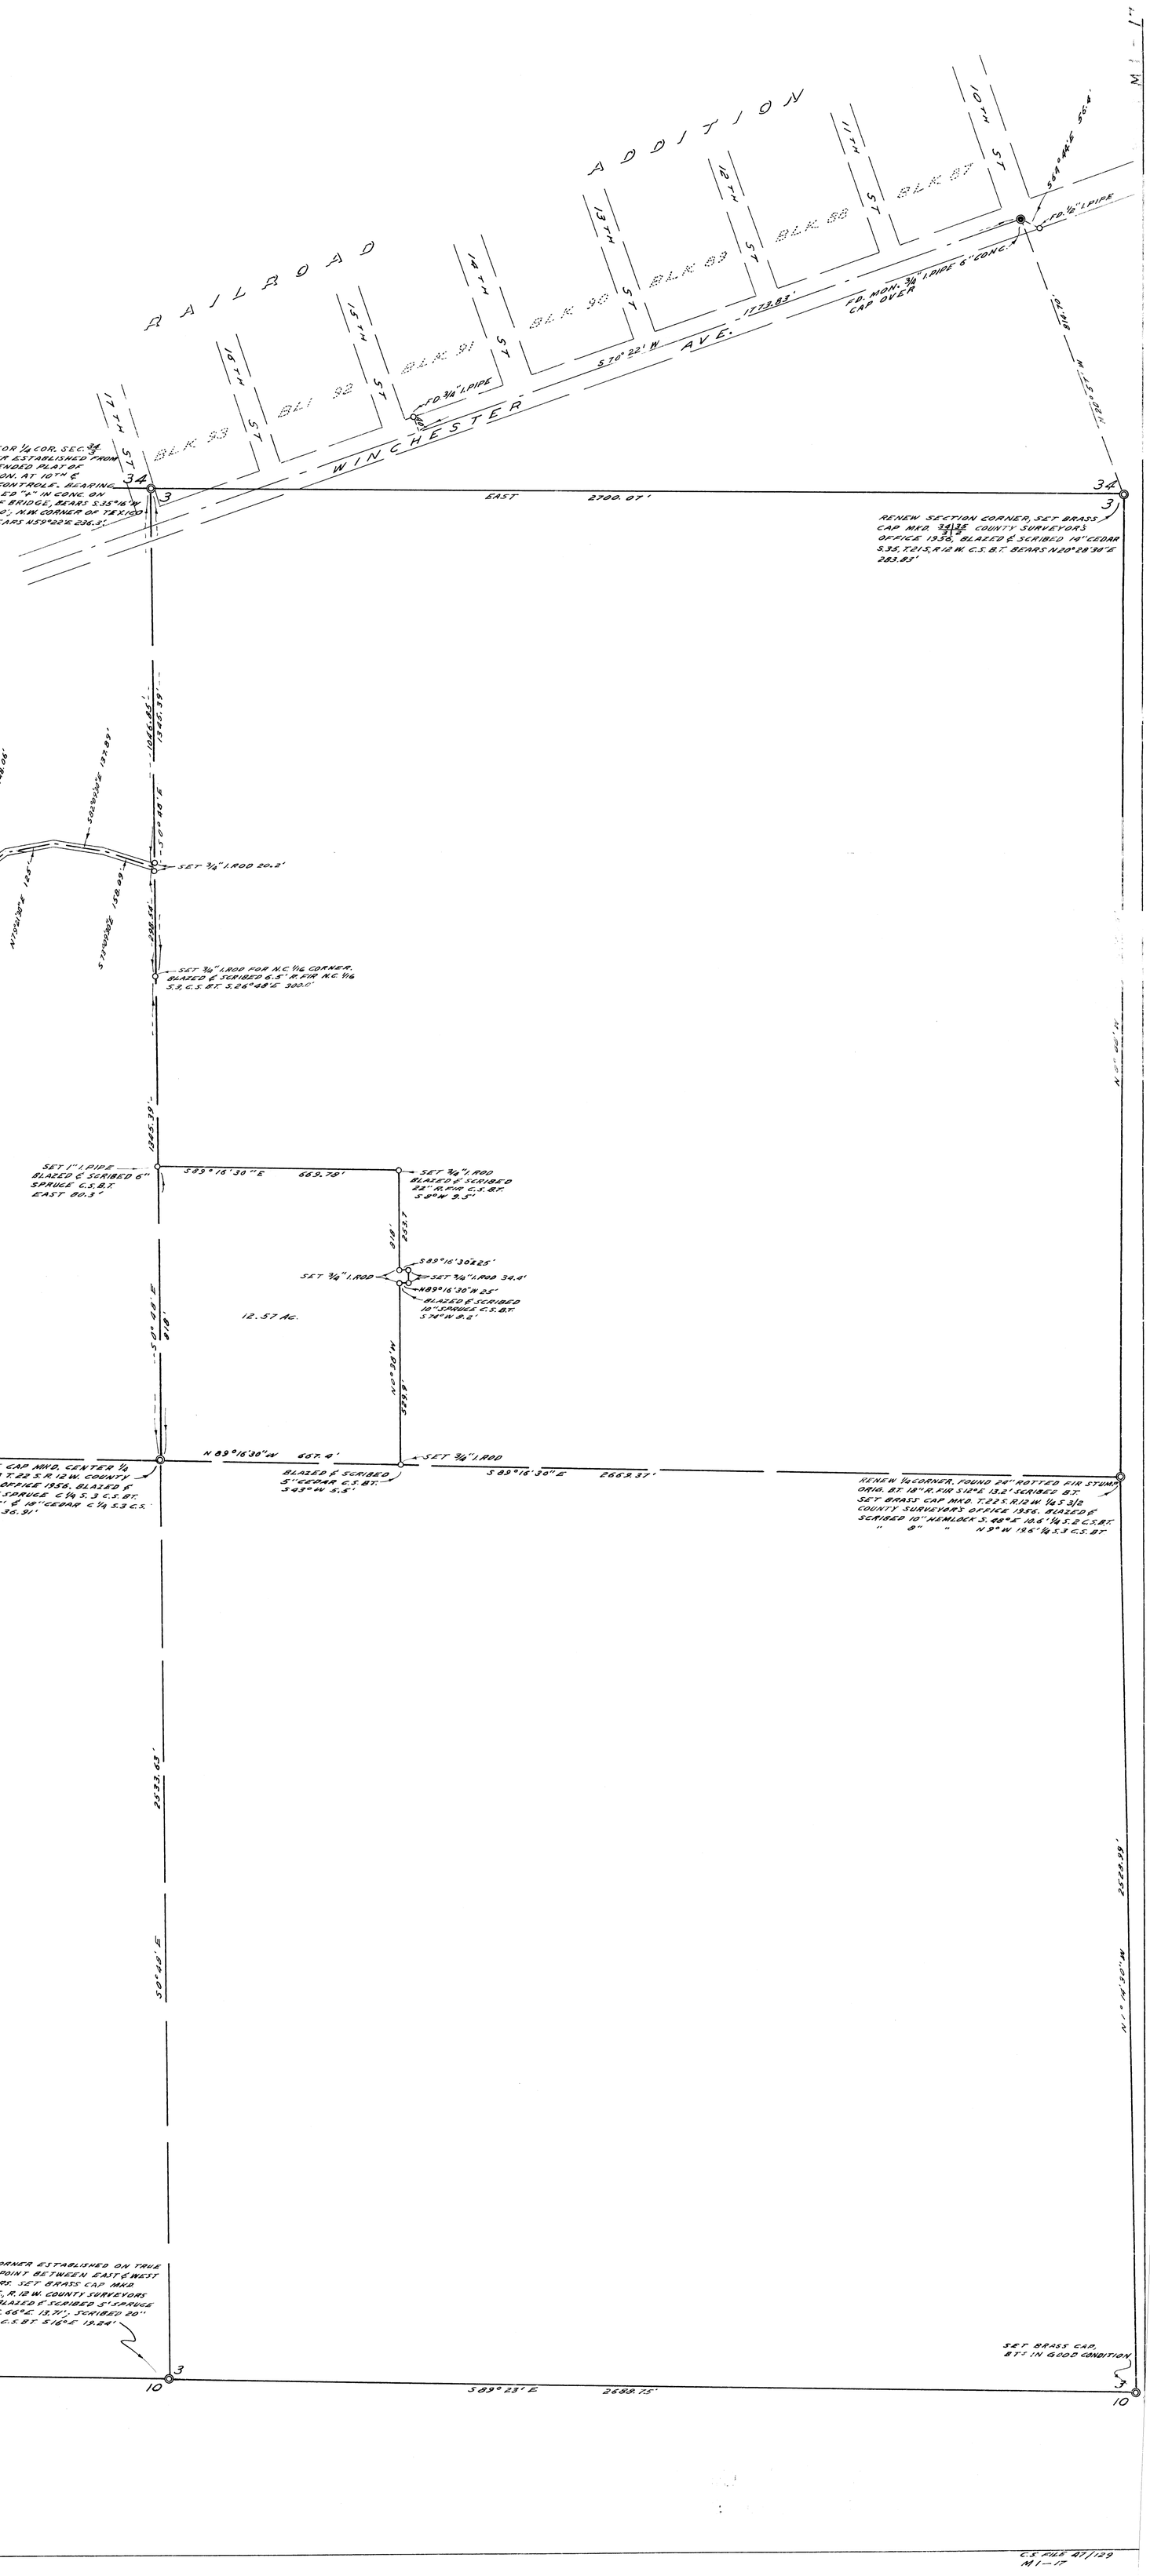

MAP FILE M1-17

C.S. FILE 47/129
M1-17