COUNTY SURVEYORS FILE DATA
DO NOT REMOVE FROM OFFICE

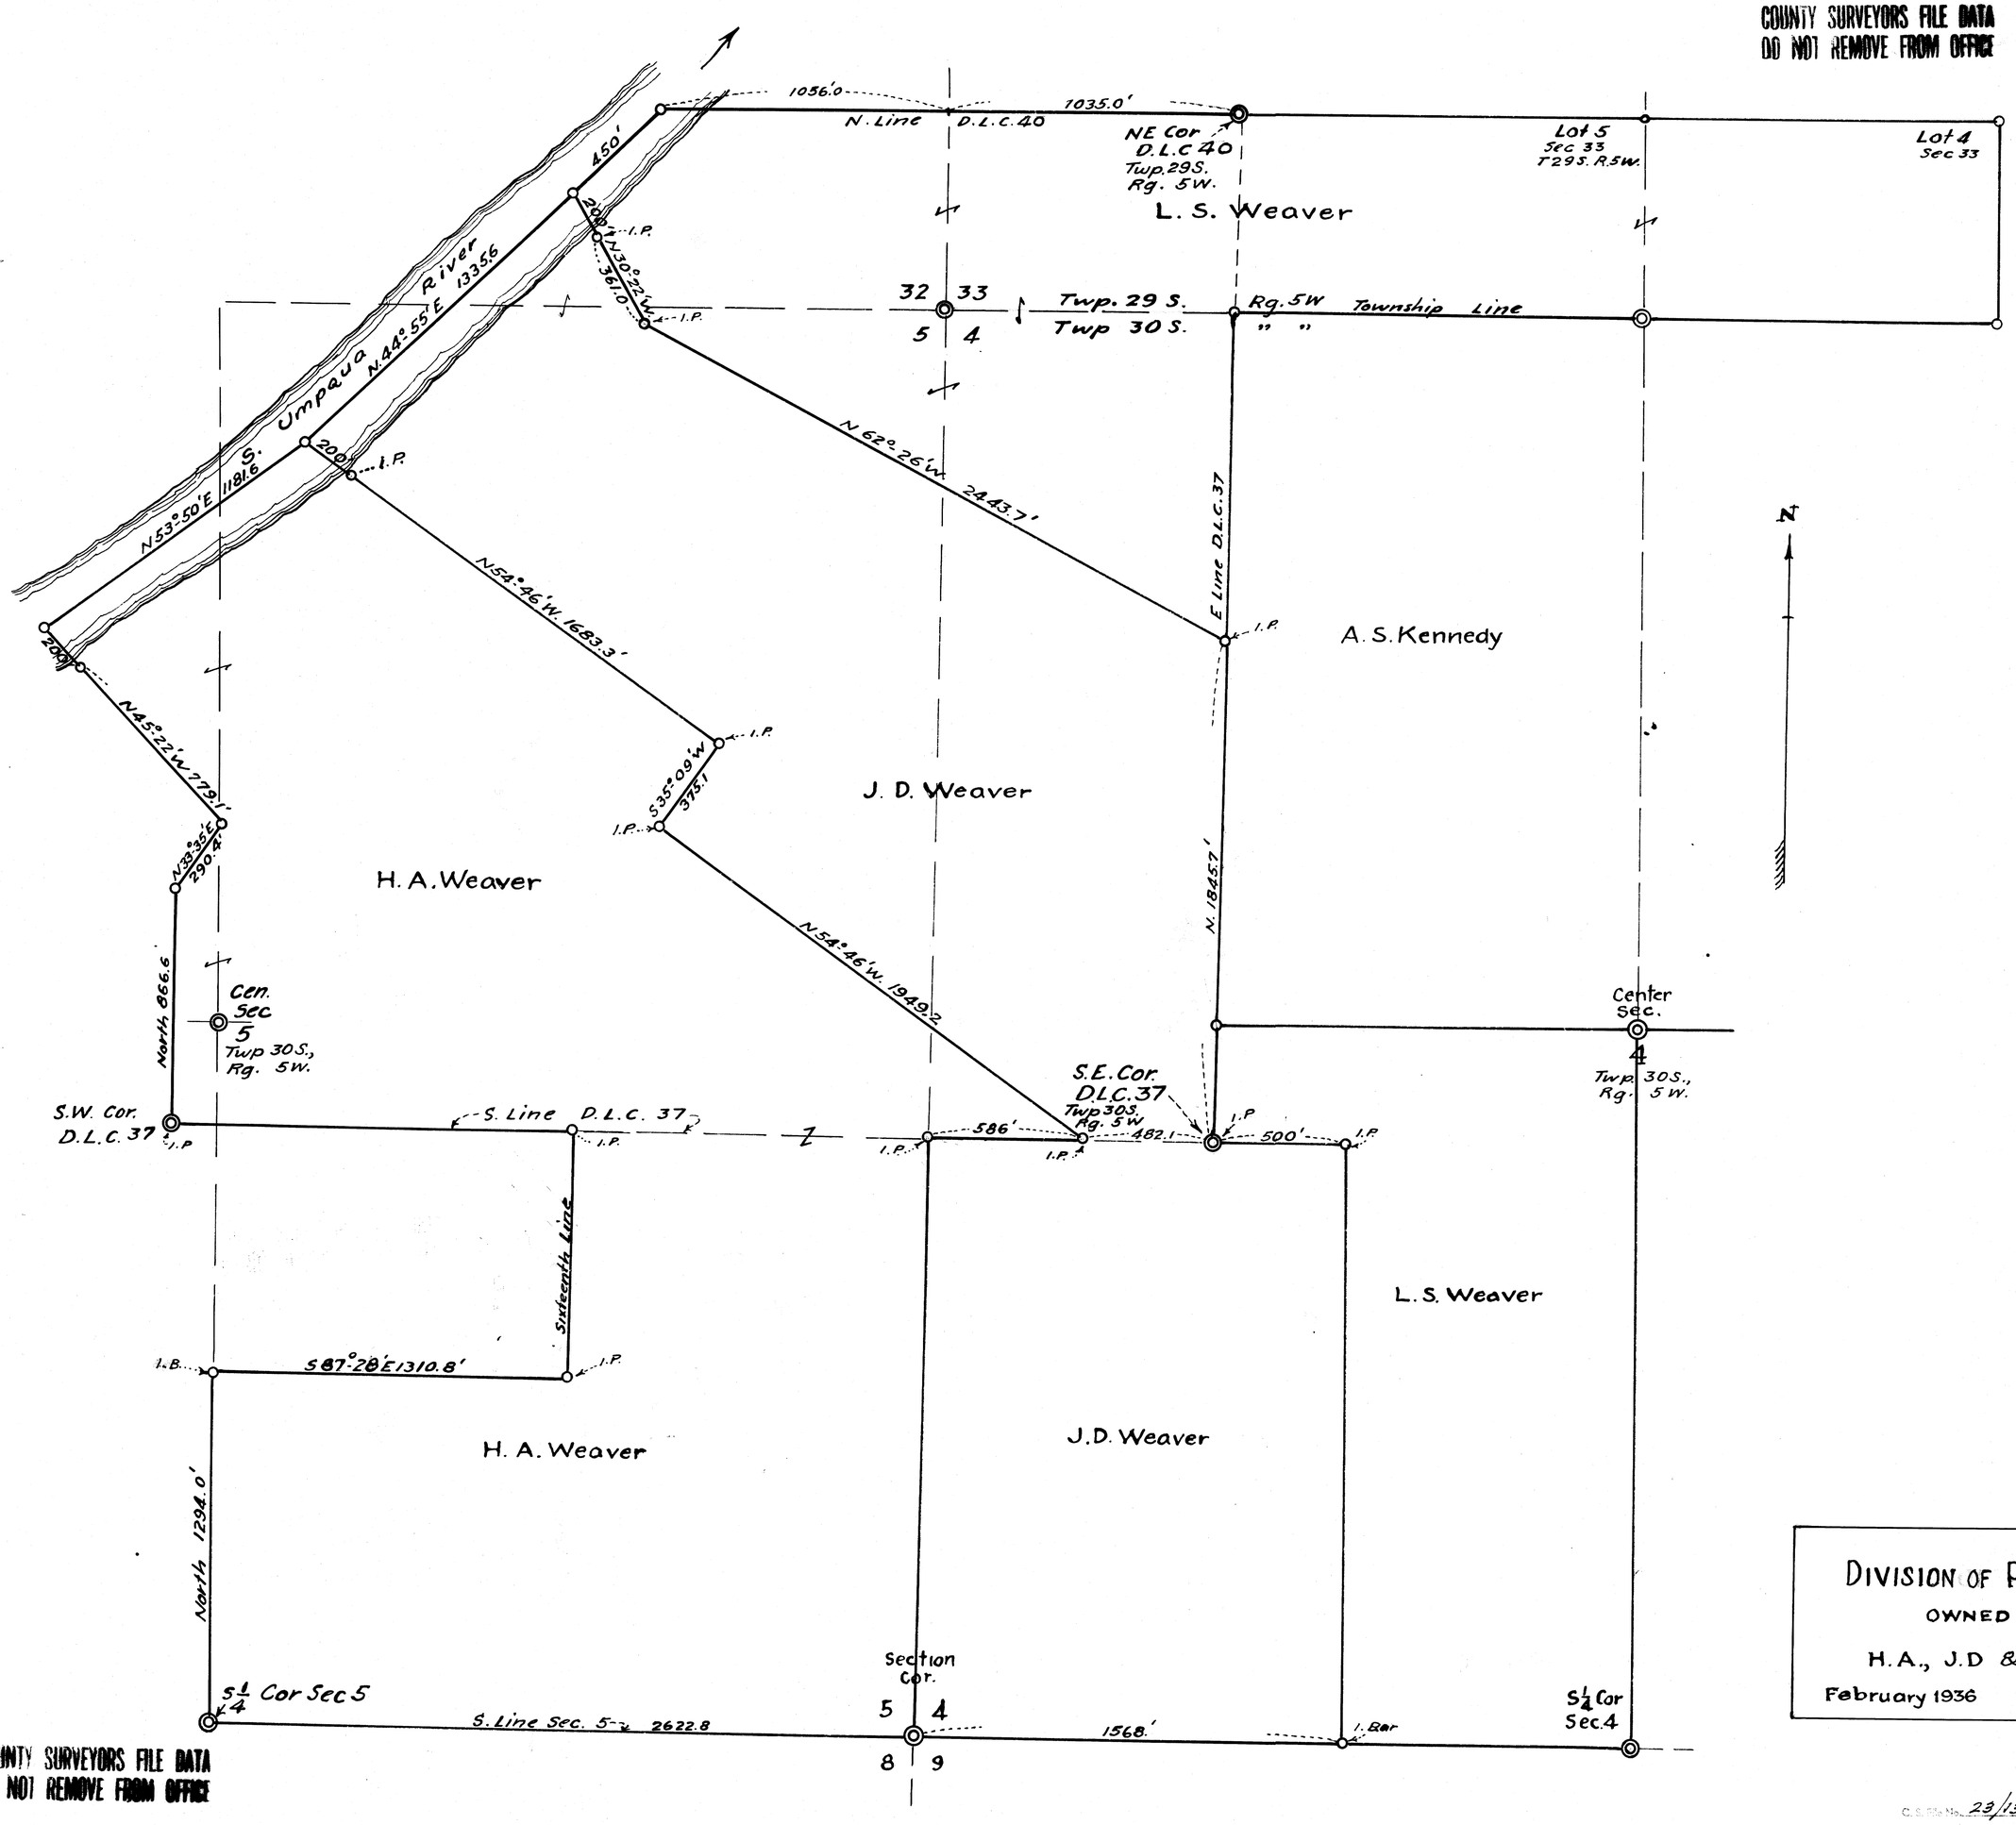

DIVISION OF PROPERTY
OWNED BY
H.A., J.D & L.S. Weaver
February 1936 Scale 1" = 300 ft.

COUNTY SURVEYORS FILE DATA
DO NOT REMOVE FROM OFFICE

C.S.F.N. 23/13
MAP FILE M1-1-36