COUNTY SURVEYORS FILE COPY
DO NOT REMOVE FROM OFFICE

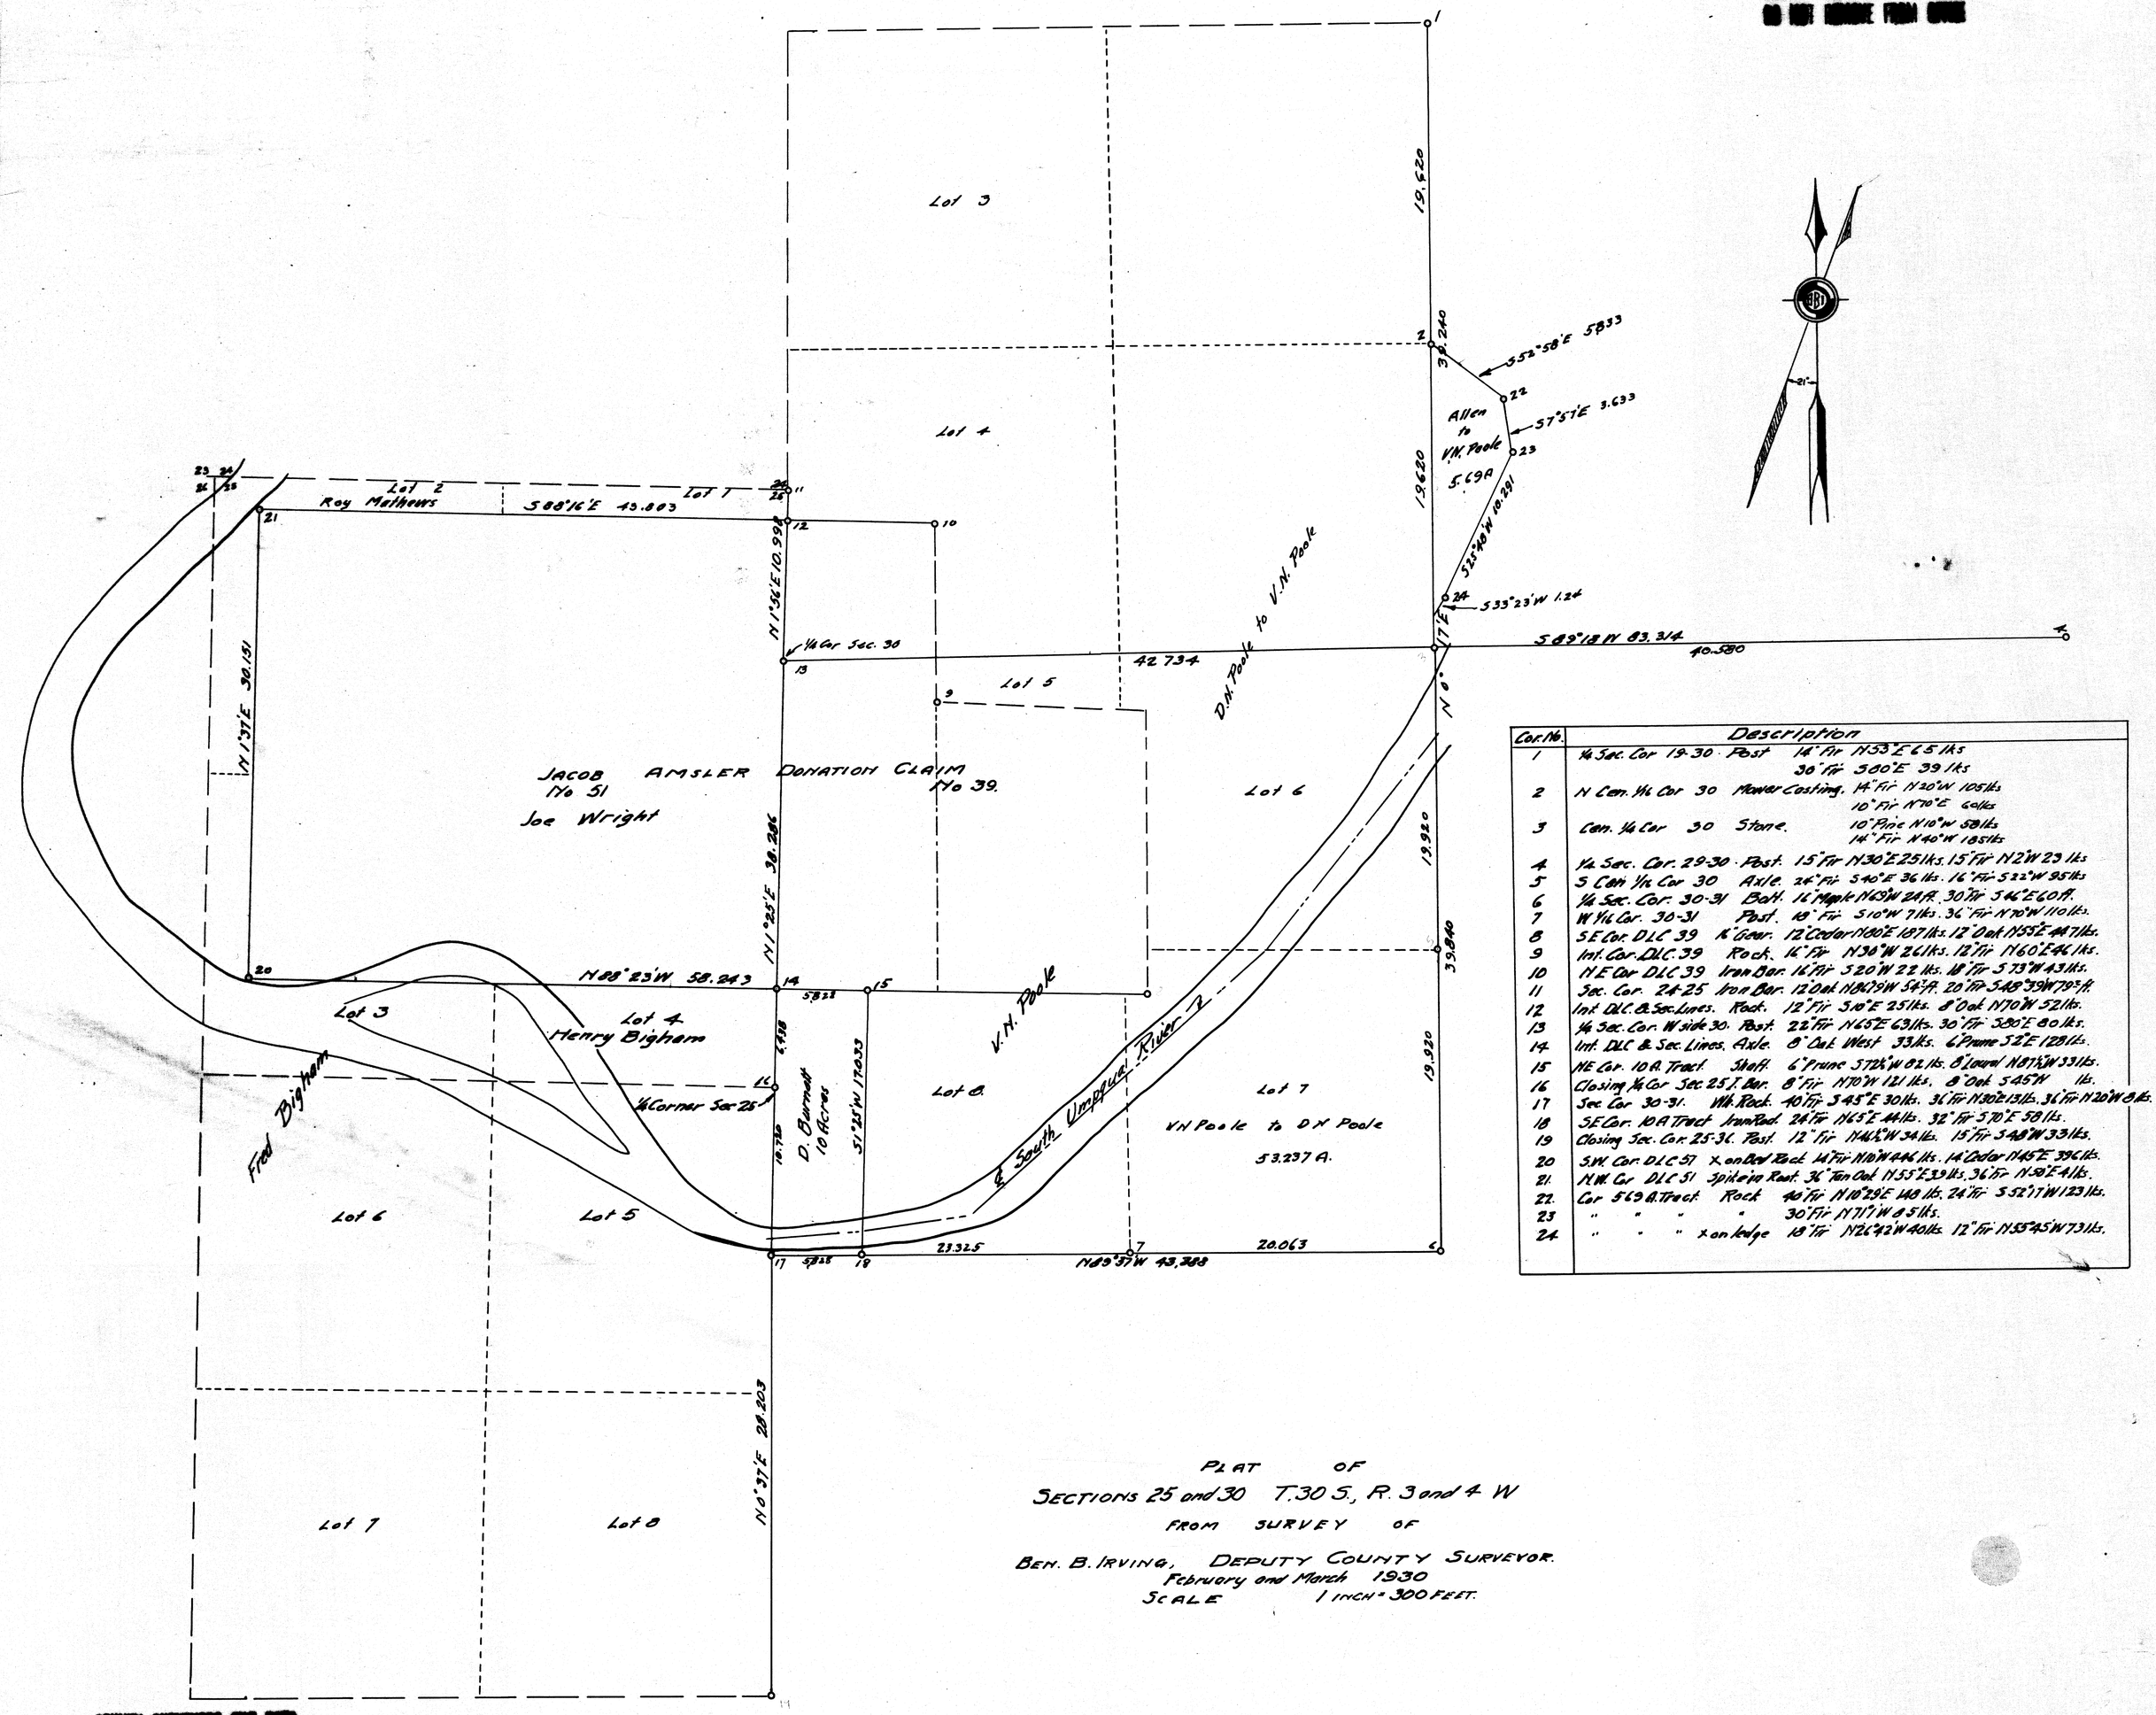

Cor. No.	Description
1	¼ Sec. Cor 19-30 Post 14" Fir N53°E 65 lks 30" Fir S80°E 39 lks
2	N Cen. ¼ Cor 30 Mower Casting. 14" Fir N20°W 105 lks 10" Fir N70°E 6 lks
3	Cen. ¼ Cor 30 Stone. 10" Pine N10°W 58 lks 14" Fir N40°W 185 lks
4	¼ Sec. Cor. 29-30 Post. 15" Fir N30°E 251 lks. 15" Fir N2°W 23 lks
5	S Cen ¼ Cor 30 Axle. 24" Fir S40°E 36 lks. 16" Fir S22°W 95 lks
6	¼ Sec. Cor. 30-31 Bolt. 16" Maple N65°W 24 ft. 30" Fir S46°E 60 ft.
7	W ¼ Cor. 30-31 Post. 18" Fir S10°W 71 lks. 36" Fir N70°W 110 lks.
8	S.E. Cor. D.L.C. 39 16" Gear. 12" Cedar N80°E 187 lks. 12" Oak N55°E 447 lks.
9	Int. Cor. D.L.C. 39 Rock. 16" Fir N30°W 261 lks. 12" Fir N60°E 46 lks.
10	N.E. Cor D.L.C. 39 Iron Bar. 16" Fir S20°W 22 lks. 18" Fir S73°W 43 lks.
11	Sec. Cor. 24-25 Iron Bar. 12" Oak N86¾°W 54¾ ft. 20" Fir S48°39'W 79¾ ft.
12	Int. D.L.C. & Sec. Lines. Rock. 12" Fir S10°E 25 lks. 8" Oak N70°W 52 lks.
13	¼ Sec. Cor. W side 30. Post. 22" Fir N65°E 63 lks. 30" Fir S80°E 80 lks.
14	Int. D.L.C. & Sec. Lines. Axle. 8" Oak West 33 lks. 6" Prune S2°E 128 lks.
15	N.E. Cor. 10 A. Tract. Staff. 6" Prune S72½°W 82 lks. 8" Laurel N87½°W 33 lks.
16	Closing ¼ Cor Sec. 25 I. Bar. 8" Fir N70°W 121 lks. 8" Oak S45°W lks.
17	Sec. Cor 30-31. Wh. Rock. 40" Fir S45°E 30 lks. 36" Fir N30°E 13 lks. 36" Fir N20°W 8 lks.
18	S.E. Cor. 10 A Tract Iron Rod. 24" Fir N65°E 44 lks. 32" Fir S70°E 58 lks.
19	Closing Sec. Cor. 25-36. Post. 12" Fir N46½°W 34 lks. 15" Fir S48°W 33 lks.
20	S.W. Cor. D.L.C. 57 X on Dead Root. 14" Fir N10°W 446 lks. 14" Cedar N45°E 396 lks.
21.	N.W. Cor D.L.C. 51 Spike in Root. 36" Tan Oak N55°E 39 lks. 36" Fir N50°E 4 lks.
22.	Cor 5.69 A. Tract Rock 40" Fir N10°29'E 148 lks. 24" Fir S52°17'W 123 lks.
23	" " " 30" Fir N71°7'W 85 lks.
24	" " " X on ledge 18" Fir N26°42'W 40 lks. 12" Fir N55°45'W 73 lks.

PLAT OF
SECTIONS 25 and 30 T. 30 S., R. 3 and 4 W
FROM SURVEY OF
BEN. B. IRVING, DEPUTY COUNTY SURVEYOR.
February and March 1930
SCALE 1 INCH = 300 FEET.

COUNTY SURVEYORS FILE COPY
DO NOT REMOVE FROM OFFICE

MAP FILE M1-7 ~~57~~
C.S. FILE 37/18 Bk 4, Pg 6