M 1-63

COUNTY SURVEYORS FILE
DO NOT REMOVE FROM

SURVEY TO ESTABLISH THE CENTER OF SEC. 20. T.29S., R.8W.

Surveyed by

Ben. B. Irving — DEPUTY COUNTY SURVEYOR

Survey commenced Dec. 13, 1927 completed Jan 5 1928

SCALE 1" = 5 CHAINS — VARIATION 21½° EAST

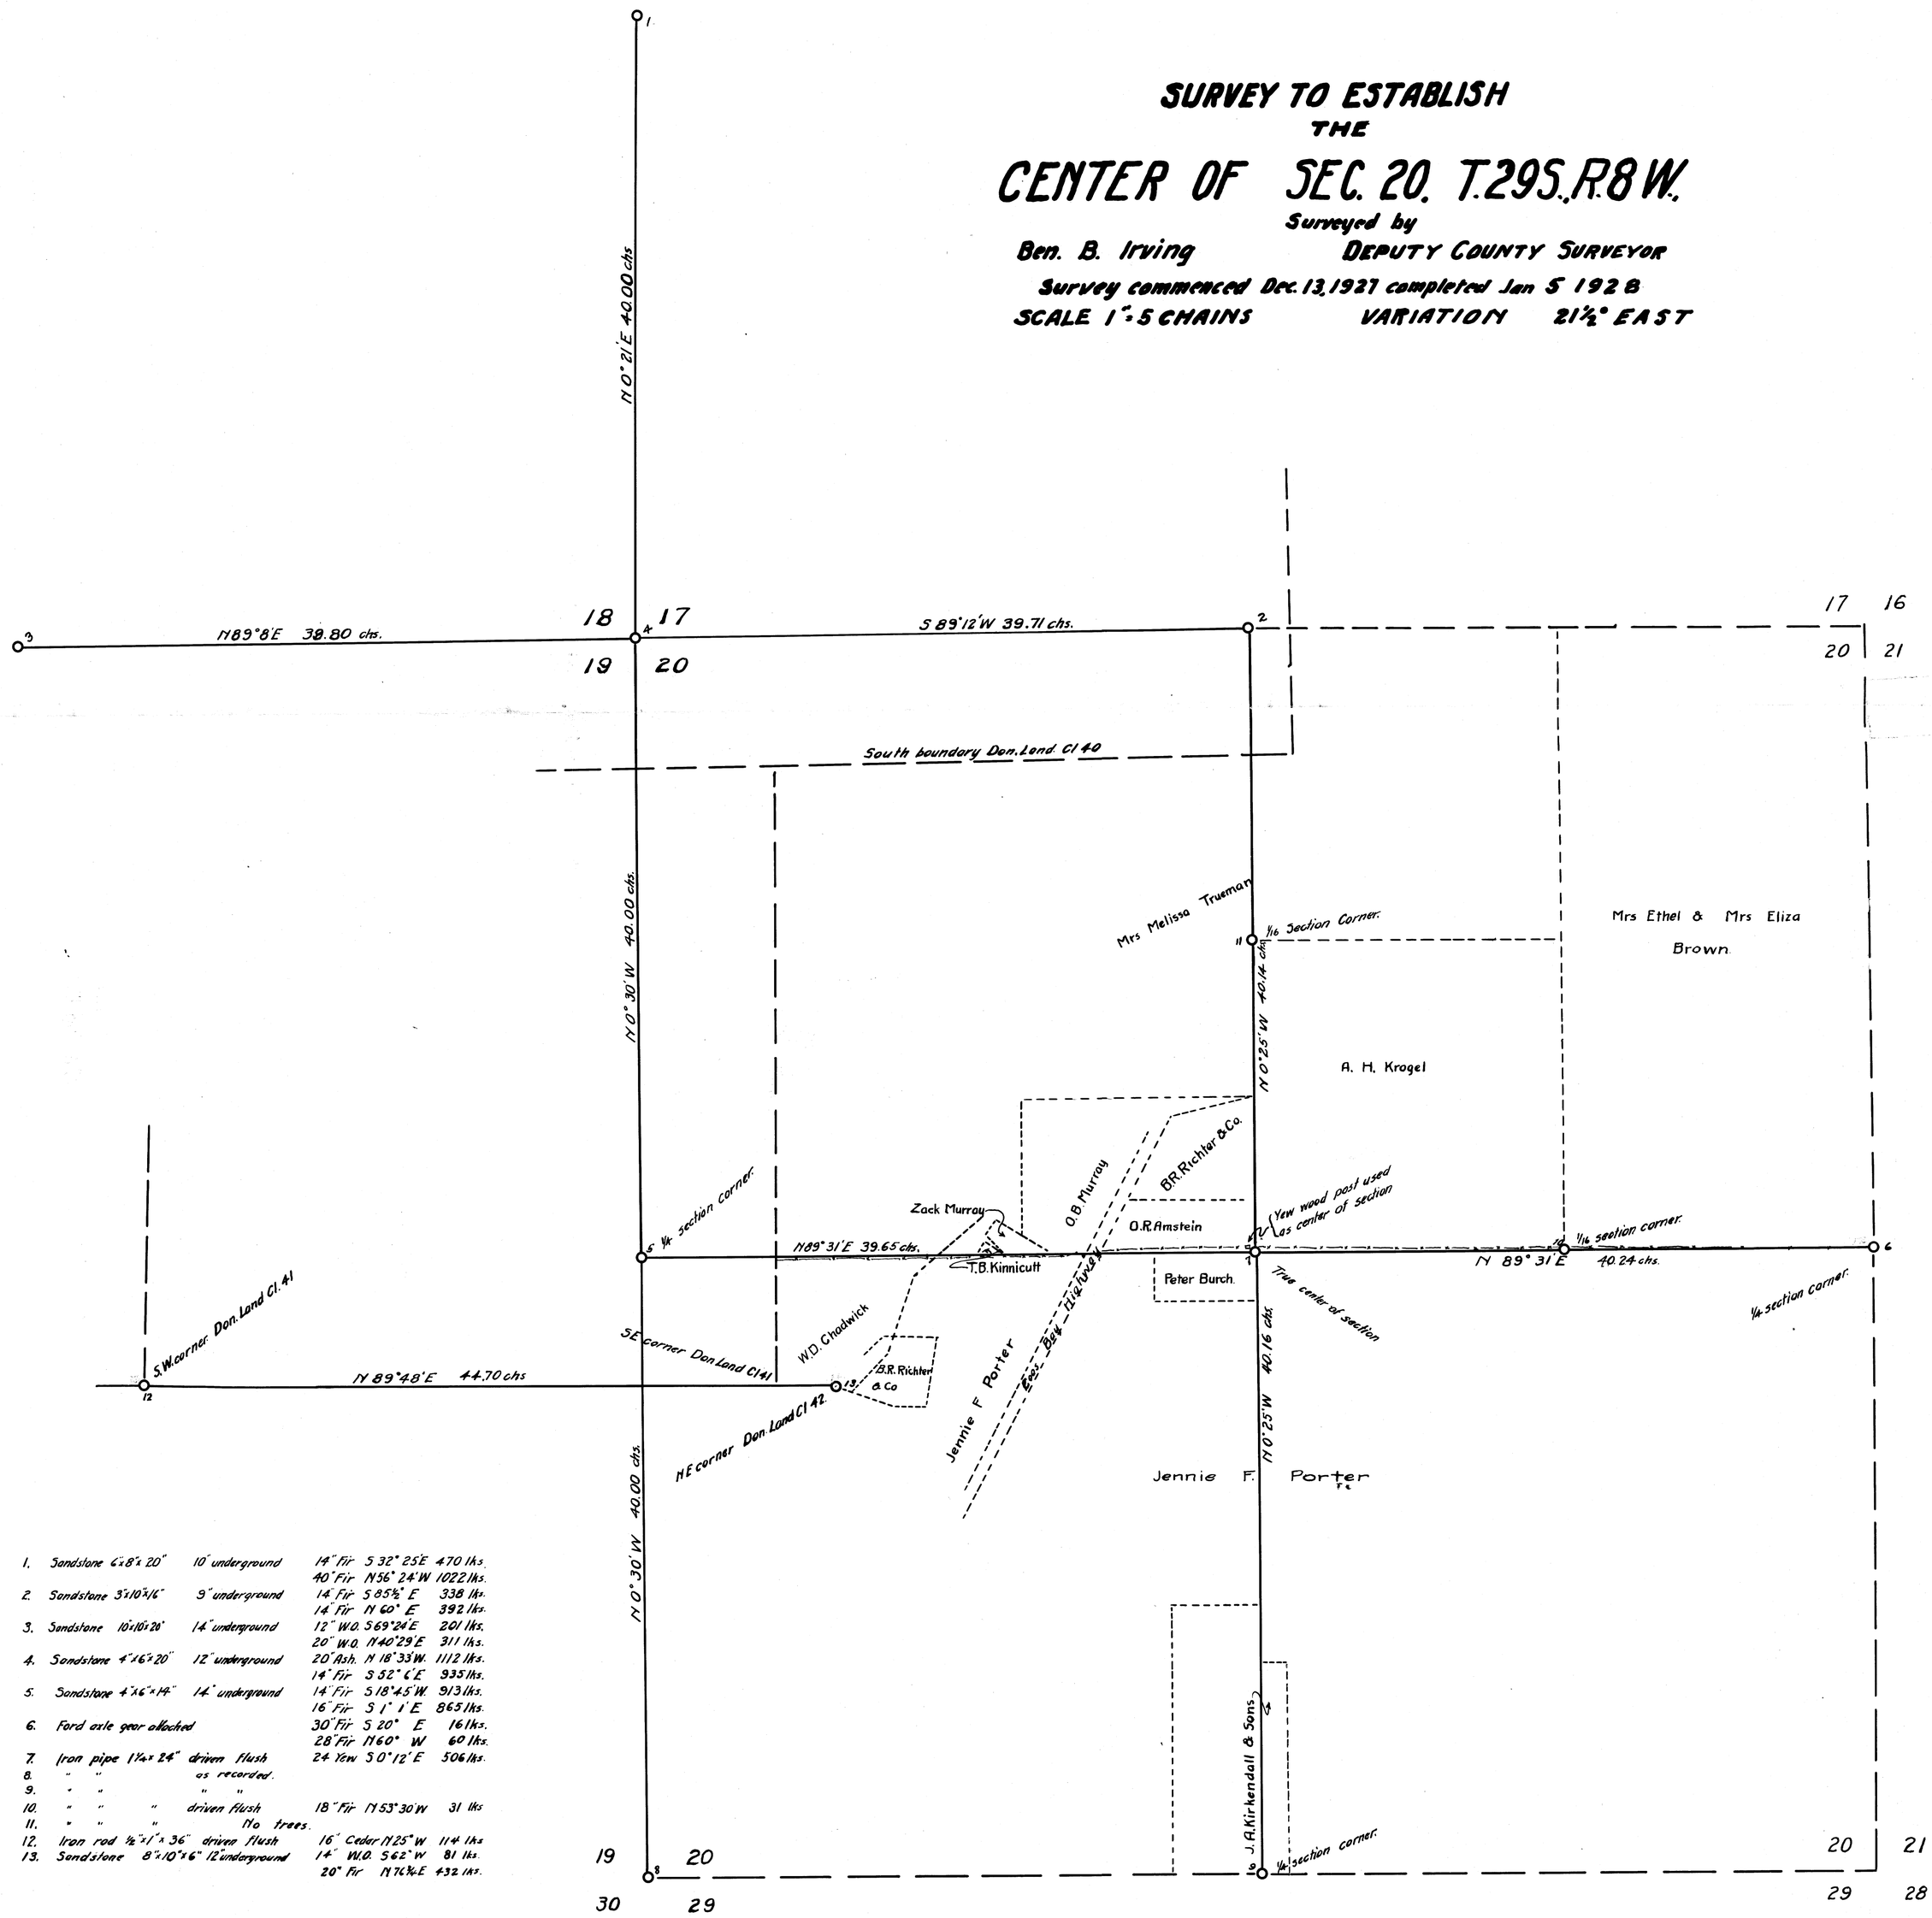

1.	Sandstone 6"x8"x20"	10" underground	14" Fir	S 32° 25' E	470 lks.
			40" Fir	N 56° 24' W	1022 lks.
2.	Sandstone 3"x10"x16"	9" underground	14" Fir	S 85½° E	338 lks.
			14" Fir	N 60° E	392 lks.
3.	Sandstone 10"x10"x20"	14" underground	12" W.O.	S 69° 24' E	201 lks.
			20" W.O.	N 40° 29' E	311 lks.
4.	Sandstone 4"x6"x20"	12" underground	20" Ash.	N 18° 33' W.	1112 lks.
			14" Fir	S 52° 6' E	935 lks.
5.	Sandstone 4"x6"x14"	14" underground	14" Fir	S 18° 45' W	913 lks.
			16" Fir	S 1° 1' E	865 lks.
6.	Ford axle gear attached		30" Fir	S 20° E	16 lks.
			28" Fir	N 60° W	60 lks.
7.	Iron pipe 1¼"x24" driven flush		24 Yew	S 0° 12' E	506 lks.
8.	" "	as recorded.			
9.	" "	" "			
10.	" " "	driven flush	18" Fir	N 53° 30' W	31 lks
11.	" " "	No trees.			
12.	Iron rod ½"x1"x36"	driven flush	16" Cedar	N 25° W	114 lks
13.	Sandstone 8"x10"x6"	12" underground	14" W.O.	S 62° W	81 lks.
			20" Fir	N 76¾° E	432 lks.

COUNTY SURVEYORS FILE
DO NOT REMOVE FROM

M 1-63
V.7 ENV. 3
Vol. 3 Pg. 2