COUNTY SURVEYORS FILE
DO NOT REMOVE FROM OF

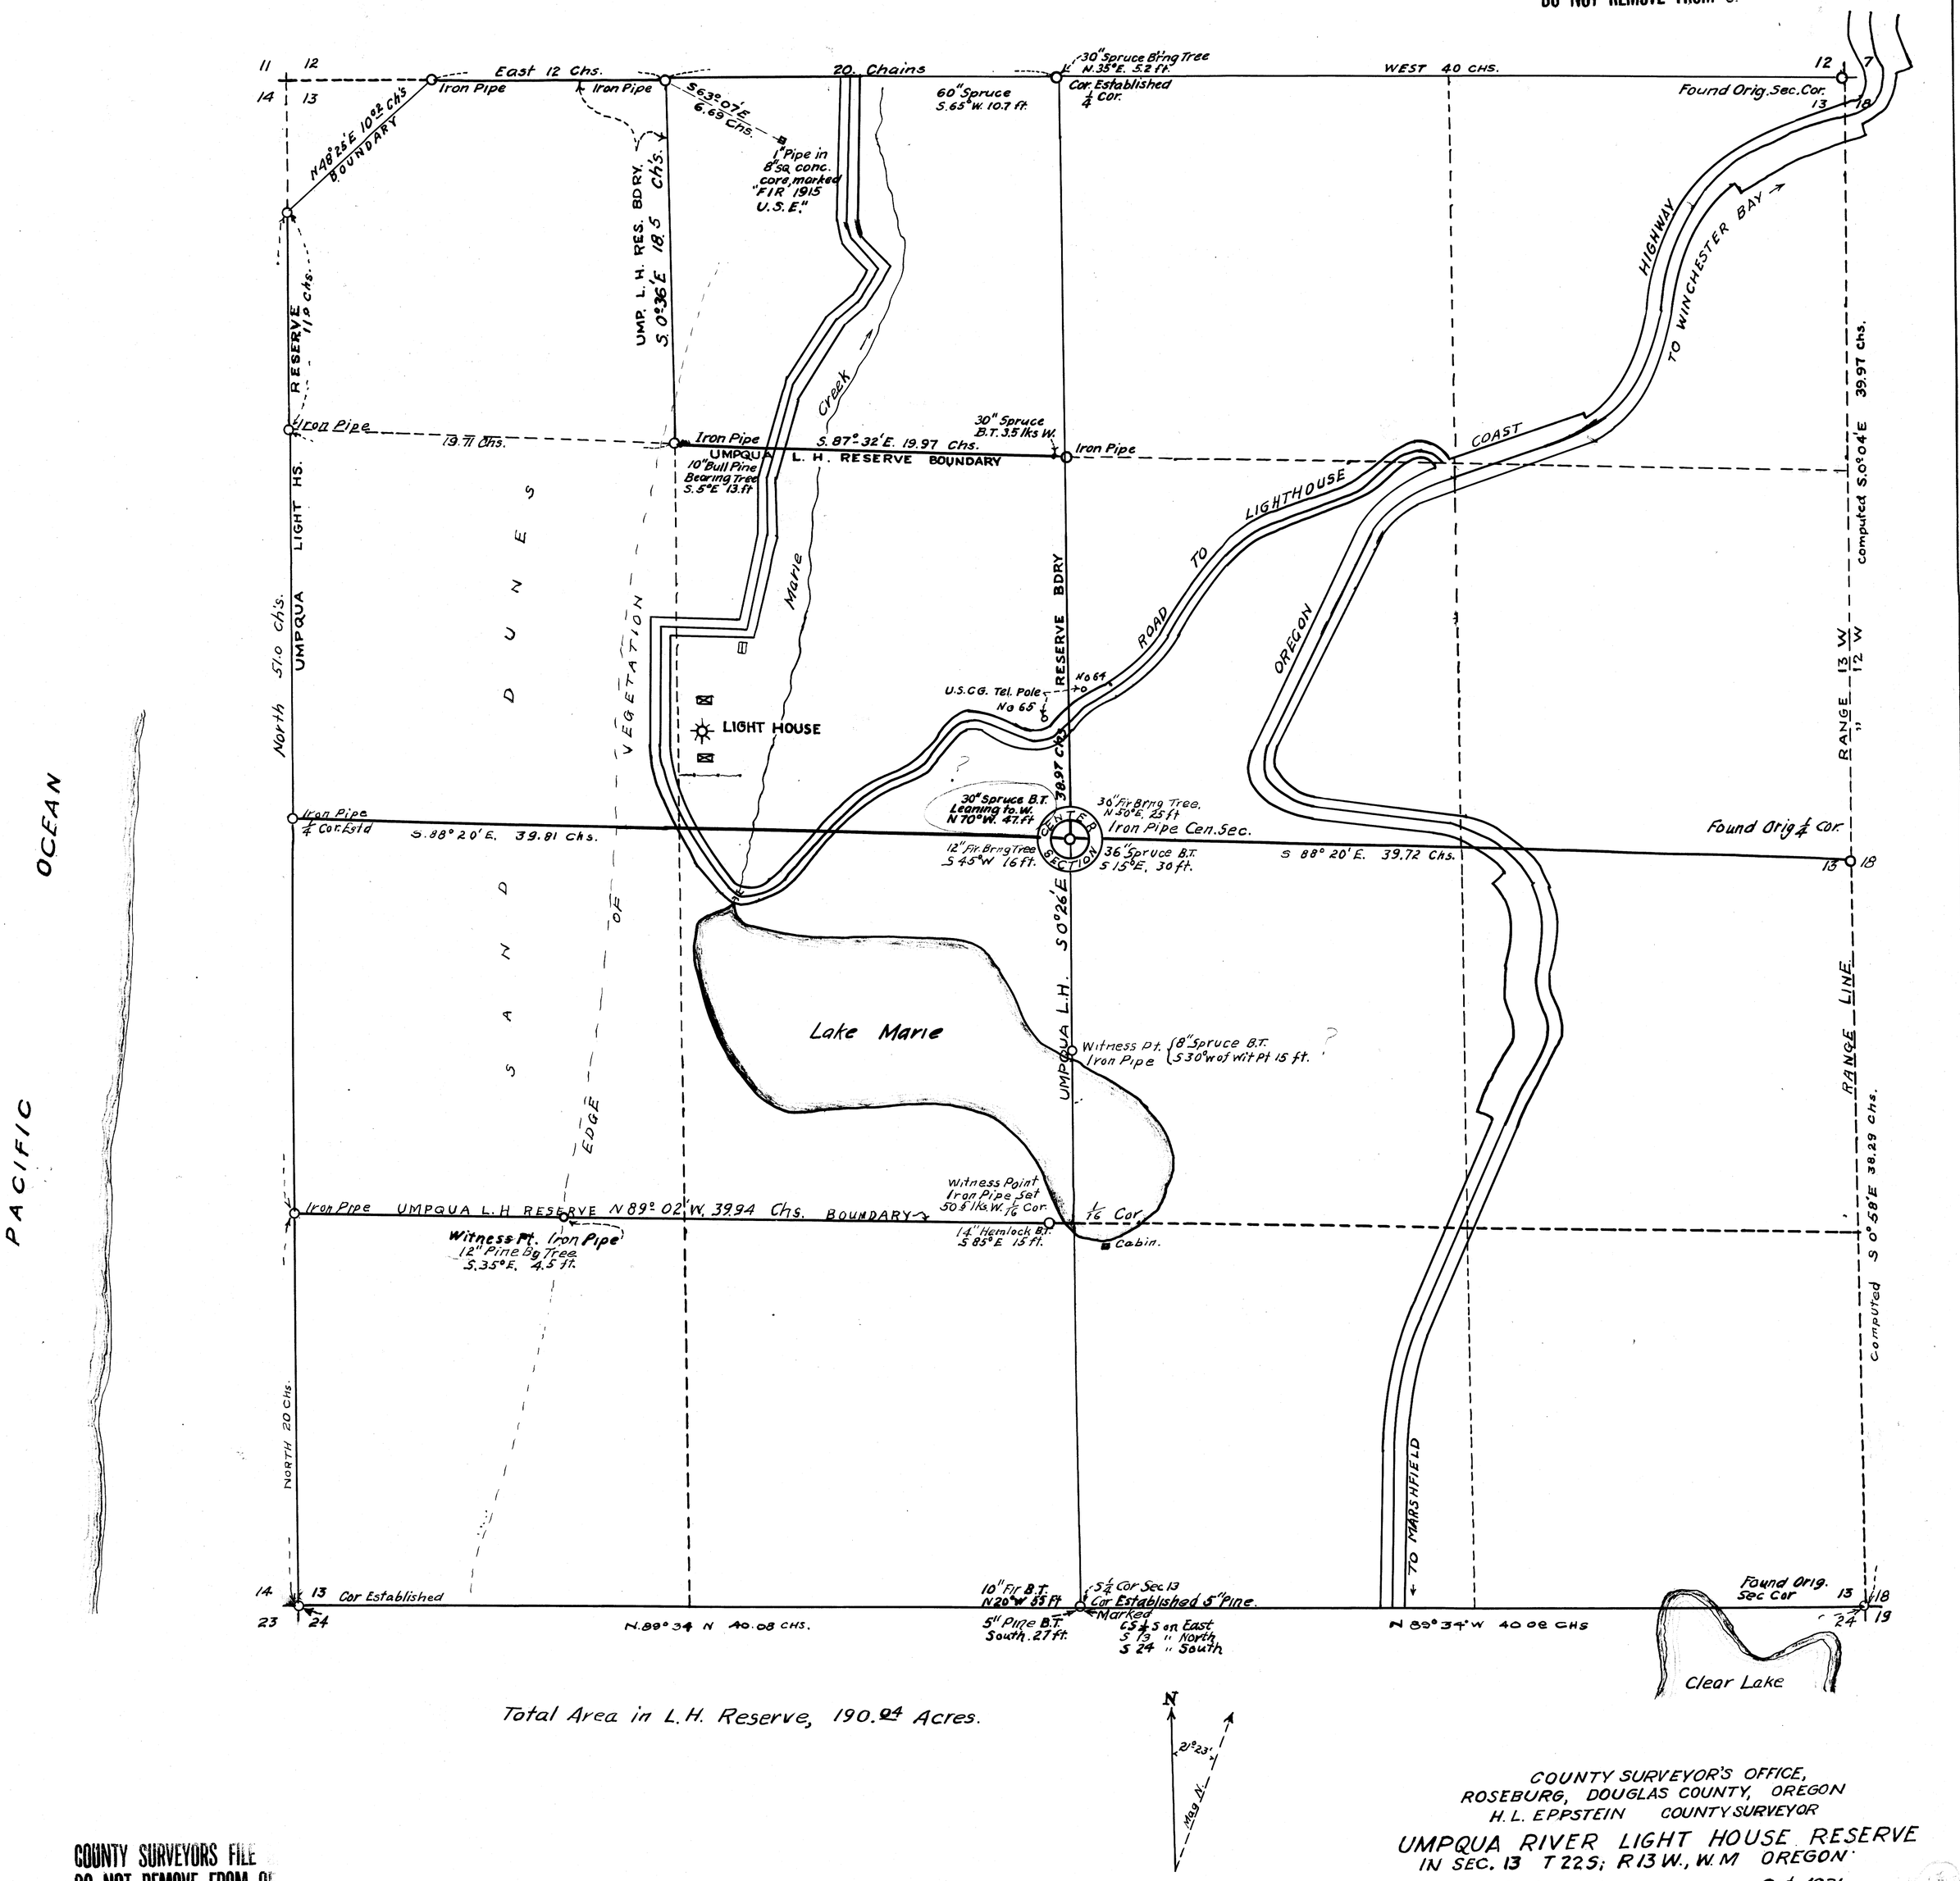

Total Area in L.H. Reserve, 190.24 Acres.

COUNTY SURVEYOR'S OFFICE,
ROSEBURG, DOUGLAS COUNTY, OREGON
H. L. EPPSTEIN COUNTY SURVEYOR

UMPQUA RIVER LIGHT HOUSE RESERVE
IN SEC. 13 T 22 S; R 13 W., W.M OREGON

Scale, 1" = 4 chains Oct. 1931

SEE VOL. 4 PG 12 & 13 MAP FILE M. 1 - 74

COUNTY SURVEYORS FILE
DO NOT REMOVE FROM OF

CS FILE No. 18/20
A&B
MAP FILE M 1 - 74