FILE M2-7-3

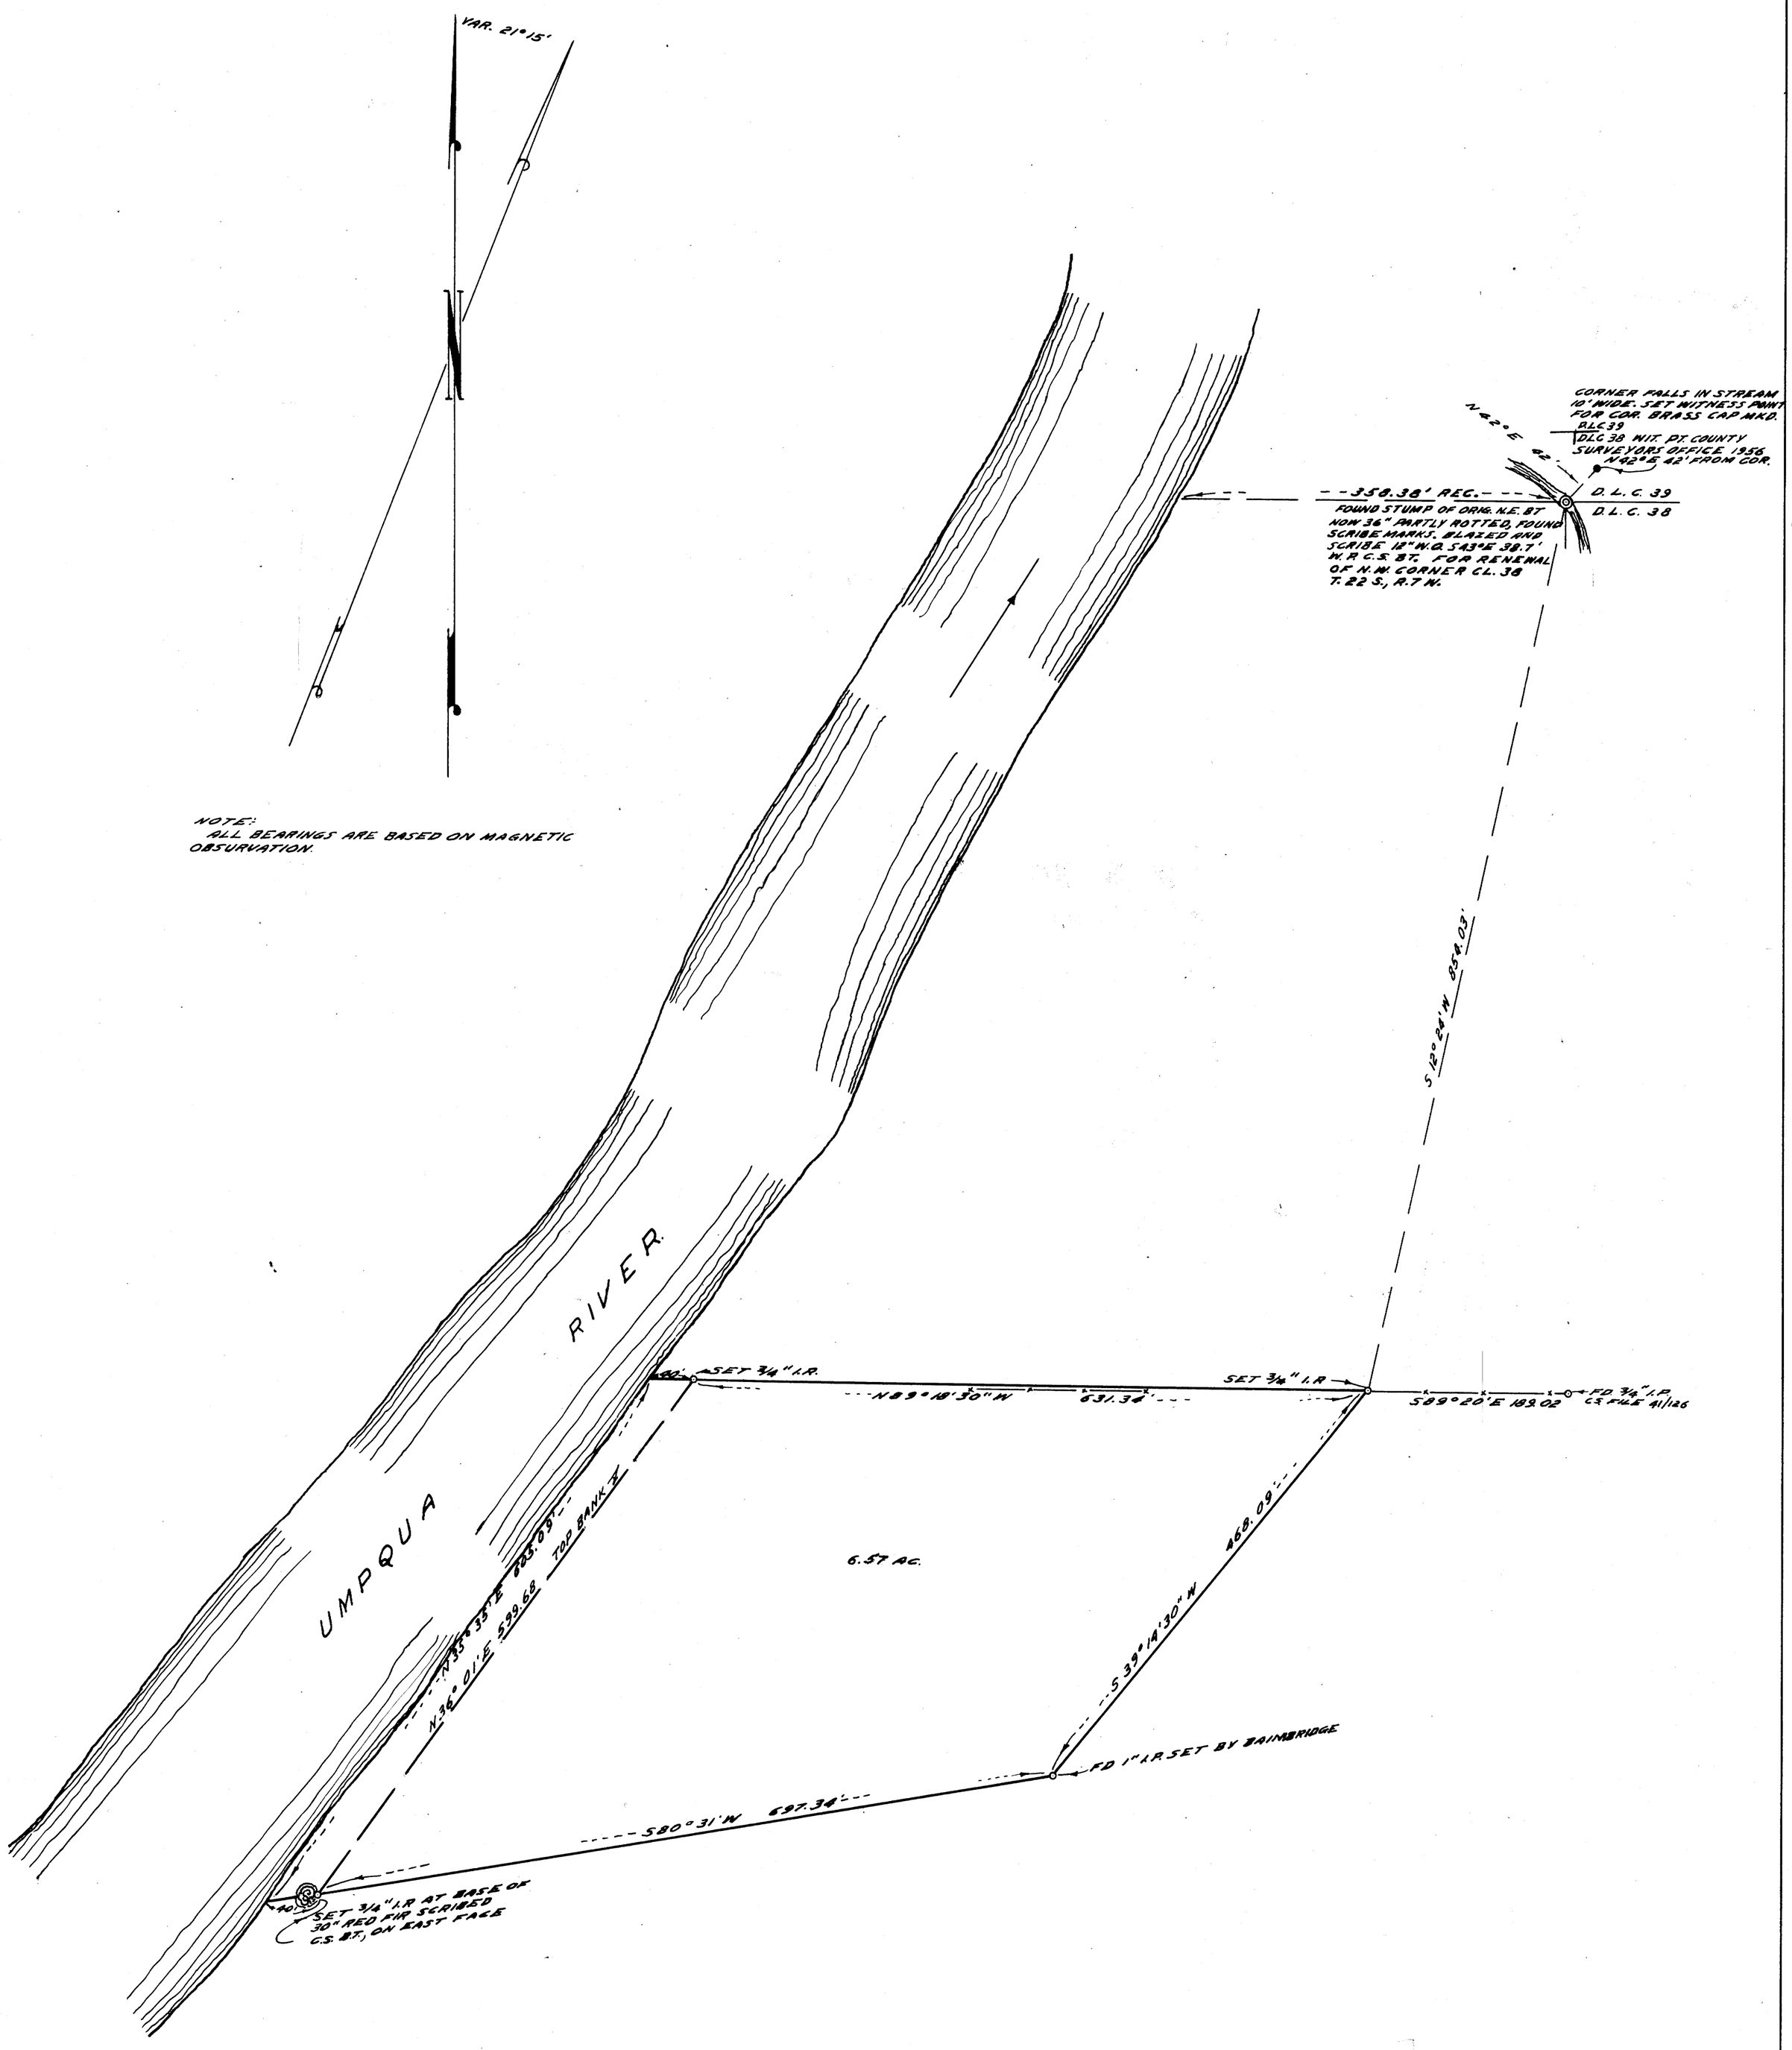

COUNTY SURVEYOR'S OFFICE
DOUGLAS COUNTY, OREGON

SURVEY FOR DEED DESCRIPTION
SECTION 30, T22S, R7W, W.M.

REGISTERED OREGON LAND SURVEYOR
James W. Byron
JAMES W. BYRON 303

FRED M. DARBY — COUNTY SURVEYOR
SURVEYED JAN. 24, 1956 — BY
JAMES W. BYRON - DEPUTY — SCALE 1" = 100'
SURVEYED FOR B. BAINBRIDGE

COUNTY SURVEYORS FILE DATA
DO NOT REMOVE FROM OFFICE

C. S. File No. 47/47
M2-3