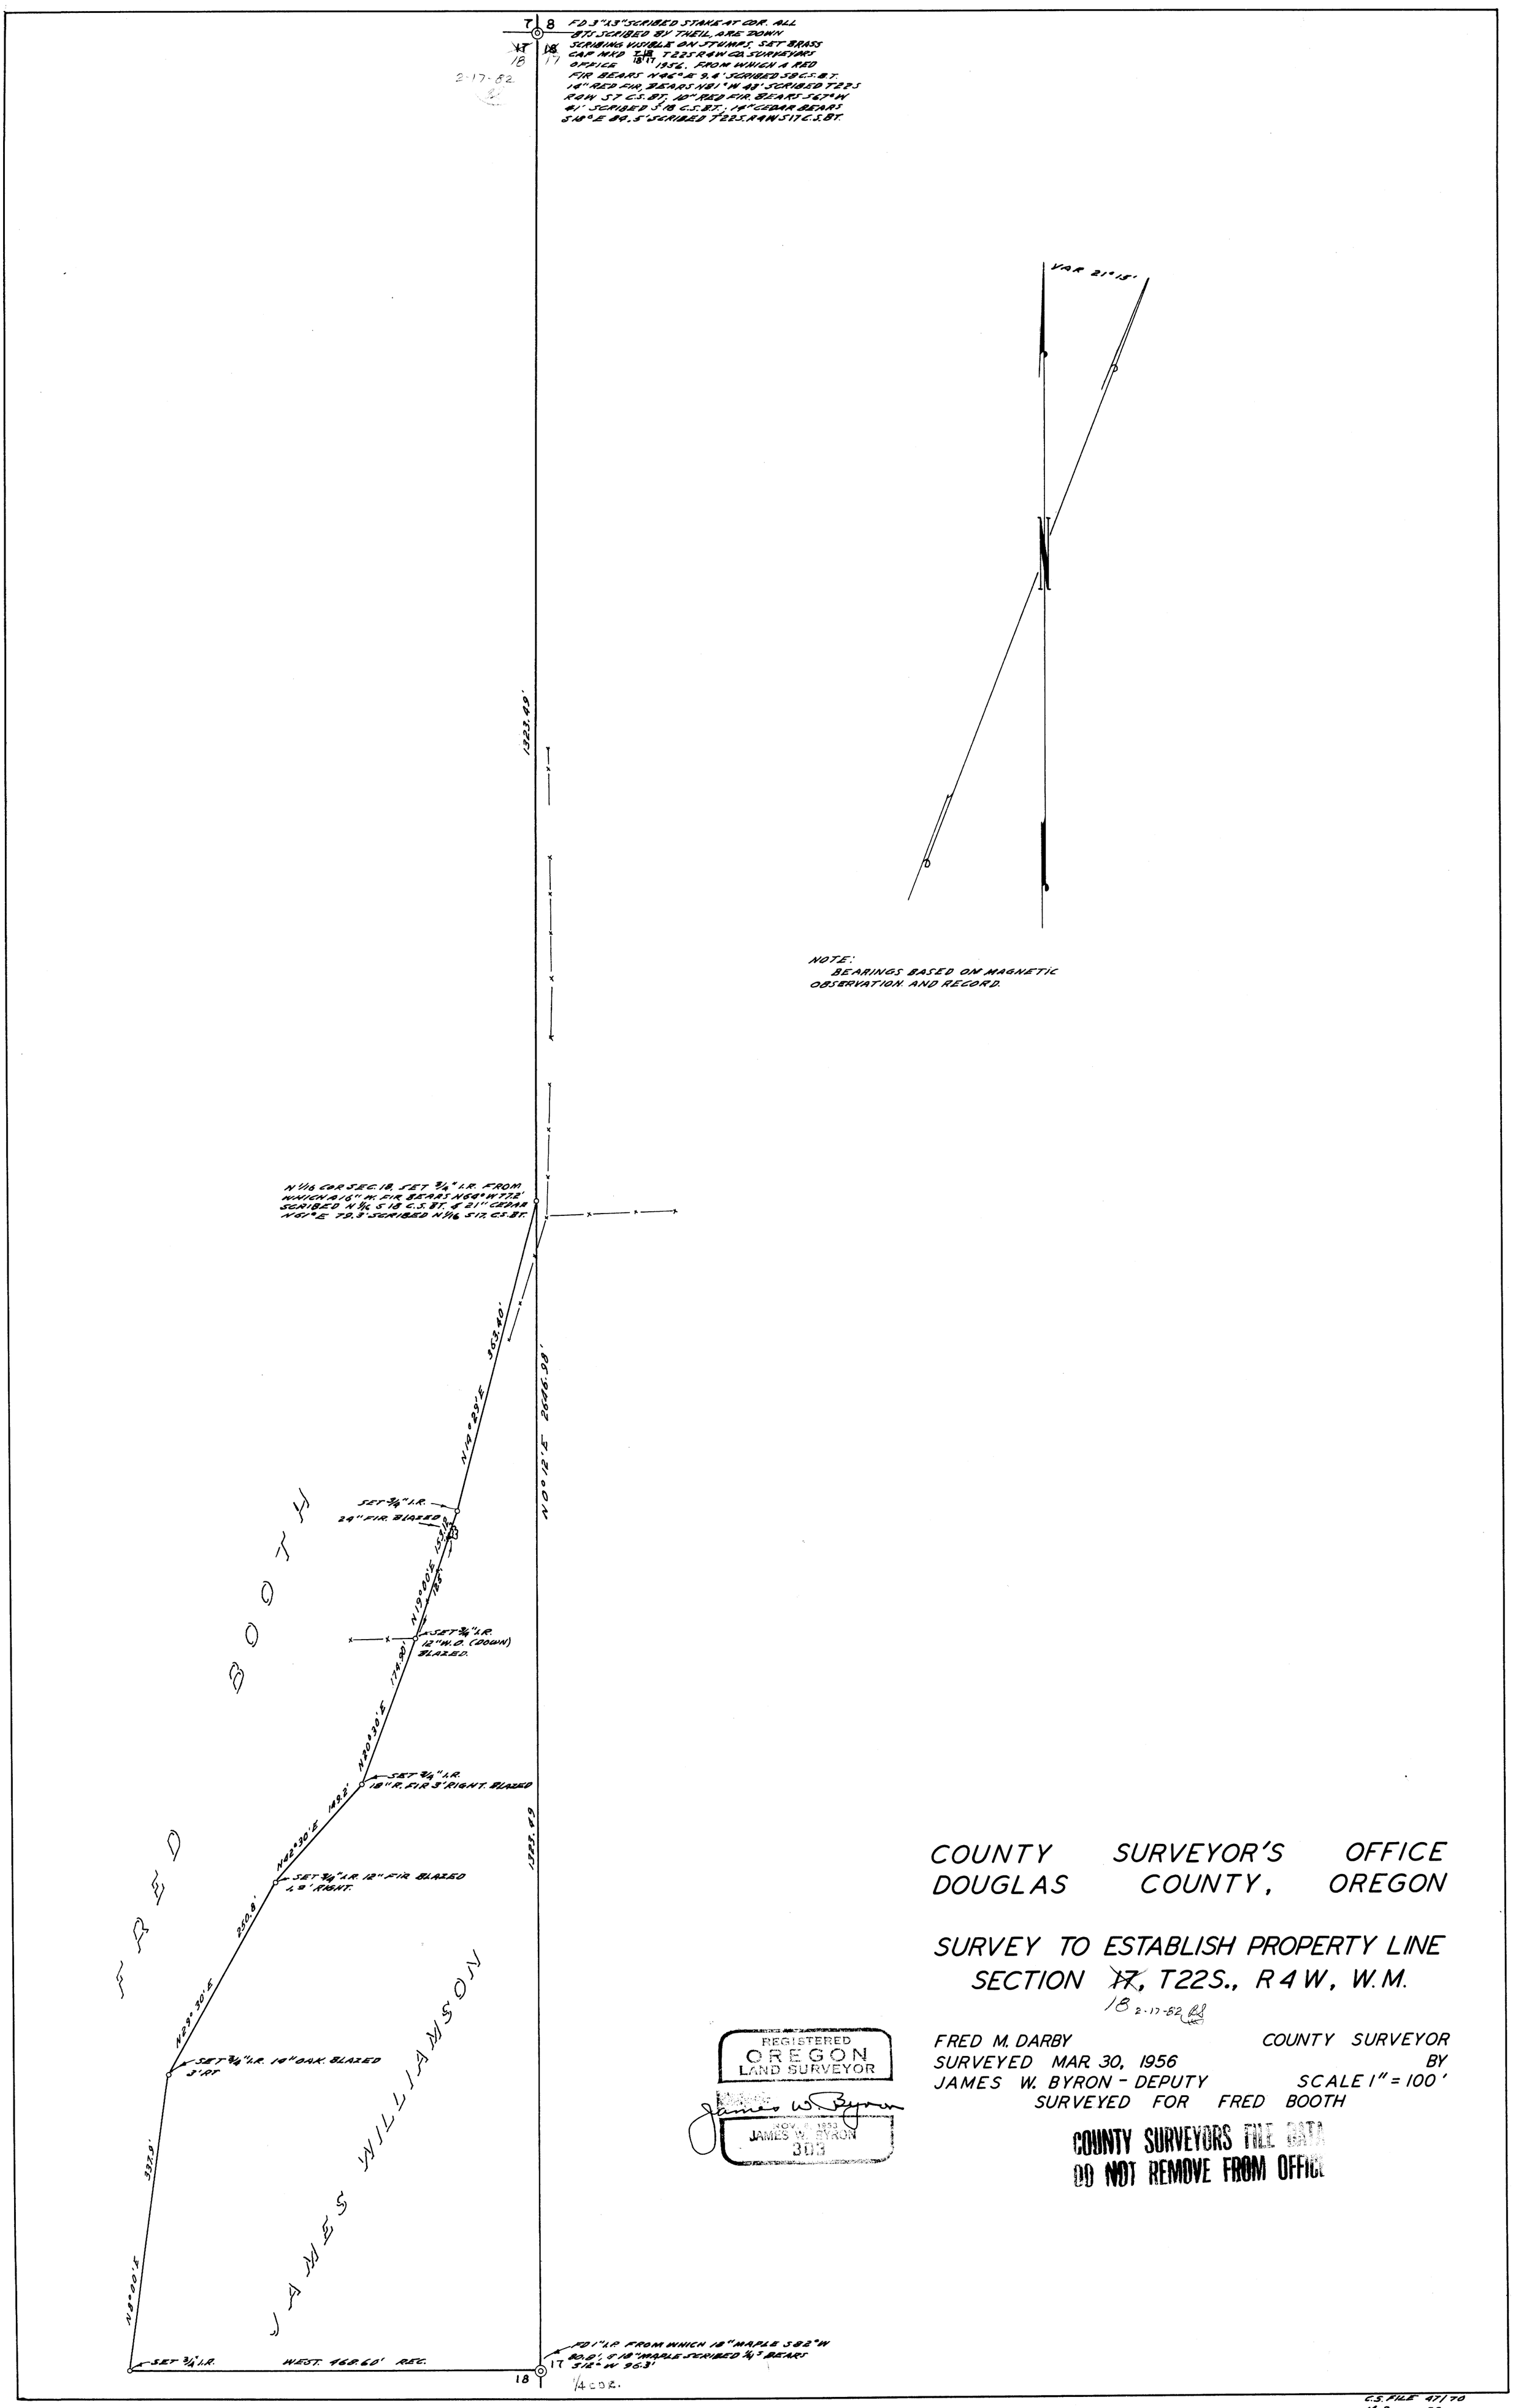
7 8
FD 3"X3" SCRIBED STAKE AT COR. ALL BTS SCRIBED BY THEIL, ARE DOWN SCRIBING VISIBLE ON STUMPS. SET BRASS CAP MKD T18 T17 T22S R4W CO. SURVEYORS OFFICE 1956. FROM WHICH A RED FIR BEARS N46°E 9.4' SCRIBED S8 C.S.B.T. 14" RED FIR, BEARS N81°W 43' SCRIBED T22S R4W S7 C.S.BT. 10" RED FIR, BEARS S67°W 41' SCRIBED S18 C.S.BT.; 14" CEDAR BEARS S18°E 89.5' SCRIBED T22S.R4W S17 C.S.BT.
2-17-82
VAR 21°15'
1323.49'
NOTE:
BEARINGS BASED ON MAGNETIC OBSERVATION AND RECORD.
N 1/16 COR SEC. 18, SET 3/4" I.R. FROM WHICH A 16" W. FIR BEARS N64°W 77.2' SCRIBED N 1/16 S 18 C.S.BT. & 21" CEDAR N61°E 79.3' SCRIBED N 1/16 S17 C.S.BT.
N 00°12'E 2646.98'
N14°29'E 353.40'
SET 3/4" I.R.
24" FIR. BLAZED
N19°00'E 155.40'
125'
SET 3/4" I.R.
12" W.O. (DOWN) BLAZED.
N20°30'E 174.90'
SET 3/4" I.R.
18" R. FIR 3' RIGHT. BLAZED
N42°30'E 149.2'
SET 3/4" I.R. 12" FIR BLAZED 1.9' RIGHT.
1323.49'
N29°30'E 250.8'
SET 3/4" I.R. 14" OAK. BLAZED 3' RT.
N8°00'E 337.0'
SET 3/4" I.R.
WEST. 468.60' REC.
18
FD 1" I.R. FROM WHICH 18" MAPLE S82°W 80.0', & 18" MAPLE SCRIBED 1/4 S BEARS
17 S12°W 96.3'
1/4 COR.
BOOTH
FRED
JAMES WILLIAMSON
REGISTERED OREGON LAND SURVEYOR
James W. Byron
NOV 10 1953
JAMES W. BYRON
303
COUNTY SURVEYOR'S OFFICE
DOUGLAS COUNTY, OREGON
SURVEY TO ESTABLISH PROPERTY LINE
SECTION ~~17~~, T22S., R4W, W.M.
18 2-17-82
FRED M. DARBY COUNTY SURVEYOR
SURVEYED MAR. 30, 1956 BY
JAMES W. BYRON - DEPUTY SCALE 1" = 100'
SURVEYED FOR FRED BOOTH
COUNTY SURVEYORS FILE DATA
DO NOT REMOVE FROM OFFICE
C.S. FILE 47170
M 2 — 32

M 2-32