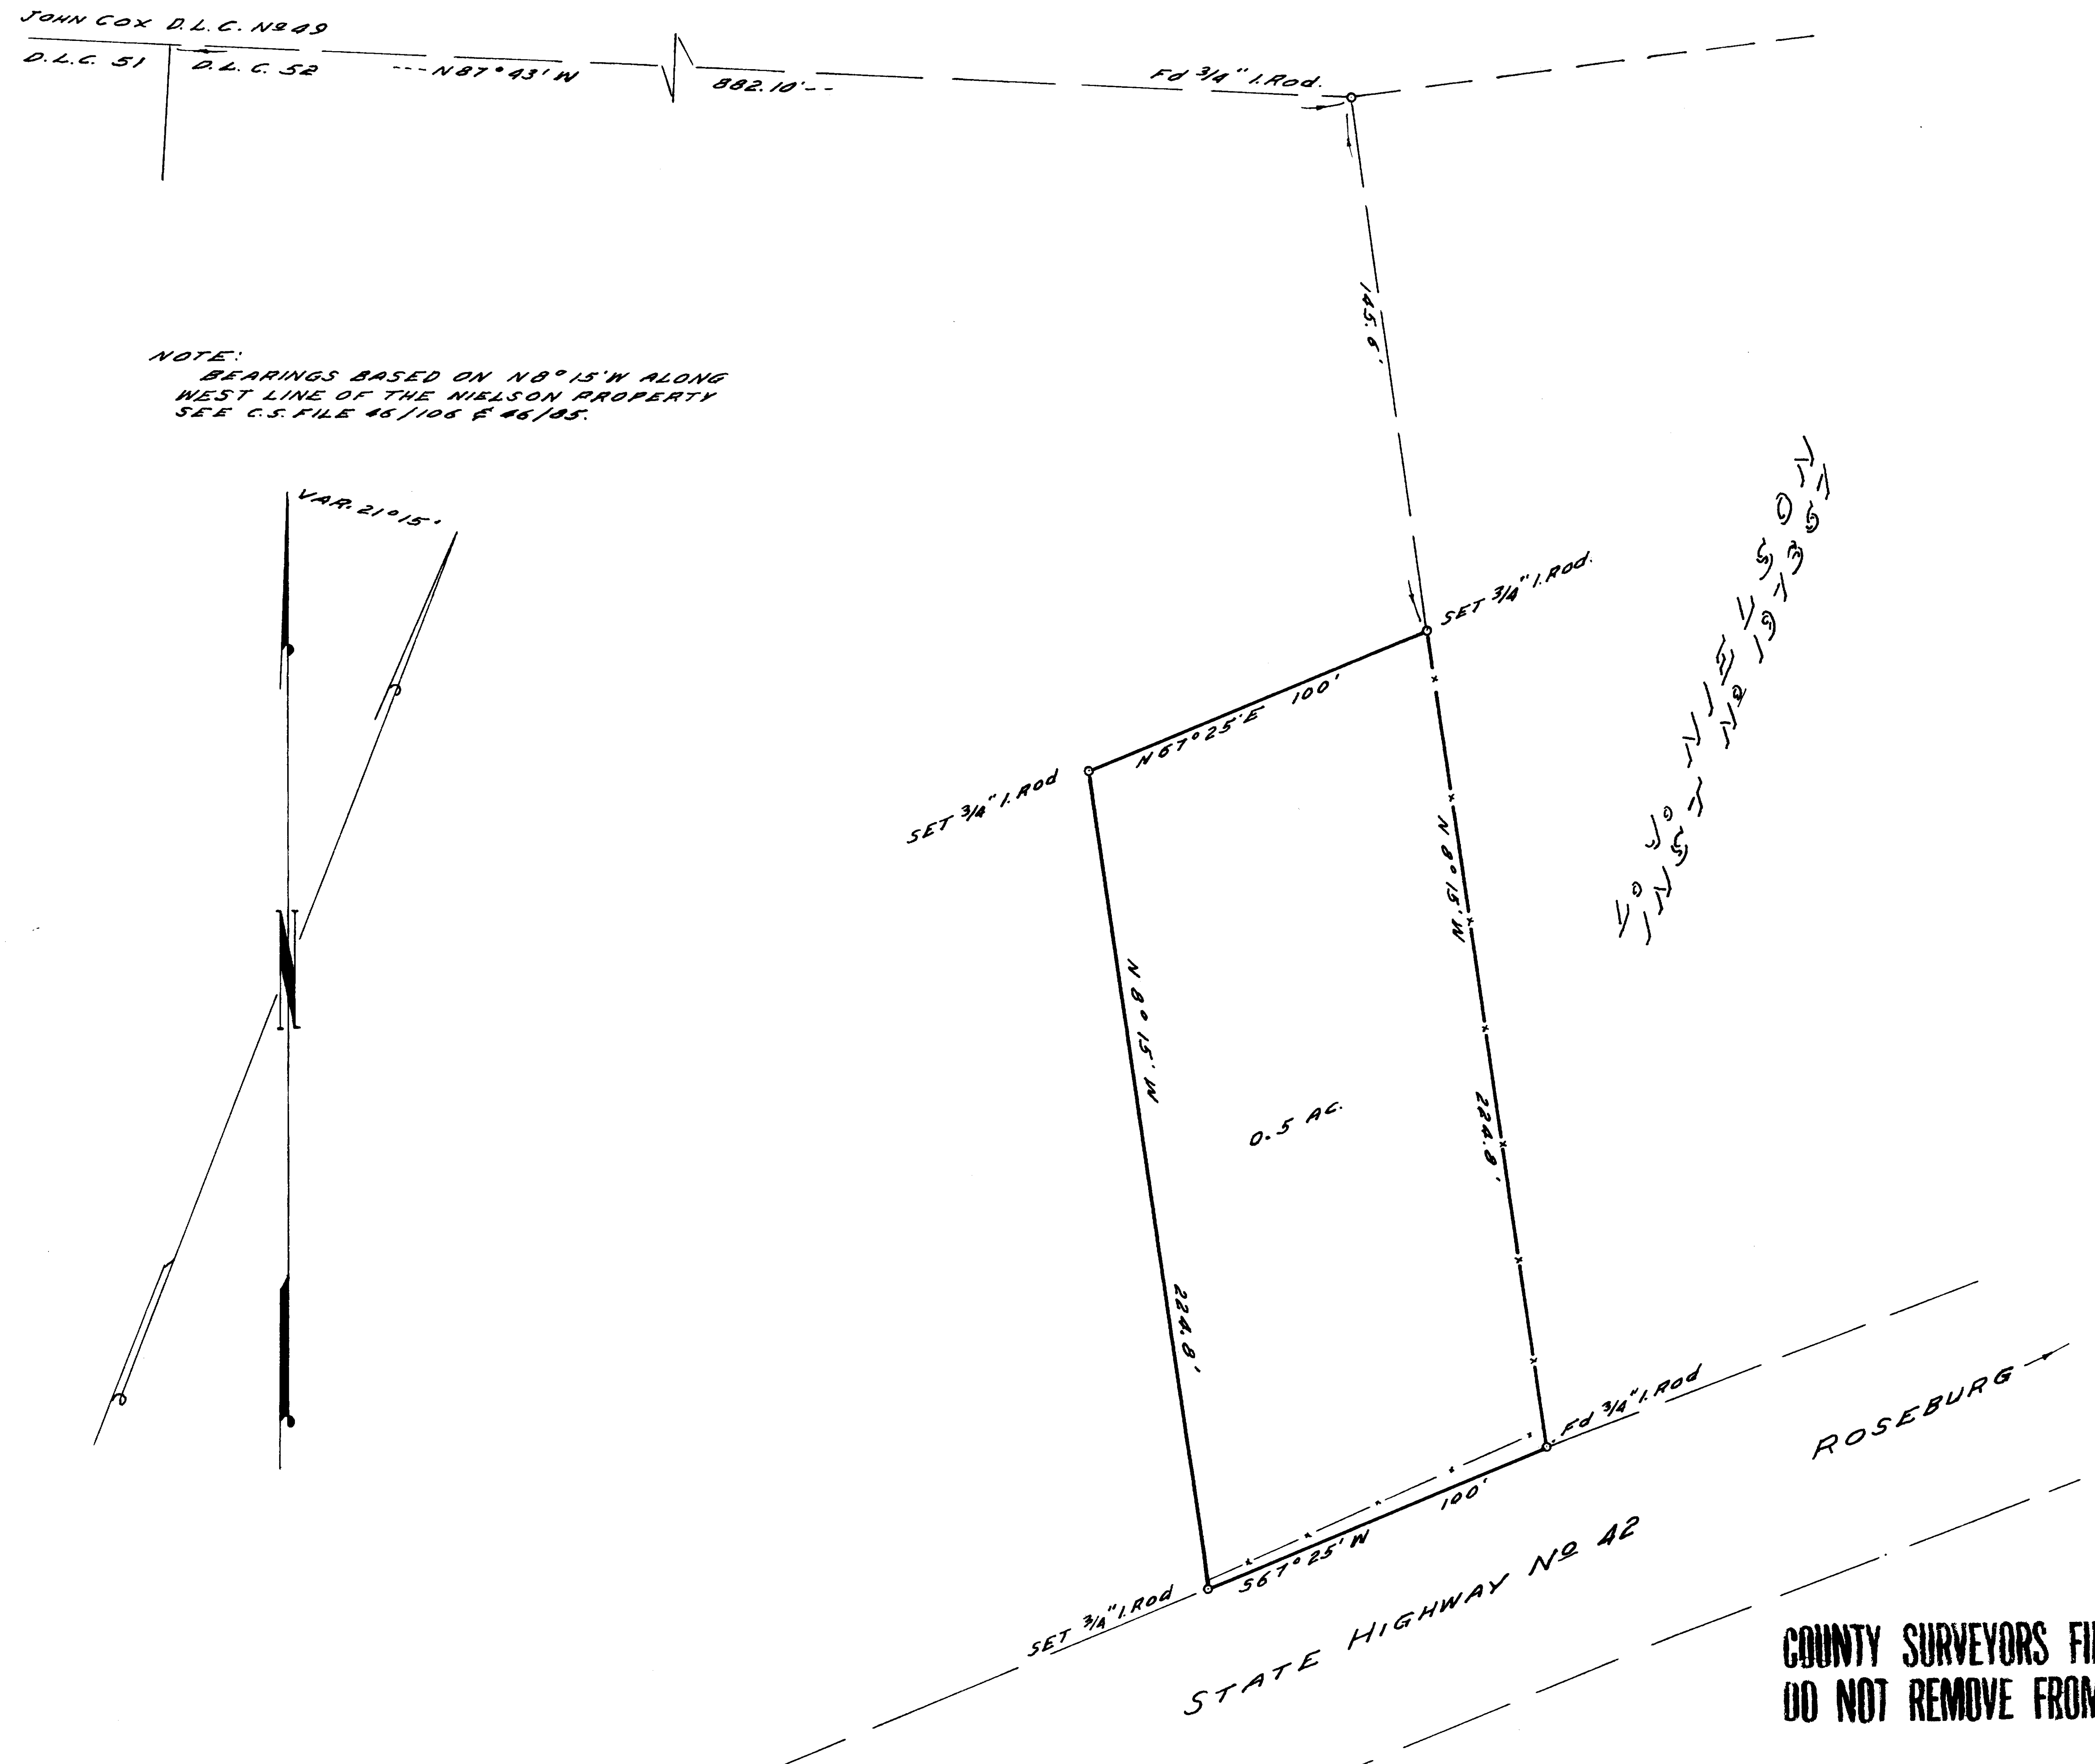

COUNTY SURVEYORS FILE DATA
DO NOT REMOVE FROM OFFICE

COUNTY SURVEYOR'S OFFICE
DOUGLAS COUNTY, OREGON

SURVEY FOR DEED DESCRIPTION
SECTION 20, T28S., R6W, W.M.

REGISTERED
OREGON
LAND SURVEYOR
Fred M Darby
MAY 7, 1954
FRED M. DARBY
320

REGISTERED
OREGON
LAND SURVEYOR
NOV. 6, 1953
JAMES W. BYRON
303

FRED M. DARBY COUNTY SURVEYOR
SURVEYED JUNE 6, 1956 BY
JAMES W. BYRON— DEPUTY SCALE 1" = 40'
SURVEYED FOR HAROLD NICHOLS

C.S. FILE 46/106
M 2-47