19-2 W

SURVEY for YONCALLA LUMBER CO.

IN

Secs. 25 & 36; Twp. 23 S.; Range 6 W.W.M. & Sec. 31; Twp. 23 S.; Range 5 W.W.M.

Scale: 1" = 500.0' April 1956

[redacted]

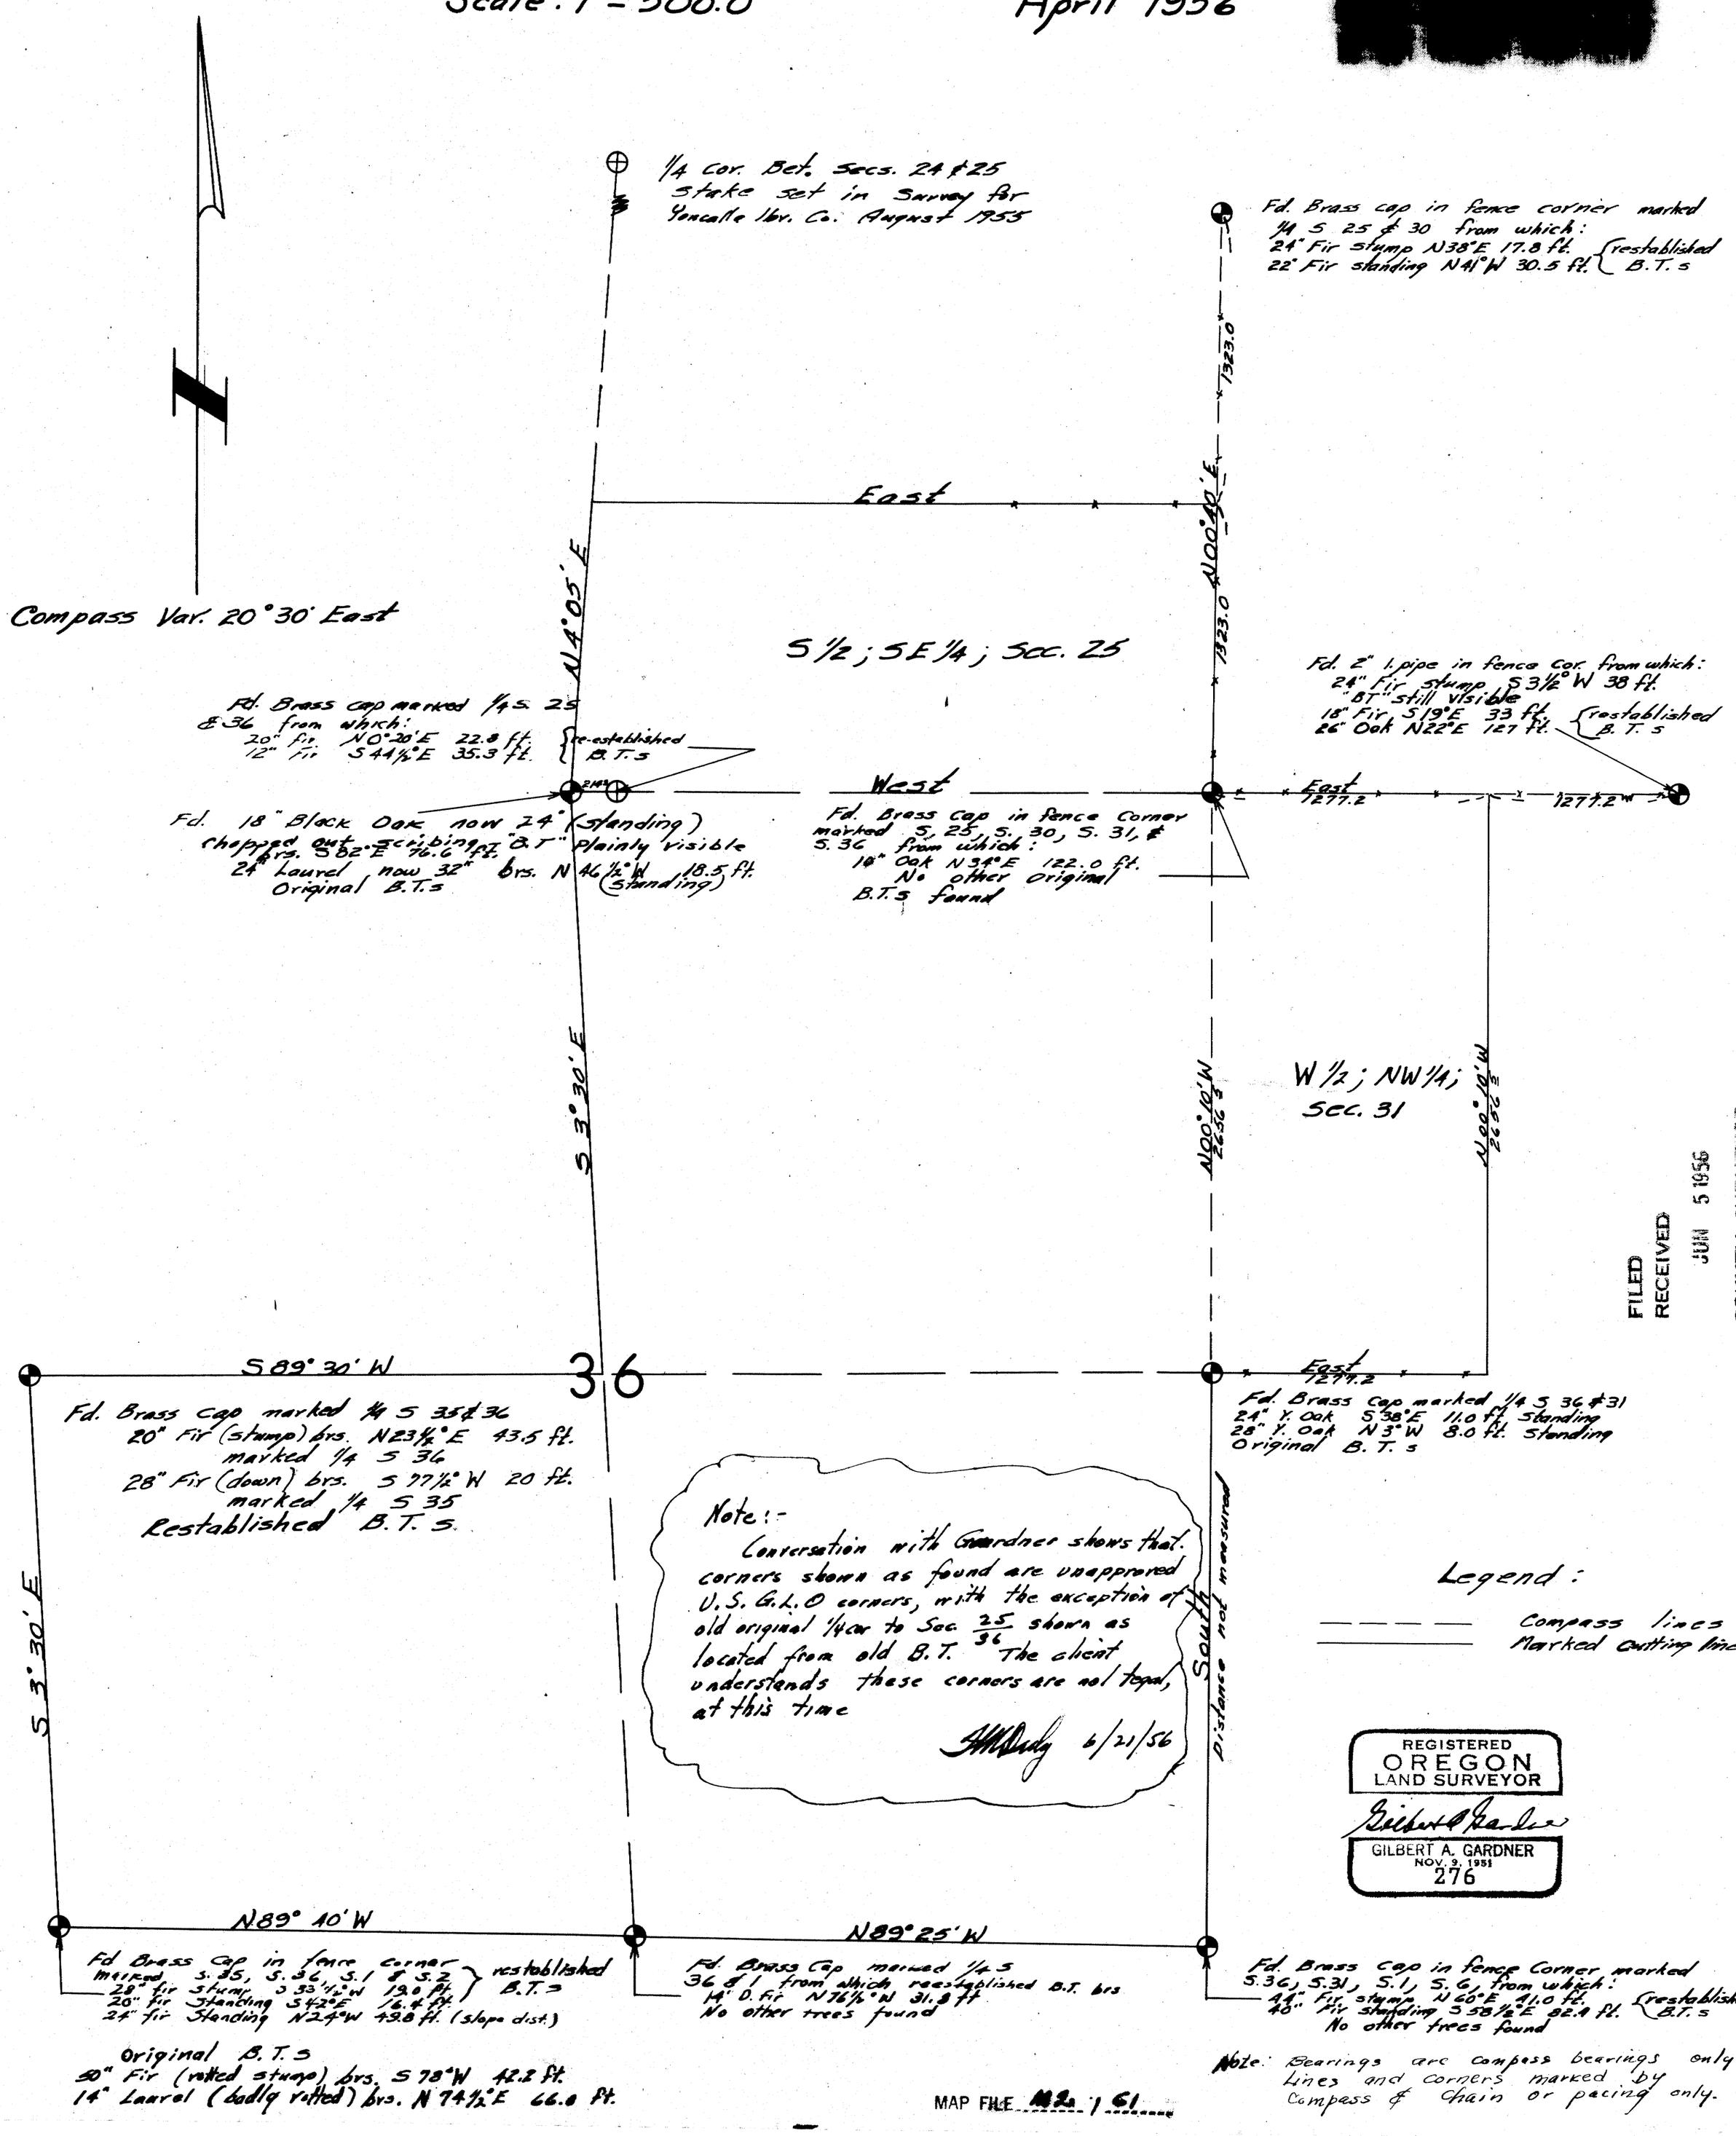

Note: Bearings are compass bearings only. Lines and corners marked by Compass & Chain or pacing only.

MAP FILE M2 161

FILED
RECEIVED
JUN 5 1956
COUNTY SURVEYOR
DOUGLAS COUNTY, ORE.