COUNTY SURVEYORS FILE DATA
DO NOT REMOVE FROM OFFICE

SURVEY TO ESTABLISH PROPERTY LINES
IN S½ NW¼, SEC. 16; T. 25 S.; R. 7 W.; W.M.
DOUGLAS COUNTY, OREGON

FOR
T. J. COONEY

GENE E. JOHNSON - ENGINEER
ROSEBURG OREGON
SURVEYED APRIL 1956 SCALE: 1"=100'

NOTE: BEARINGS SHOWN ARE BASED ON RECORD BEARING OF E-W ℄ (N 89° 11' E) AS PER G.R. EVANS SURVEY.

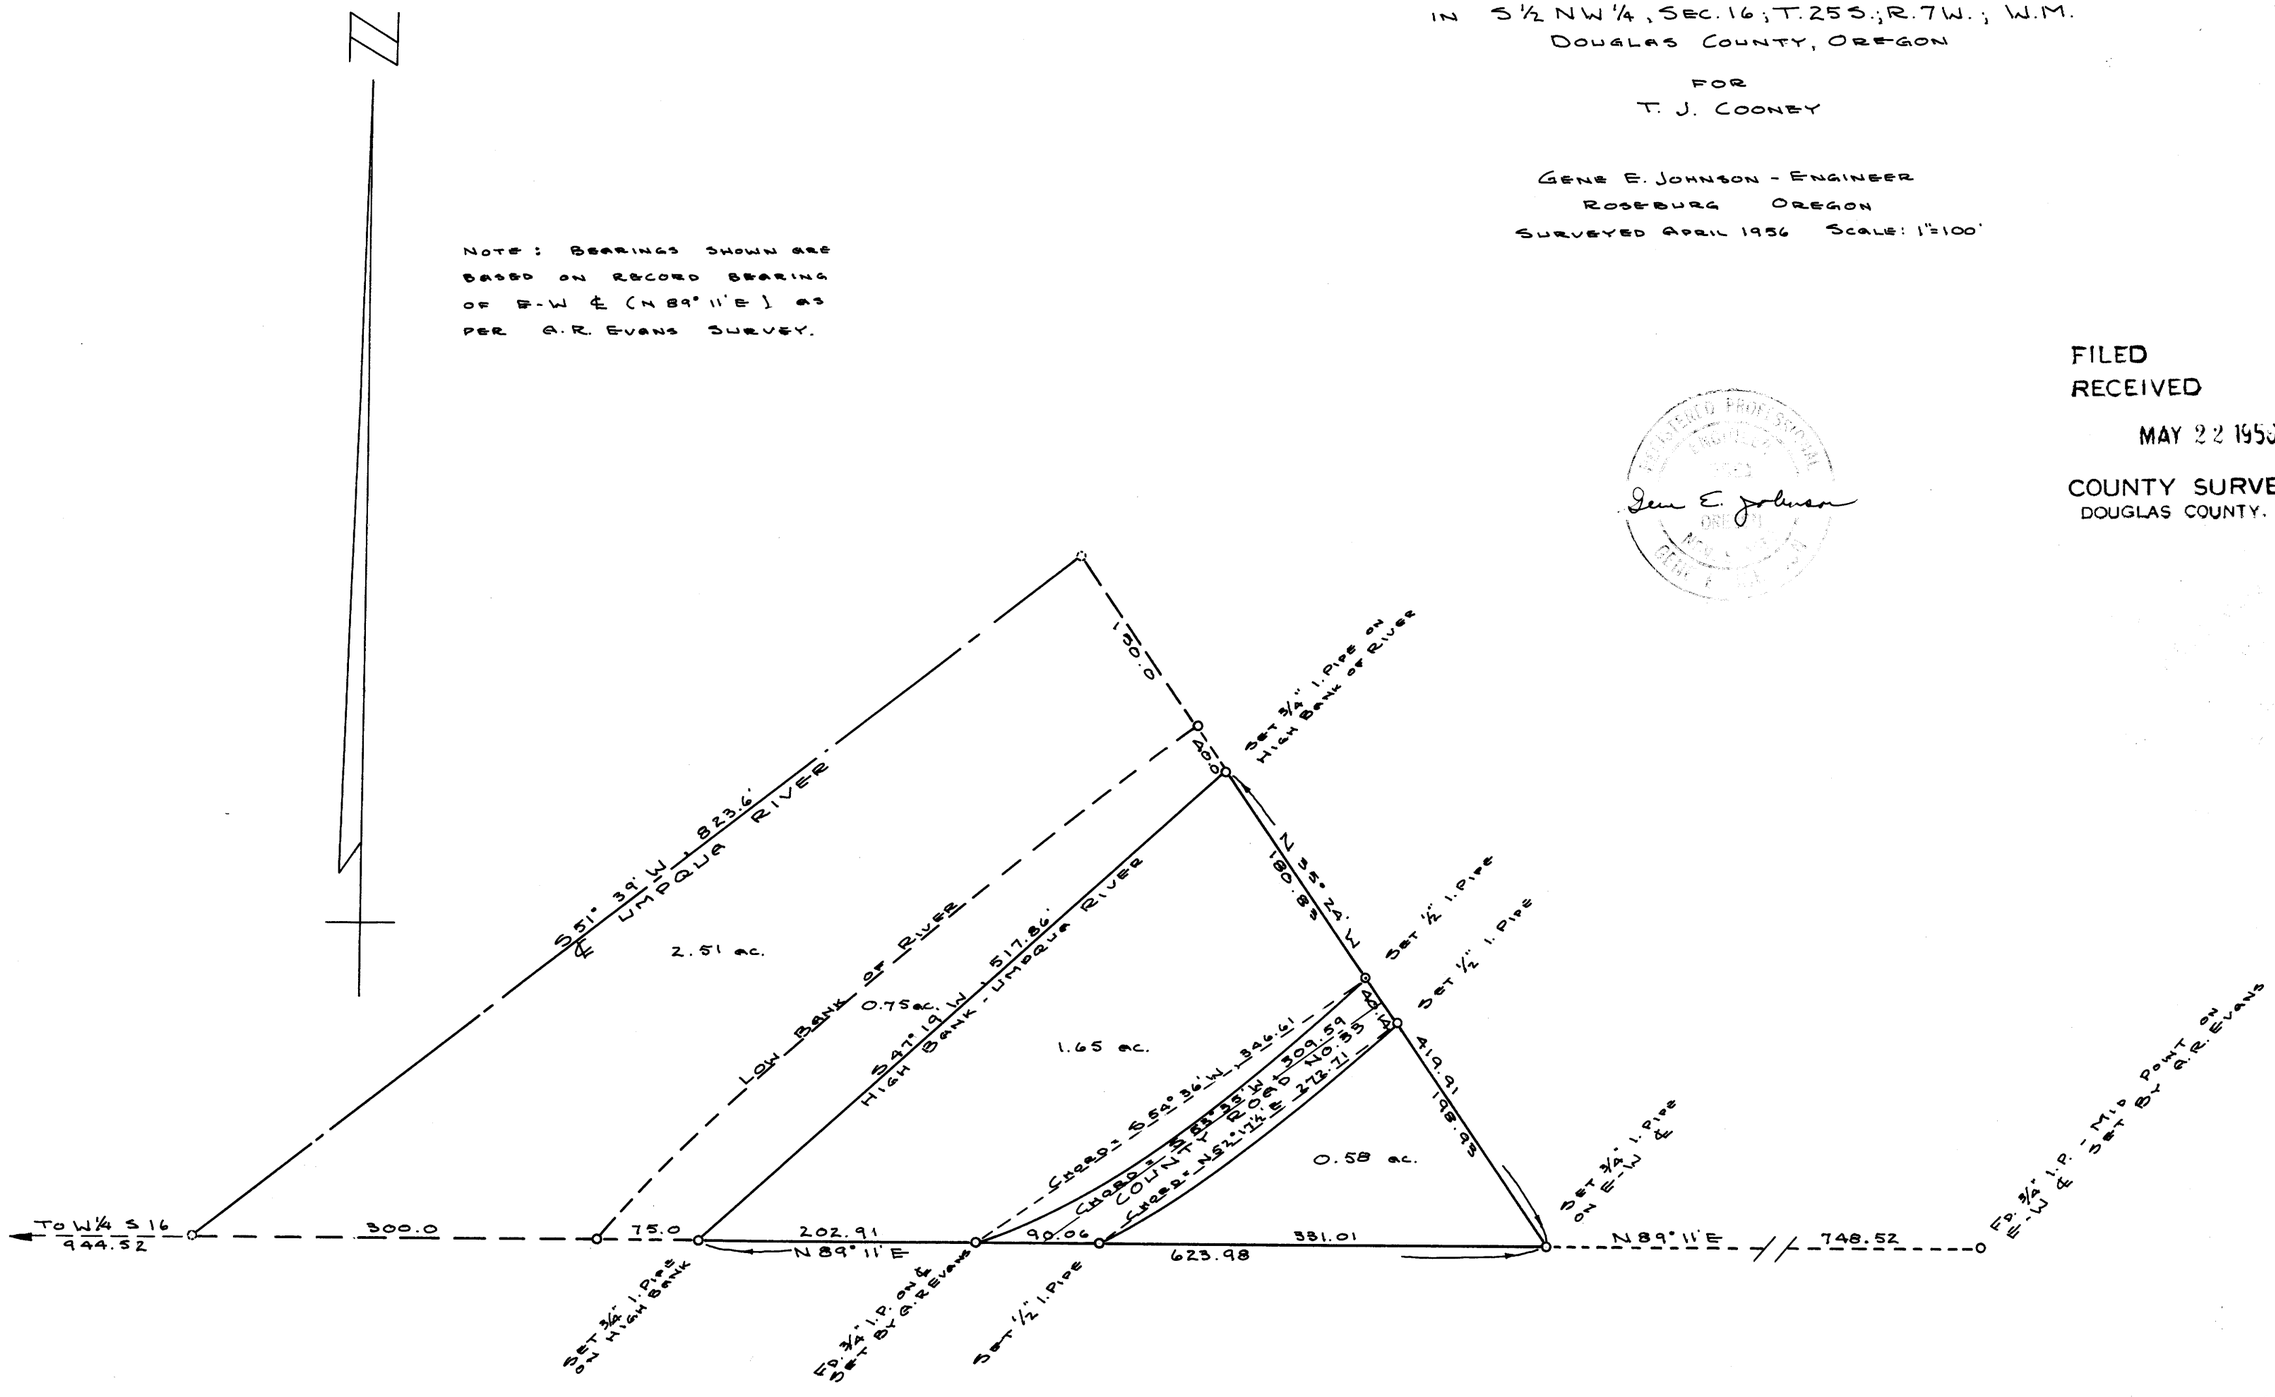

FILED
RECEIVED
MAY 22 1956
COUNTY SURVEYOR
DOUGLAS COUNTY, ORE.

C. S. File No. 42/164
MAP FILE M2 178