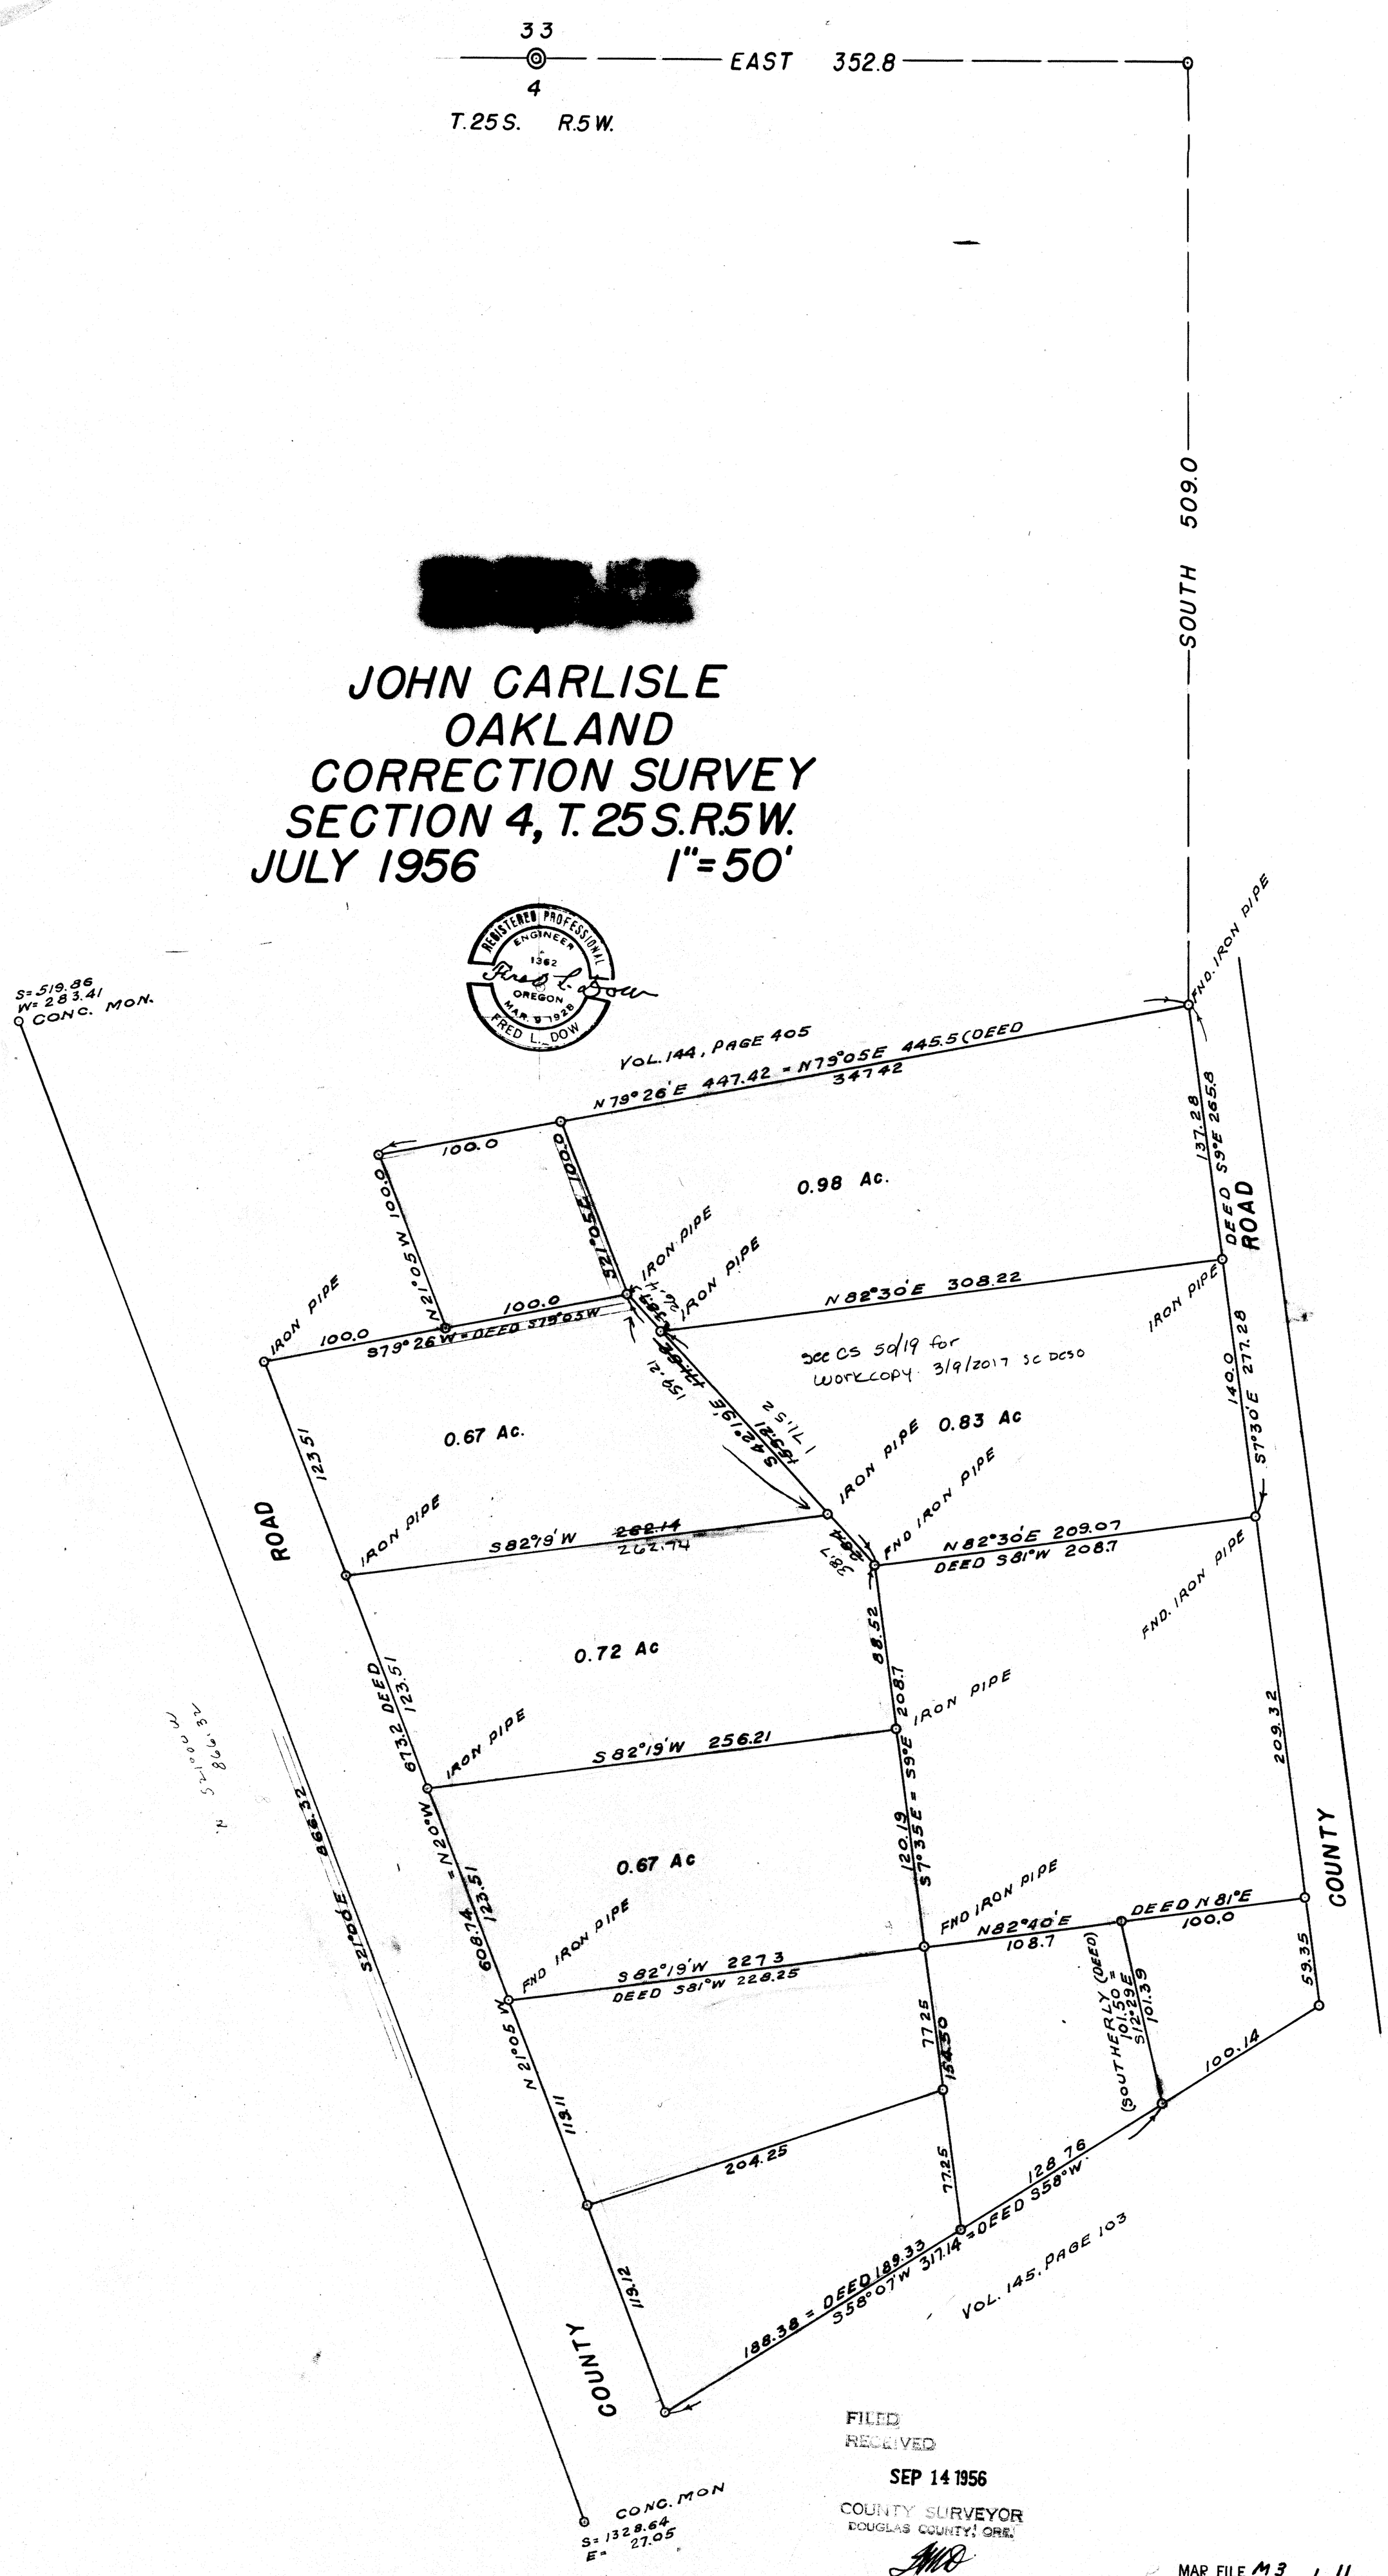
33
4
T.25S. R.5W.
EAST 352.8
SOUTH 509.0
JOHN CARLISLE
OAKLAND
CORRECTION SURVEY
SECTION 4, T.25S.R.5W.
JULY 1956 1"=50'
REGISTERED PROFESSIONAL ENGINEER 1362 OREGON MAR. 9 1928 FRED L. DOW
S=519.86
W=283.41
CONC. MON.
VOL. 144, PAGE 405
N79°26'E 447.42 = N79°05E 445.5 (DEED 347.42)
FND. IRON PIPE
137.28
DEED S9°E 265.8
ROAD
100.0
N21°05W 100.0
S21°05E 100.0
0.98 Ac.
IRON PIPE
N82°30'E 308.22
S79°26W = DEED S79°03W
See CS 5019 for
WORKCOPY 3/9/2017 SC DCSO
0.67 Ac.
0.83 Ac
S42°19E 159.21
140.0
S7°30'E 277.28
123.51
S82°19'W 262.74
FND IRON PIPE
N82°30'E 209.07
DEED S81°W 208.7
0.72 Ac
88.52
208.7
673.2 DEED 123.51
S82°19'W 256.21
S7°35E = S9°E
120.19
209.32
866.32
S21°05E
0.67 Ac
608.74 = N20°W 123.51
S82°19'W 227.3
DEED S81°W 228.25
N82°40'E 108.7
DEED N81°E 100.0
COUNTY
59.35
N21°05W
119.11
77.25
154.50
(SOUTHERLY (DEED) = 101.50 S12°29E 101.39)
100.14
204.25
128.76
188.38 = DEED 189.33
S58°07'W 317.14 = DEED S58°W
VOL. 145, PAGE 103
CONC. MON
S=1328.64
E=27.05
FILED
RECEIVED
SEP 14 1956
COUNTY SURVEYOR
DOUGLAS COUNTY, ORE.
MAP FILE M3 / 11