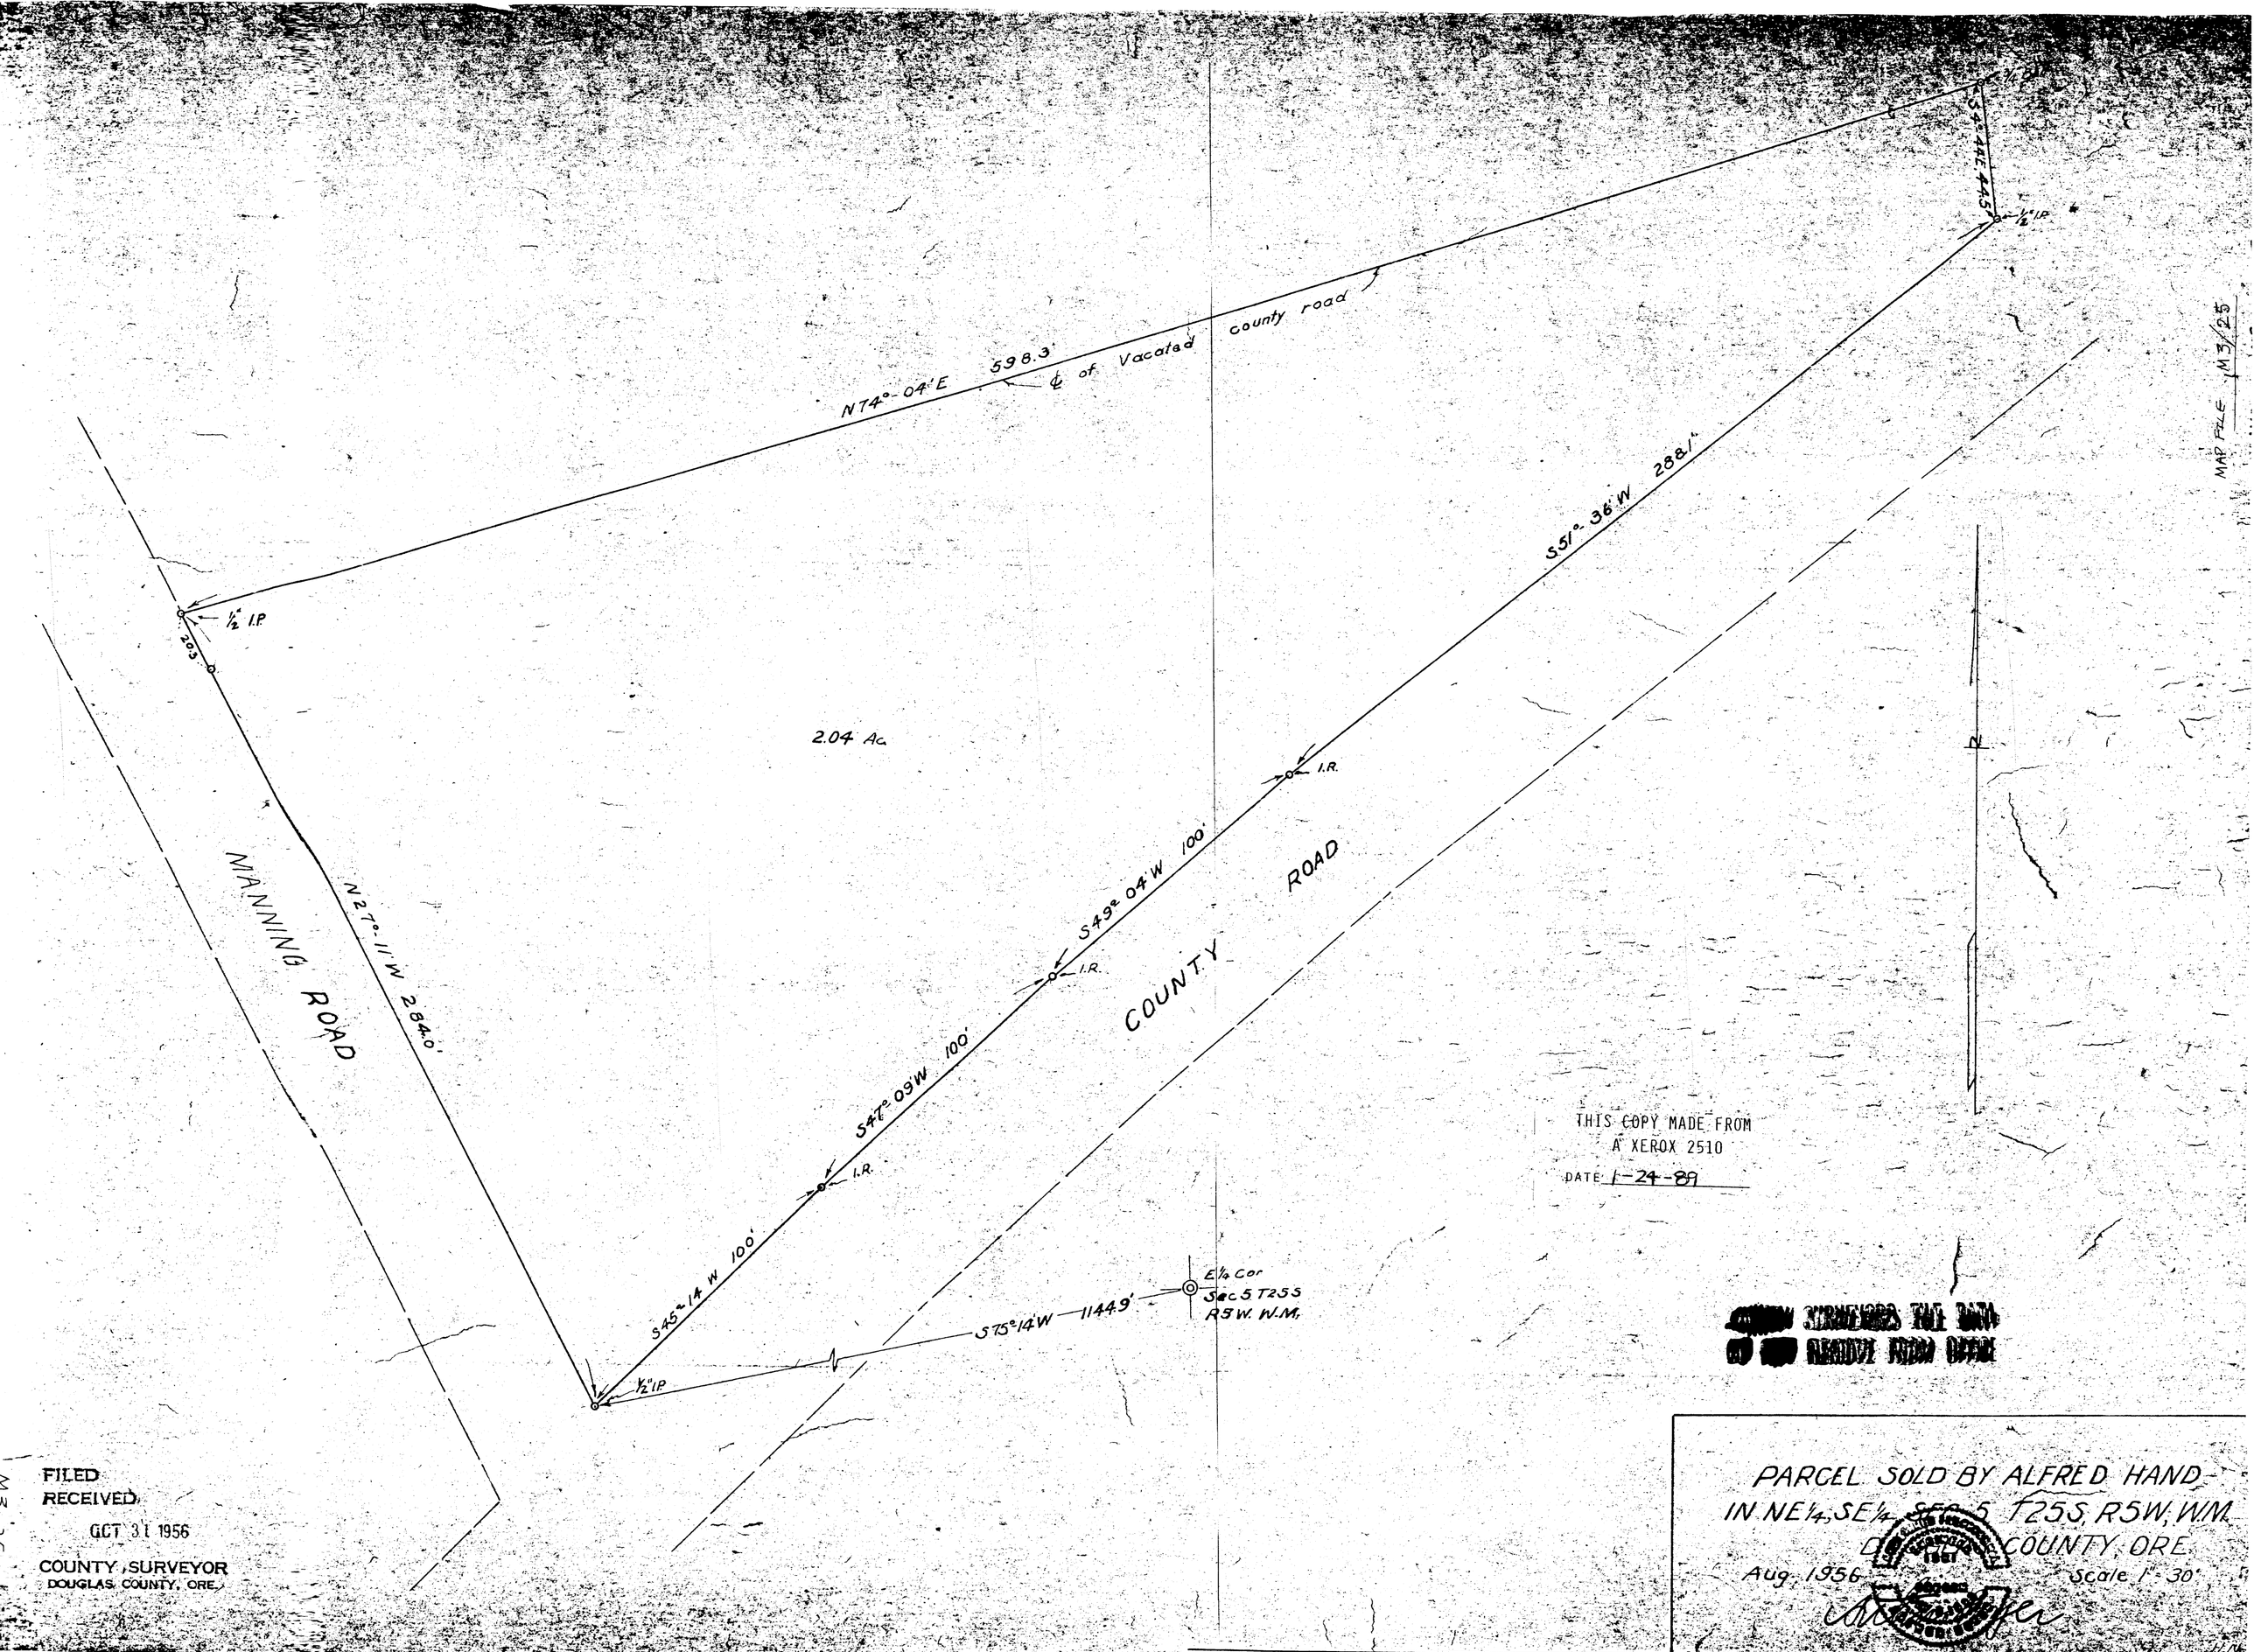

THIS COPY MADE FROM
A XEROX 2510
DATE 1-24-89

[redacted]

PARCEL SOLD BY ALFRED HAND-
IN NE¼, SE¼ SEC 5 T25S, R5W, W.M.
DOUGLAS COUNTY, ORE.
Aug. 1956 Scale 1" = 30'

FILED
RECEIVED
OCT 31 1956
COUNTY SURVEYOR
DOUGLAS COUNTY, ORE.