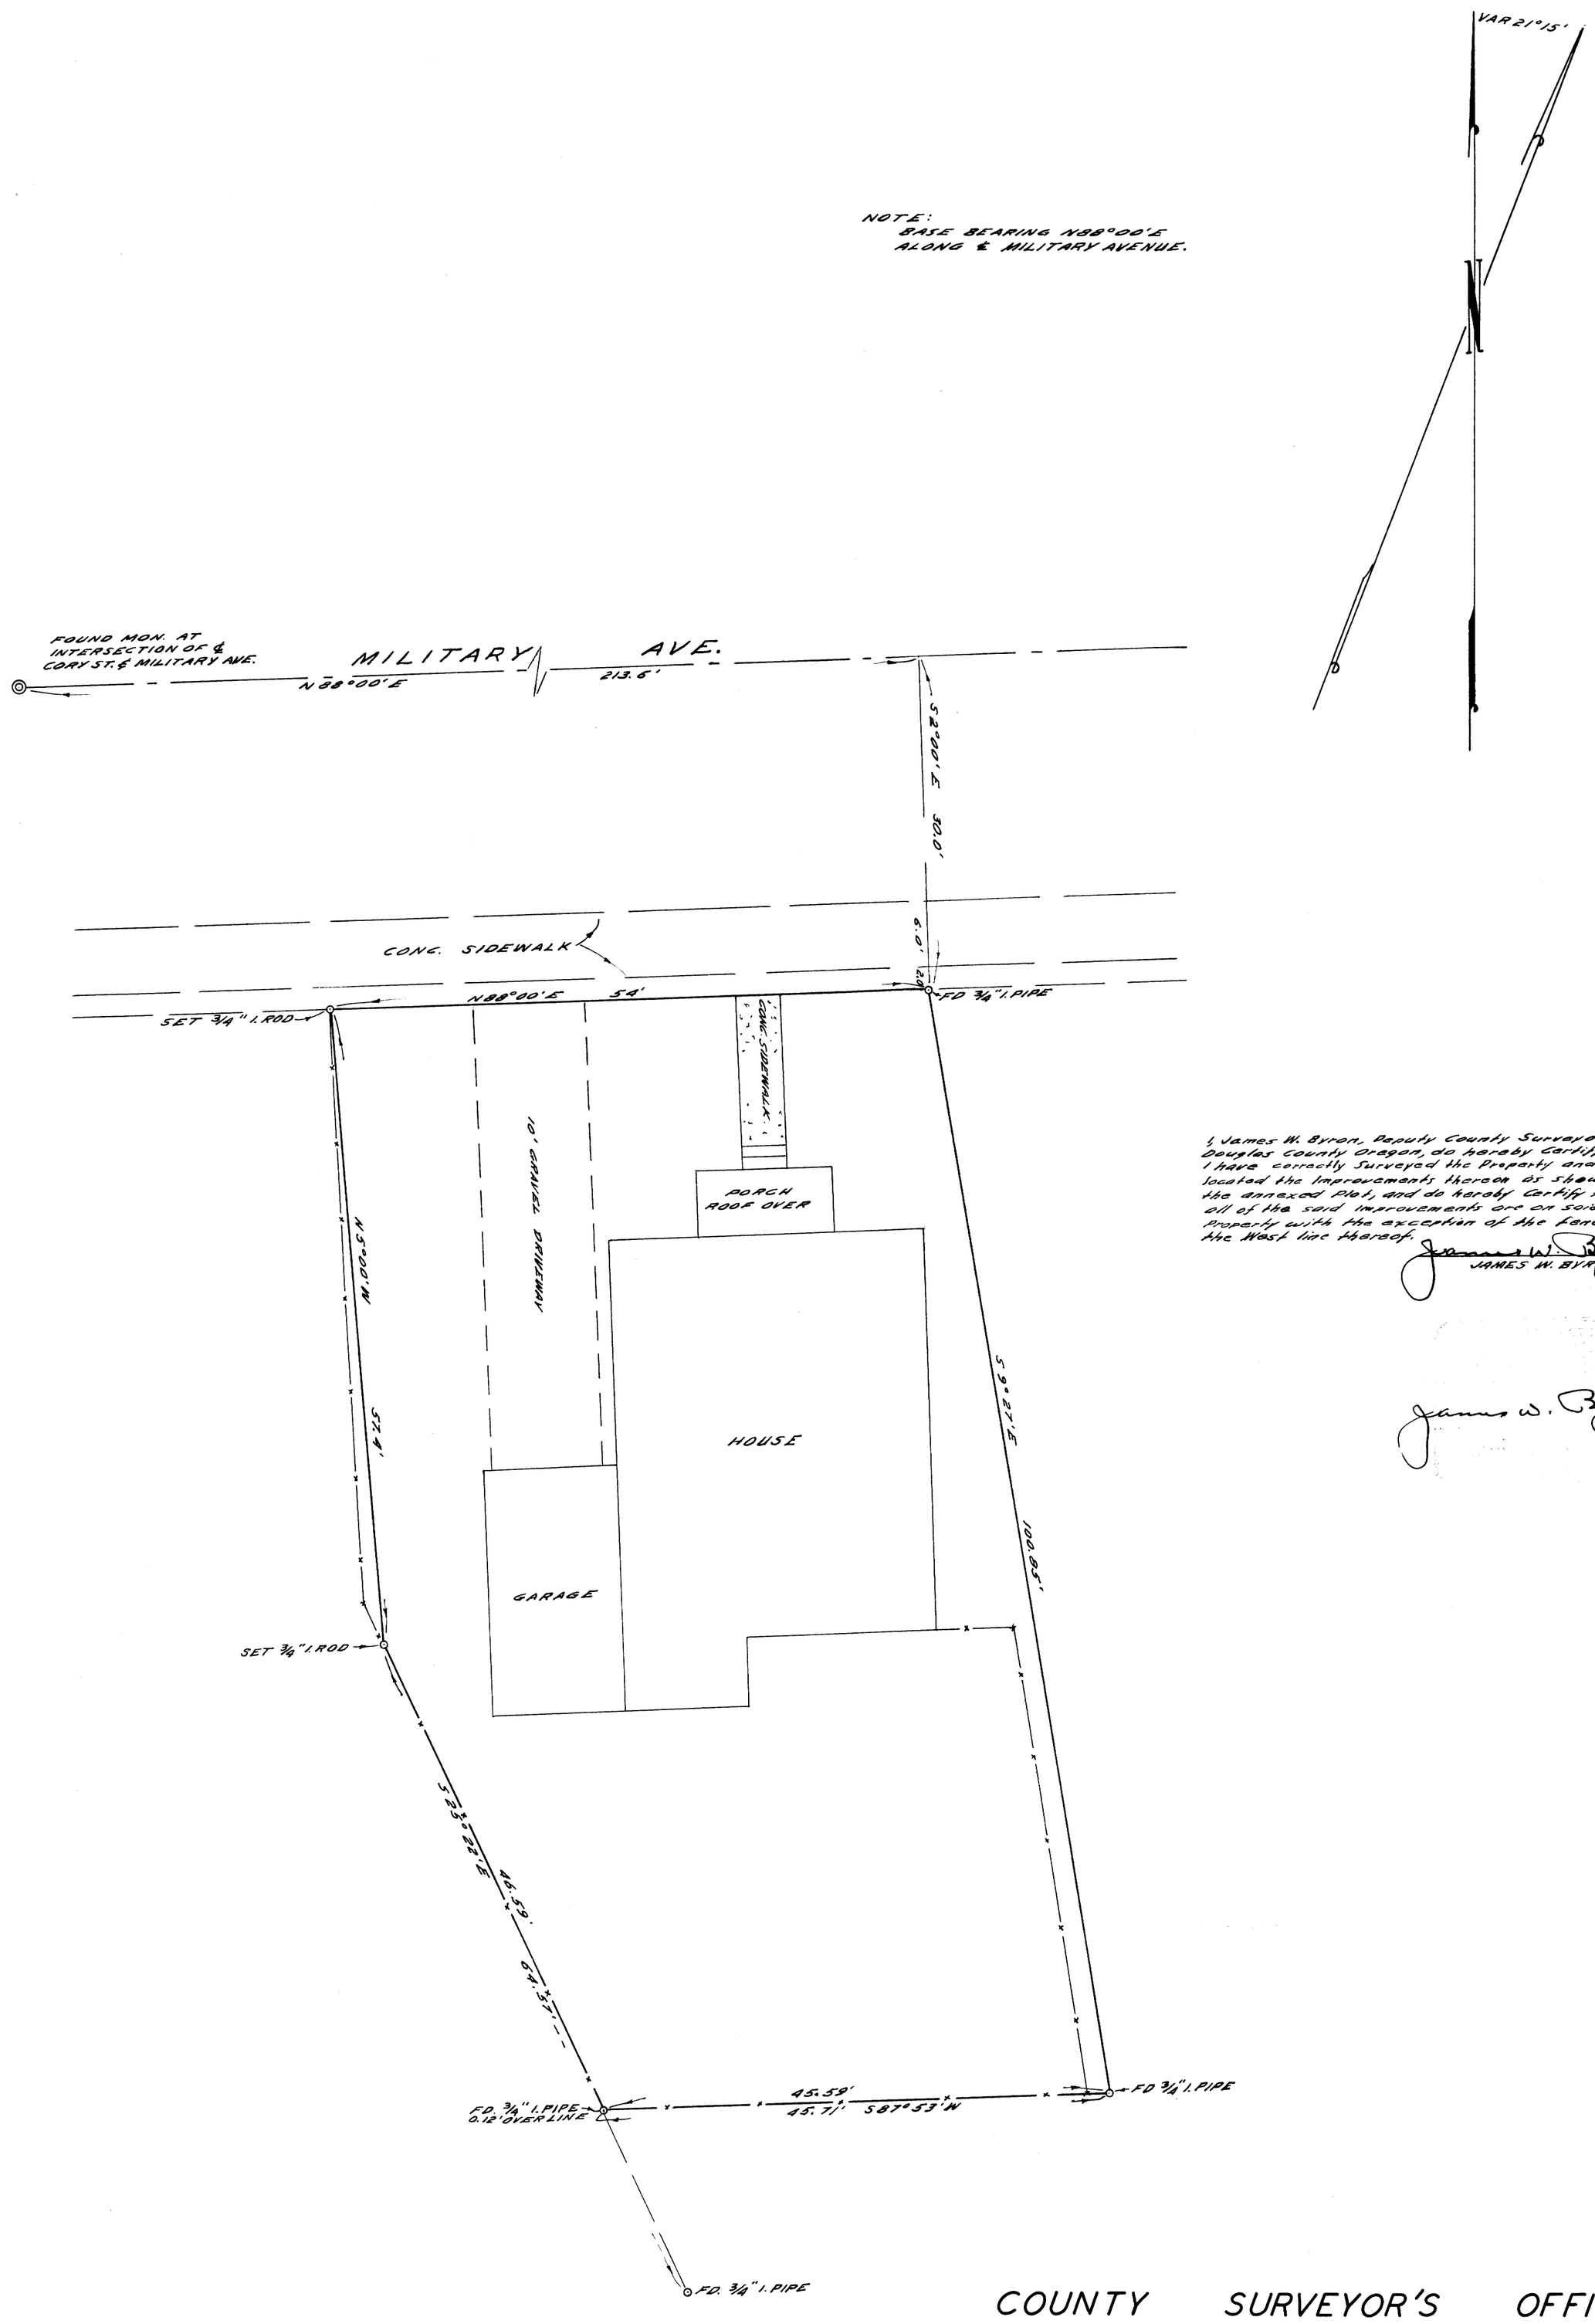

I, James W. Byron, Deputy County Surveyor for Douglas County Oregon, do hereby Certify that I have correctly Surveyed the Property and located the Improvements thereon as shown on the annexed Plat, and do hereby Certify that all of the said Improvements are on said Property with the exception of the fence along the West line thereof.

James W. Byron
JAMES W. BYRON

James W. Byron

COUNTY SURVEYOR'S OFFICE
DOUGLAS COUNTY, OREGON

SURVEY TO ESTABLISH PROPERTY LINES
AND IMPROVEMENTS
SECTION 24 T27S, R.6W., W.M.

FRED M. DARBY COUNTY SURVEYOR
SURVEYED NOV. 20, 1956 BY
JAMES W. BYRON - DEPUTY SCALE 1" = 10'
SURVEYED FOR LEE JONES

REGISTERED
OREGON
LAND SURVEYOR
James W. Byron
REGISTERED
JAMES W. BYRON
303

COUNTY SURVEYORS FILE DATA
DO NOT REMOVE FROM OFFICE

C.S. FILE 47/130
M3-31