SURVEYORS FILE MAP
DO NOT REMOVE FROM OFFICE

MAP
OF
PORTION OF C.E. BOWMAN PROPERTY
SEC. 22, T 28 S, R 6 W, W.M.
SURVEYED DECEMBER 1956.
SCALE — 1-inch = 100 ft.

FILED
RECEIVED
DEC 11 1956
COUNTY SURVEYOR
DOUGLAS COUNTY, ORE.

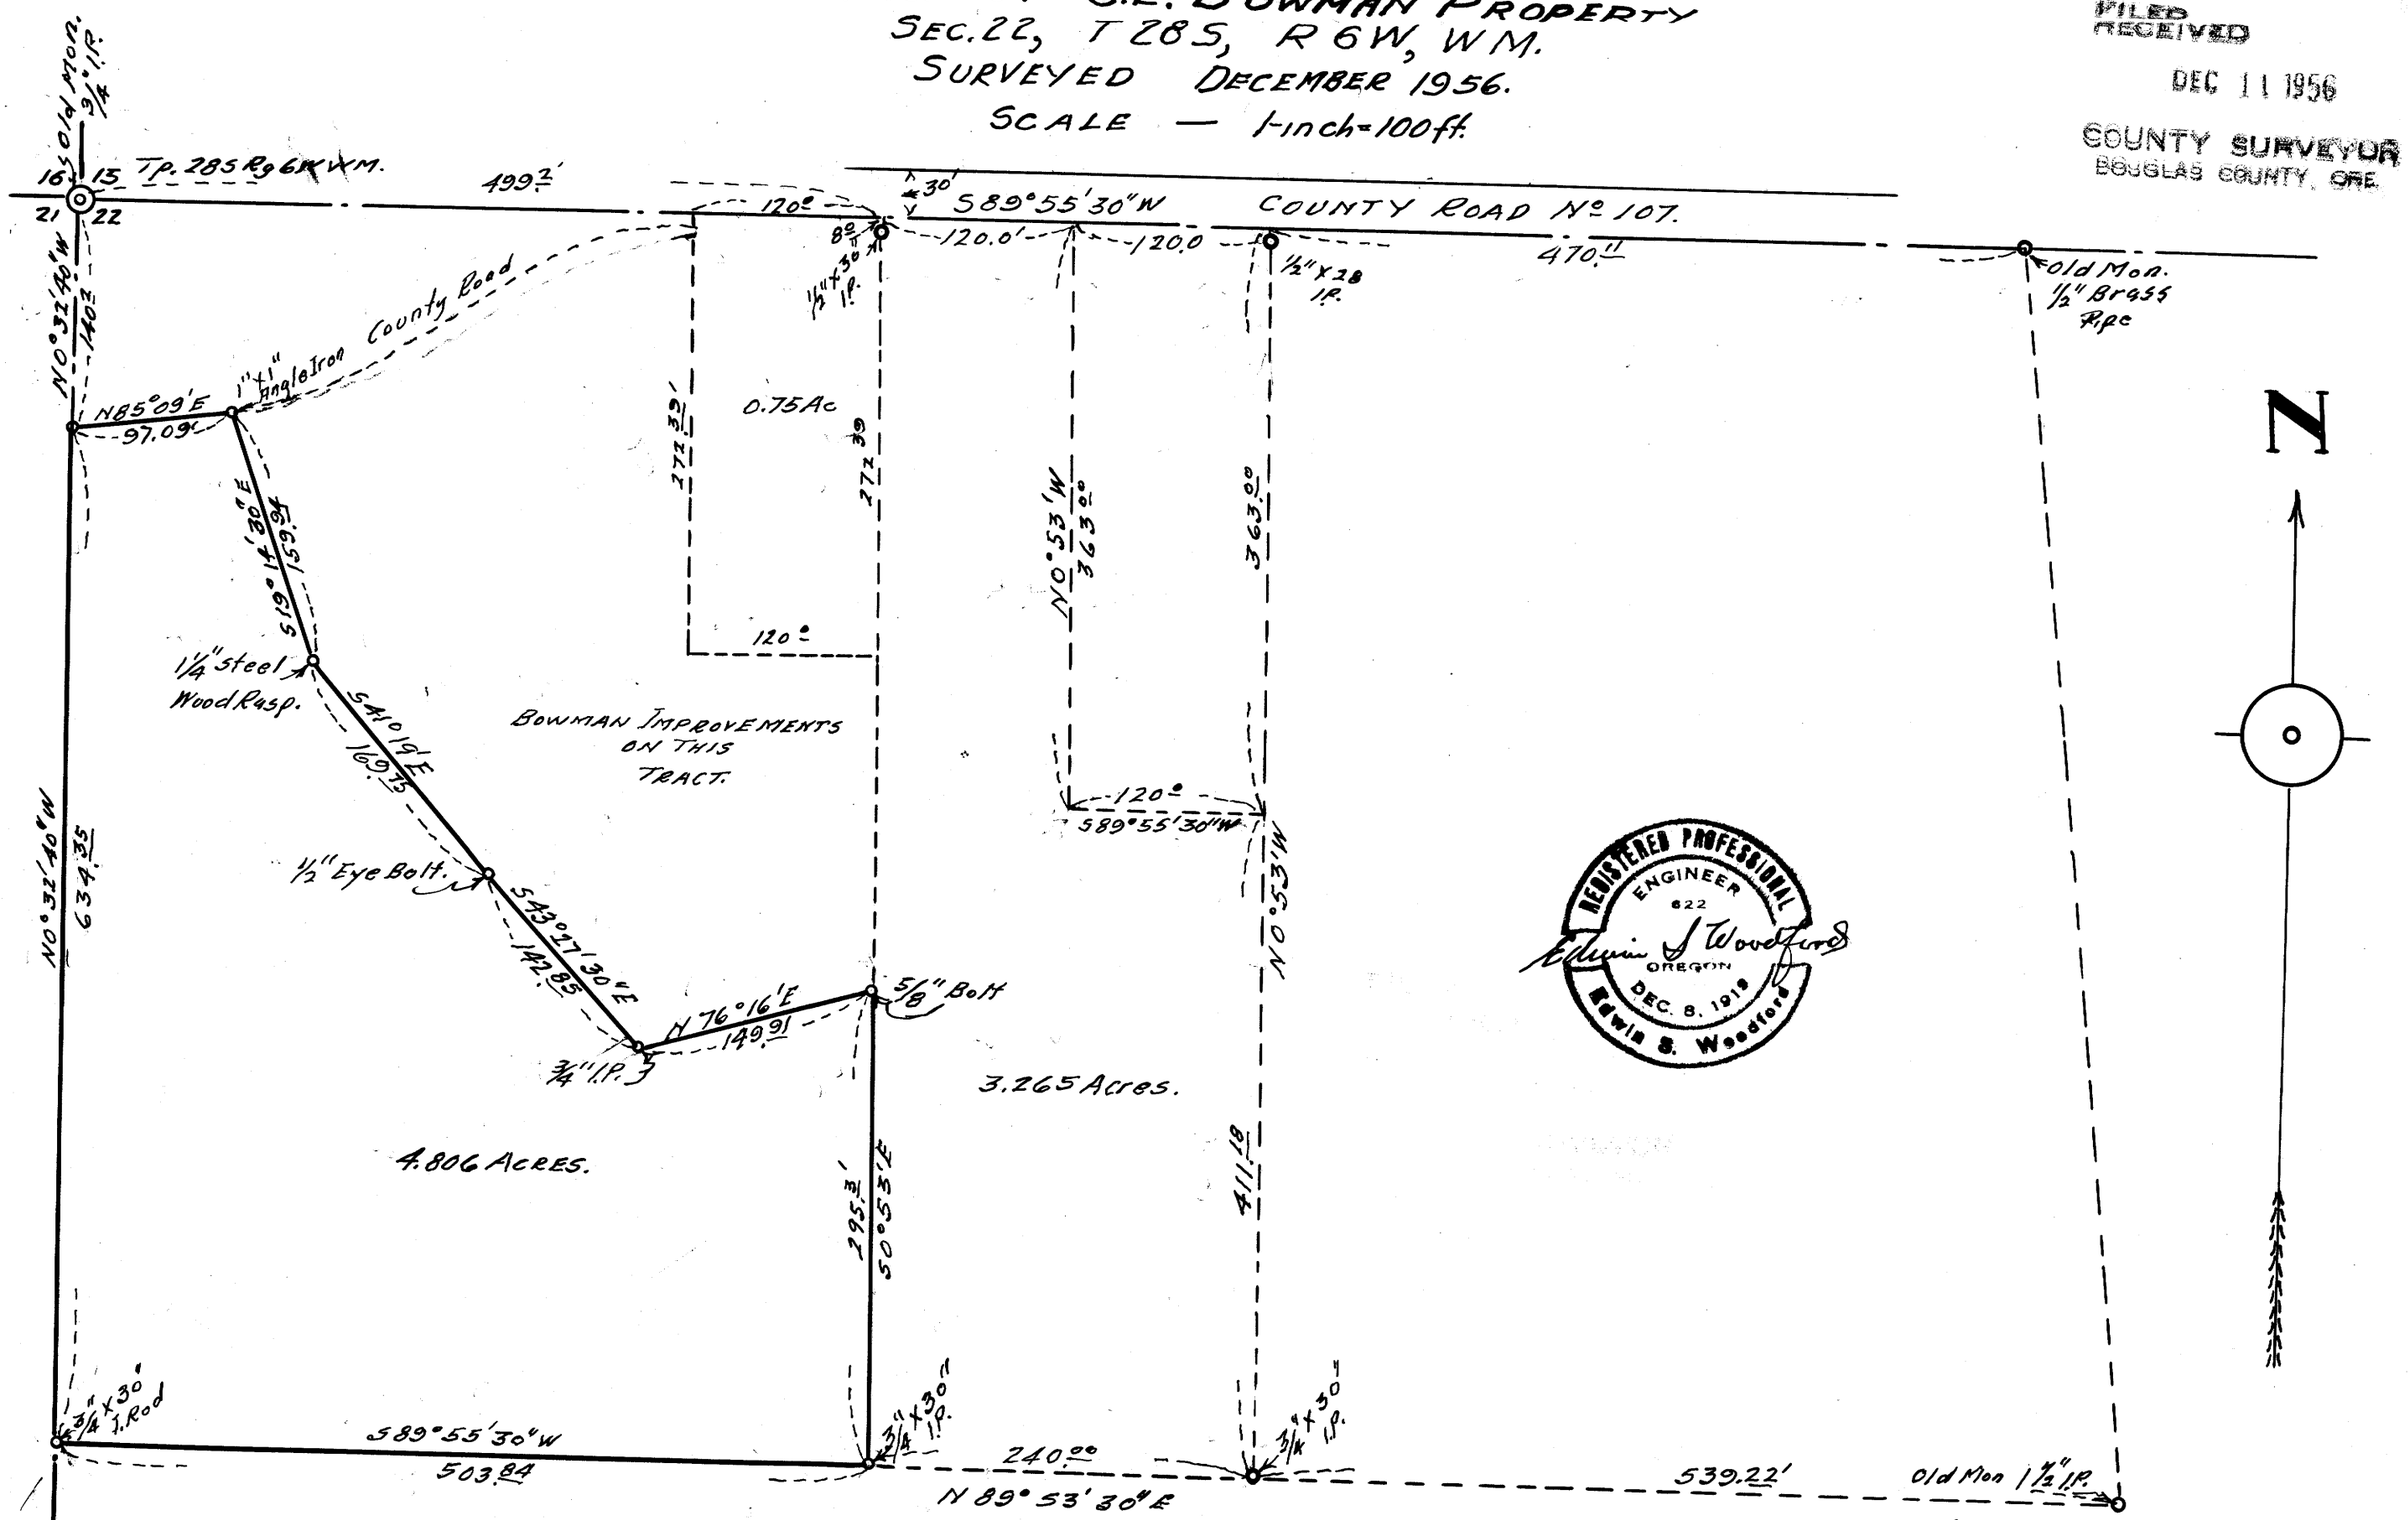

REGISTERED PROFESSIONAL ENGINEER 622 OREGON DEC. 8, 1919 Edwin S. Woodford

Edwin S. Woodford

C. S. File No. 42/202-1

MAP FILE M3 / 44

FILED
RECEIVED
JUN
COUNTY SURVEYOR
DOUGLAS COUNTY OREGON

MAP
OF
PORTION OF C.E. BOWMAN PROPERTY
SEC. 22, T 28 S, R 6 W, W.M.
SURVEYED: OCTOBER 1947
SCALE — 1-inch = 100 ft.

COUNTY SURVEYORS FILE DATA
DO NOT REMOVE FROM OFFICE

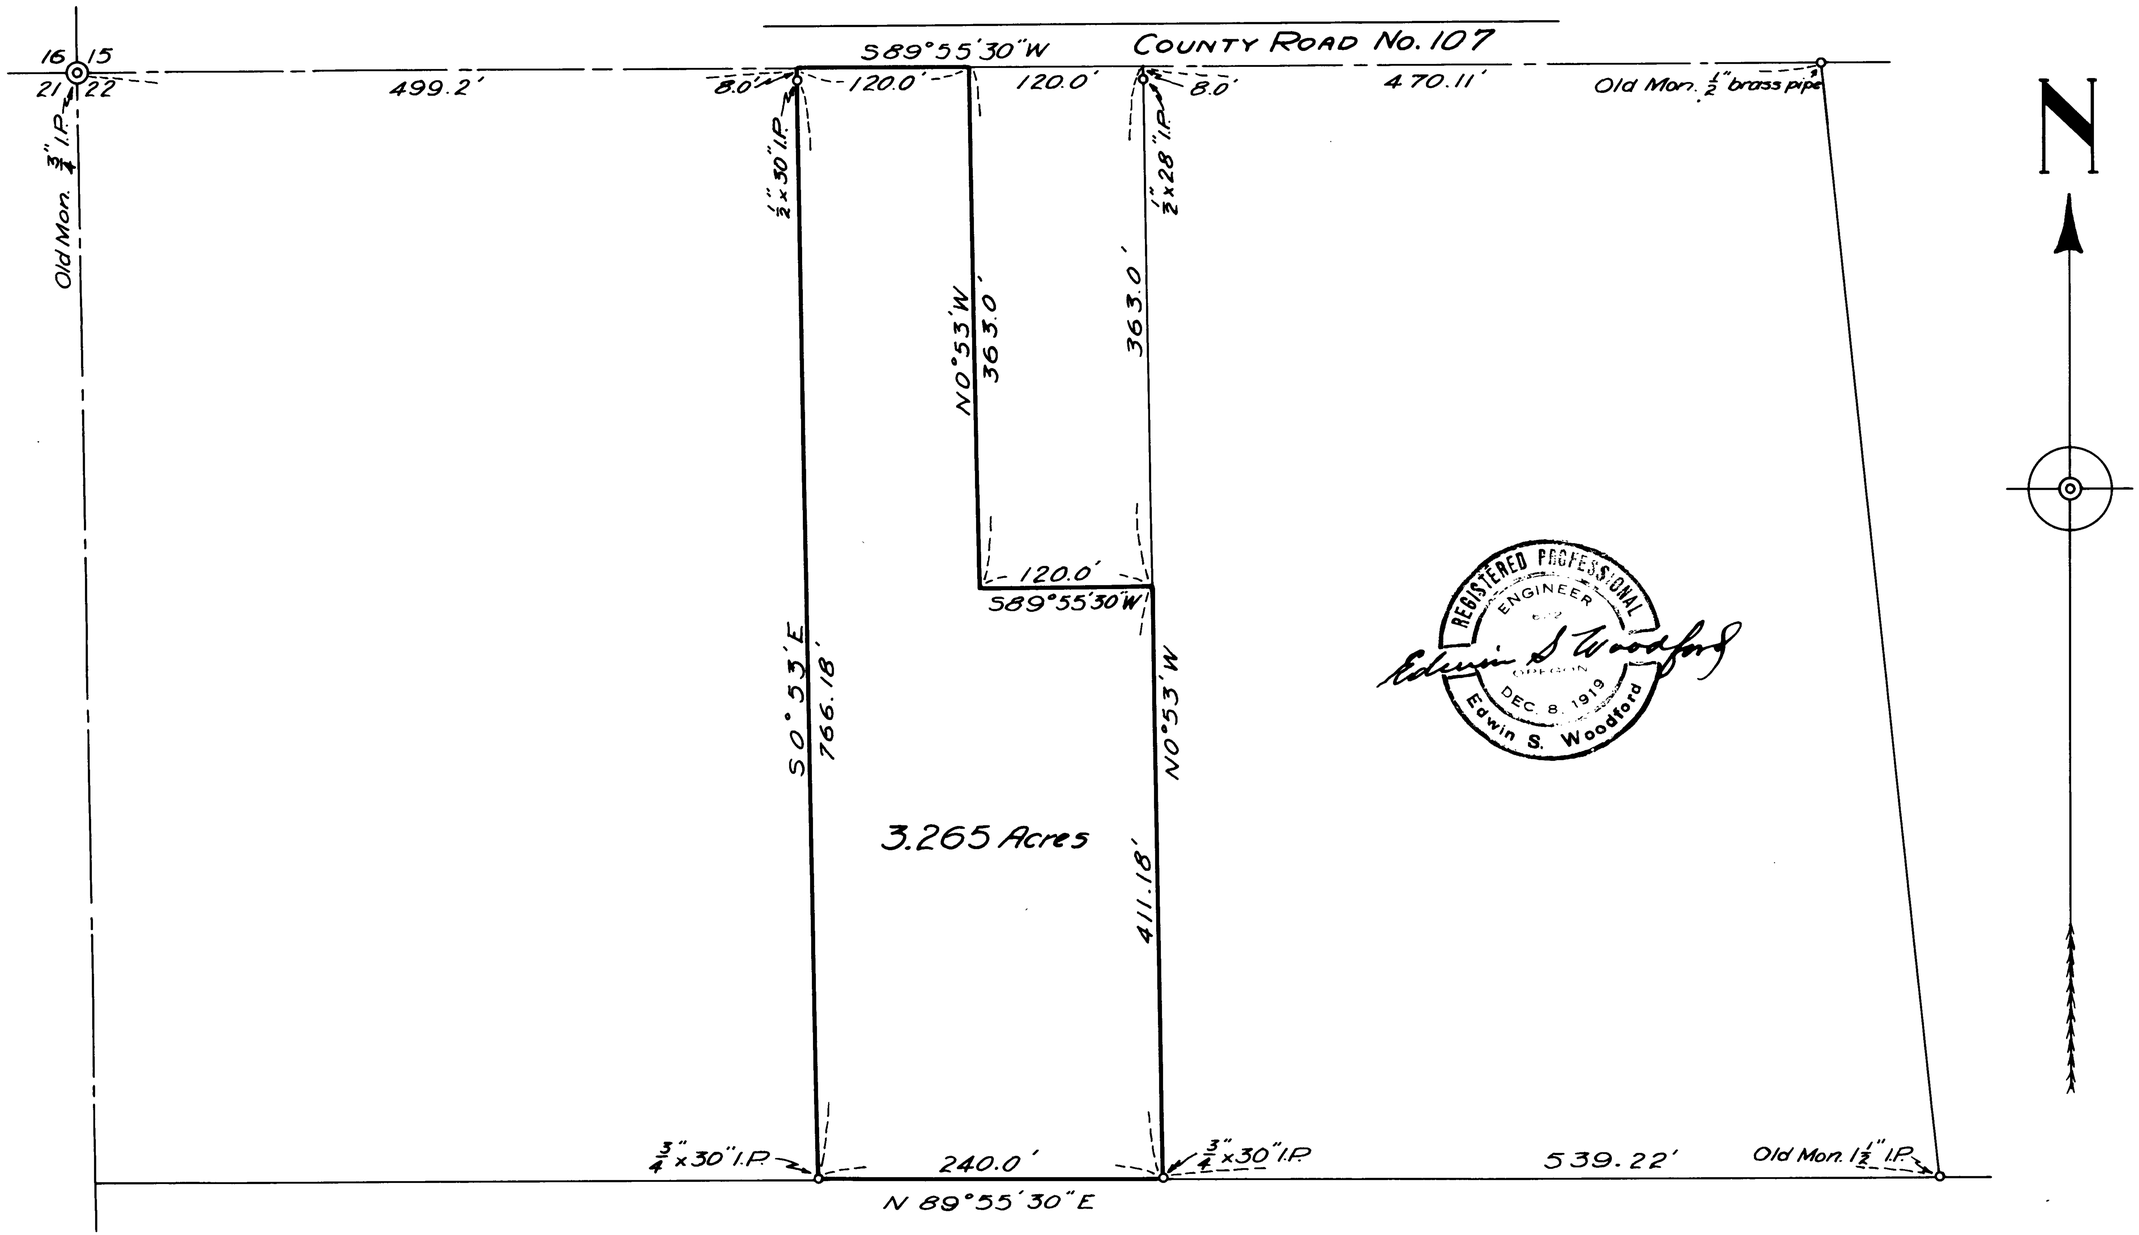

-13-

C.S. FILE 42/202