M 3-48

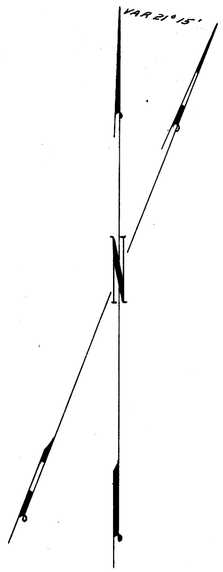

NOTE
BEARINGS SHOWN ARE TRUE, BASED ON A SOLAR OBSERVATION S&E C.S. FILE 47/123

BRASS CAPS AT CORNERS MKD. "COUNTY SURVEYORS OFFICE 1956 DOUGLAS COUNTY COR 1 T04" AS SHOWN.

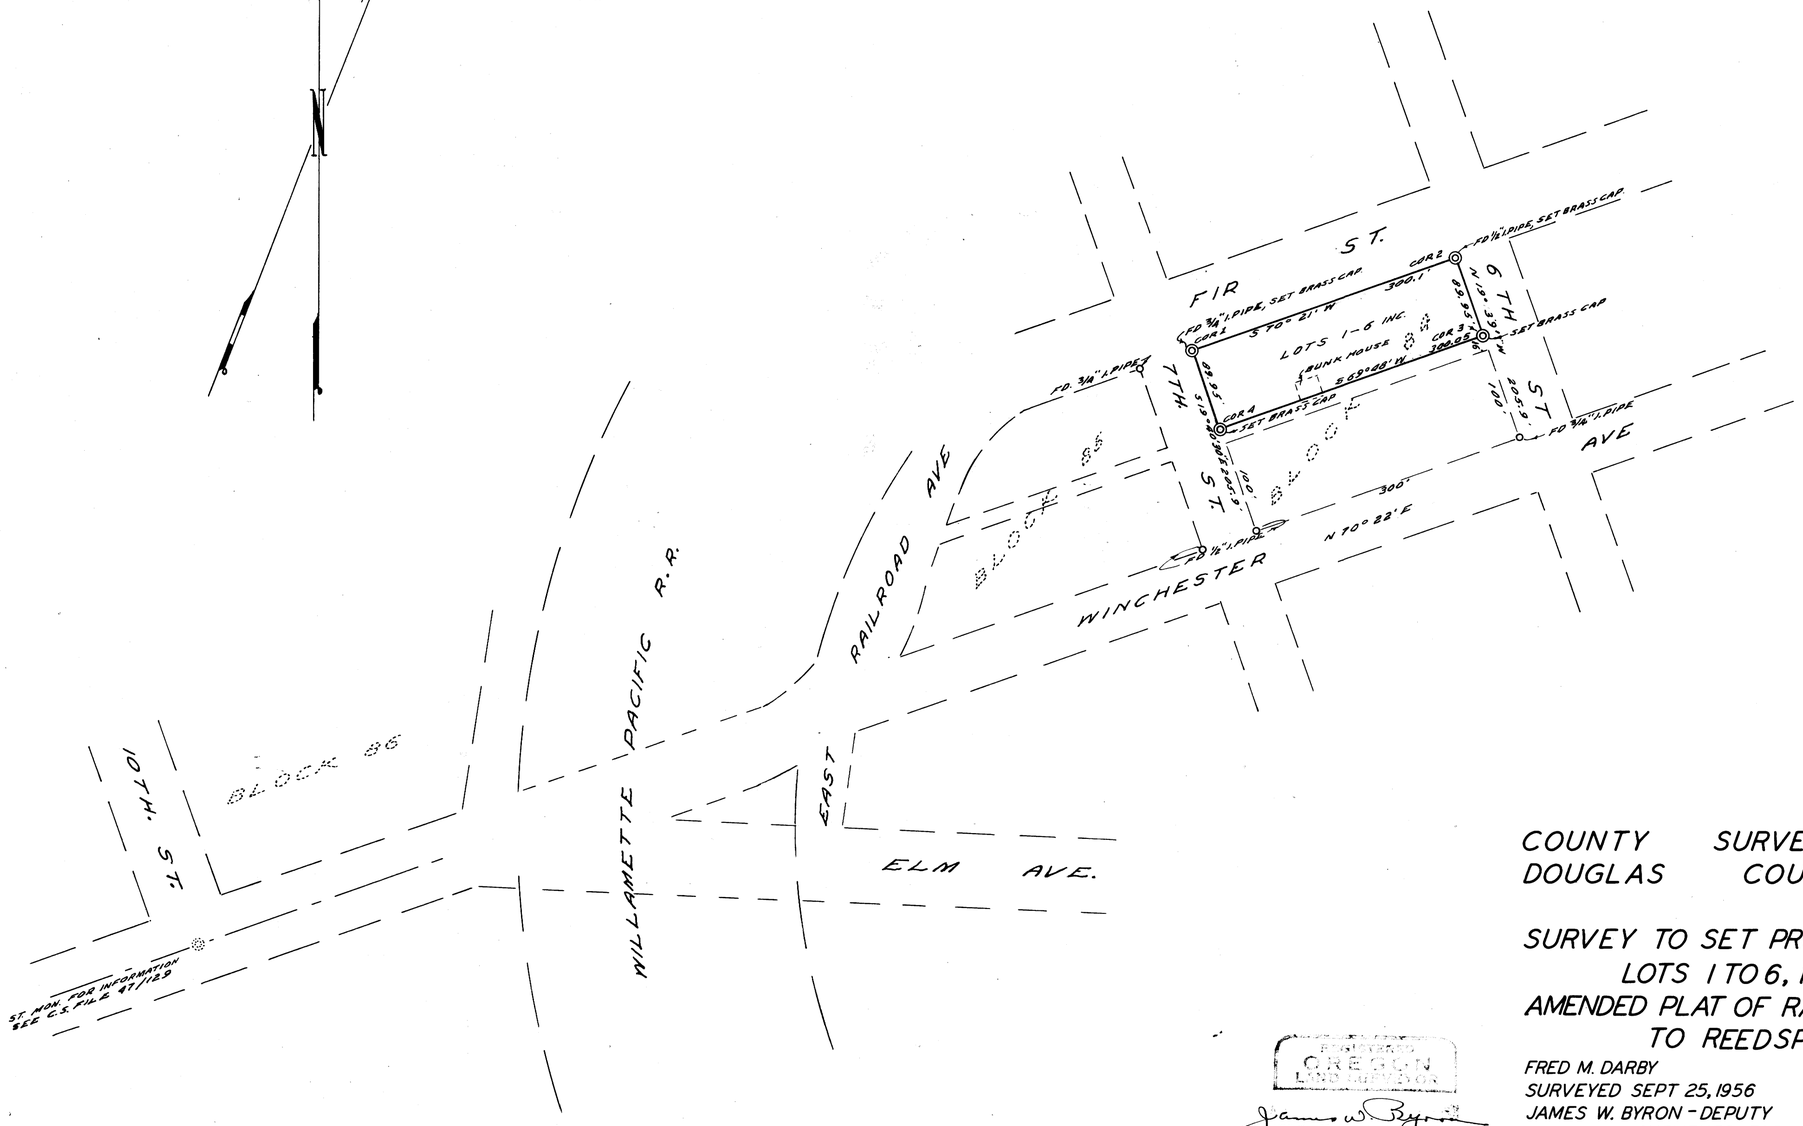

COUNTY SURVEYOR'S OFFICE
DOUGLAS COUNTY, OREGON

SURVEY TO SET PROPERTY CORNERS
LOTS 1 TO 6, INC. BLOCK 84
AMENDED PLAT OF RAILROAD ADDITION
TO REEDSPORT

FRED M. DARBY — COUNTY SURVEYOR
SURVEYED SEPT 25, 1956 — BY
JAMES W. BYRON - DEPUTY — SCALE 1" = 100'
SURVEYED FOR DOUGLAS COUNTY

REGISTERED OREGON LAND SURVEYOR
James W. Byron
SURVEYOR

COUNTY SURVEYORS FILE DATA
DO NOT REMOVE FROM OFFICE

MAP FILE M. 3. - 48...

T. 21-12 SW SW ¼ SEC. 35

C.S. FILE 47/144
M 3-48 P