COUNTY SURVEYORS FILE DATA
DO NOT REMOVE FROM OFFICE

SURVEY FOR DEED DESCRIPTION
SW¼NW¼, SEC. 28, T 24S, R 6W, W.M.
DOUGLAS COUNTY, OREGON

SURVEYED FOR: JOSEPH HUNT
SURVEYED BY: G. ROBERT LECKLIDER, ENG'R.
DECEMBER, 1956 SCALE: 1" = 50 FT.

● DENOTES: IRON RODS FOUND
○ DENOTES: IRON PIPES SET

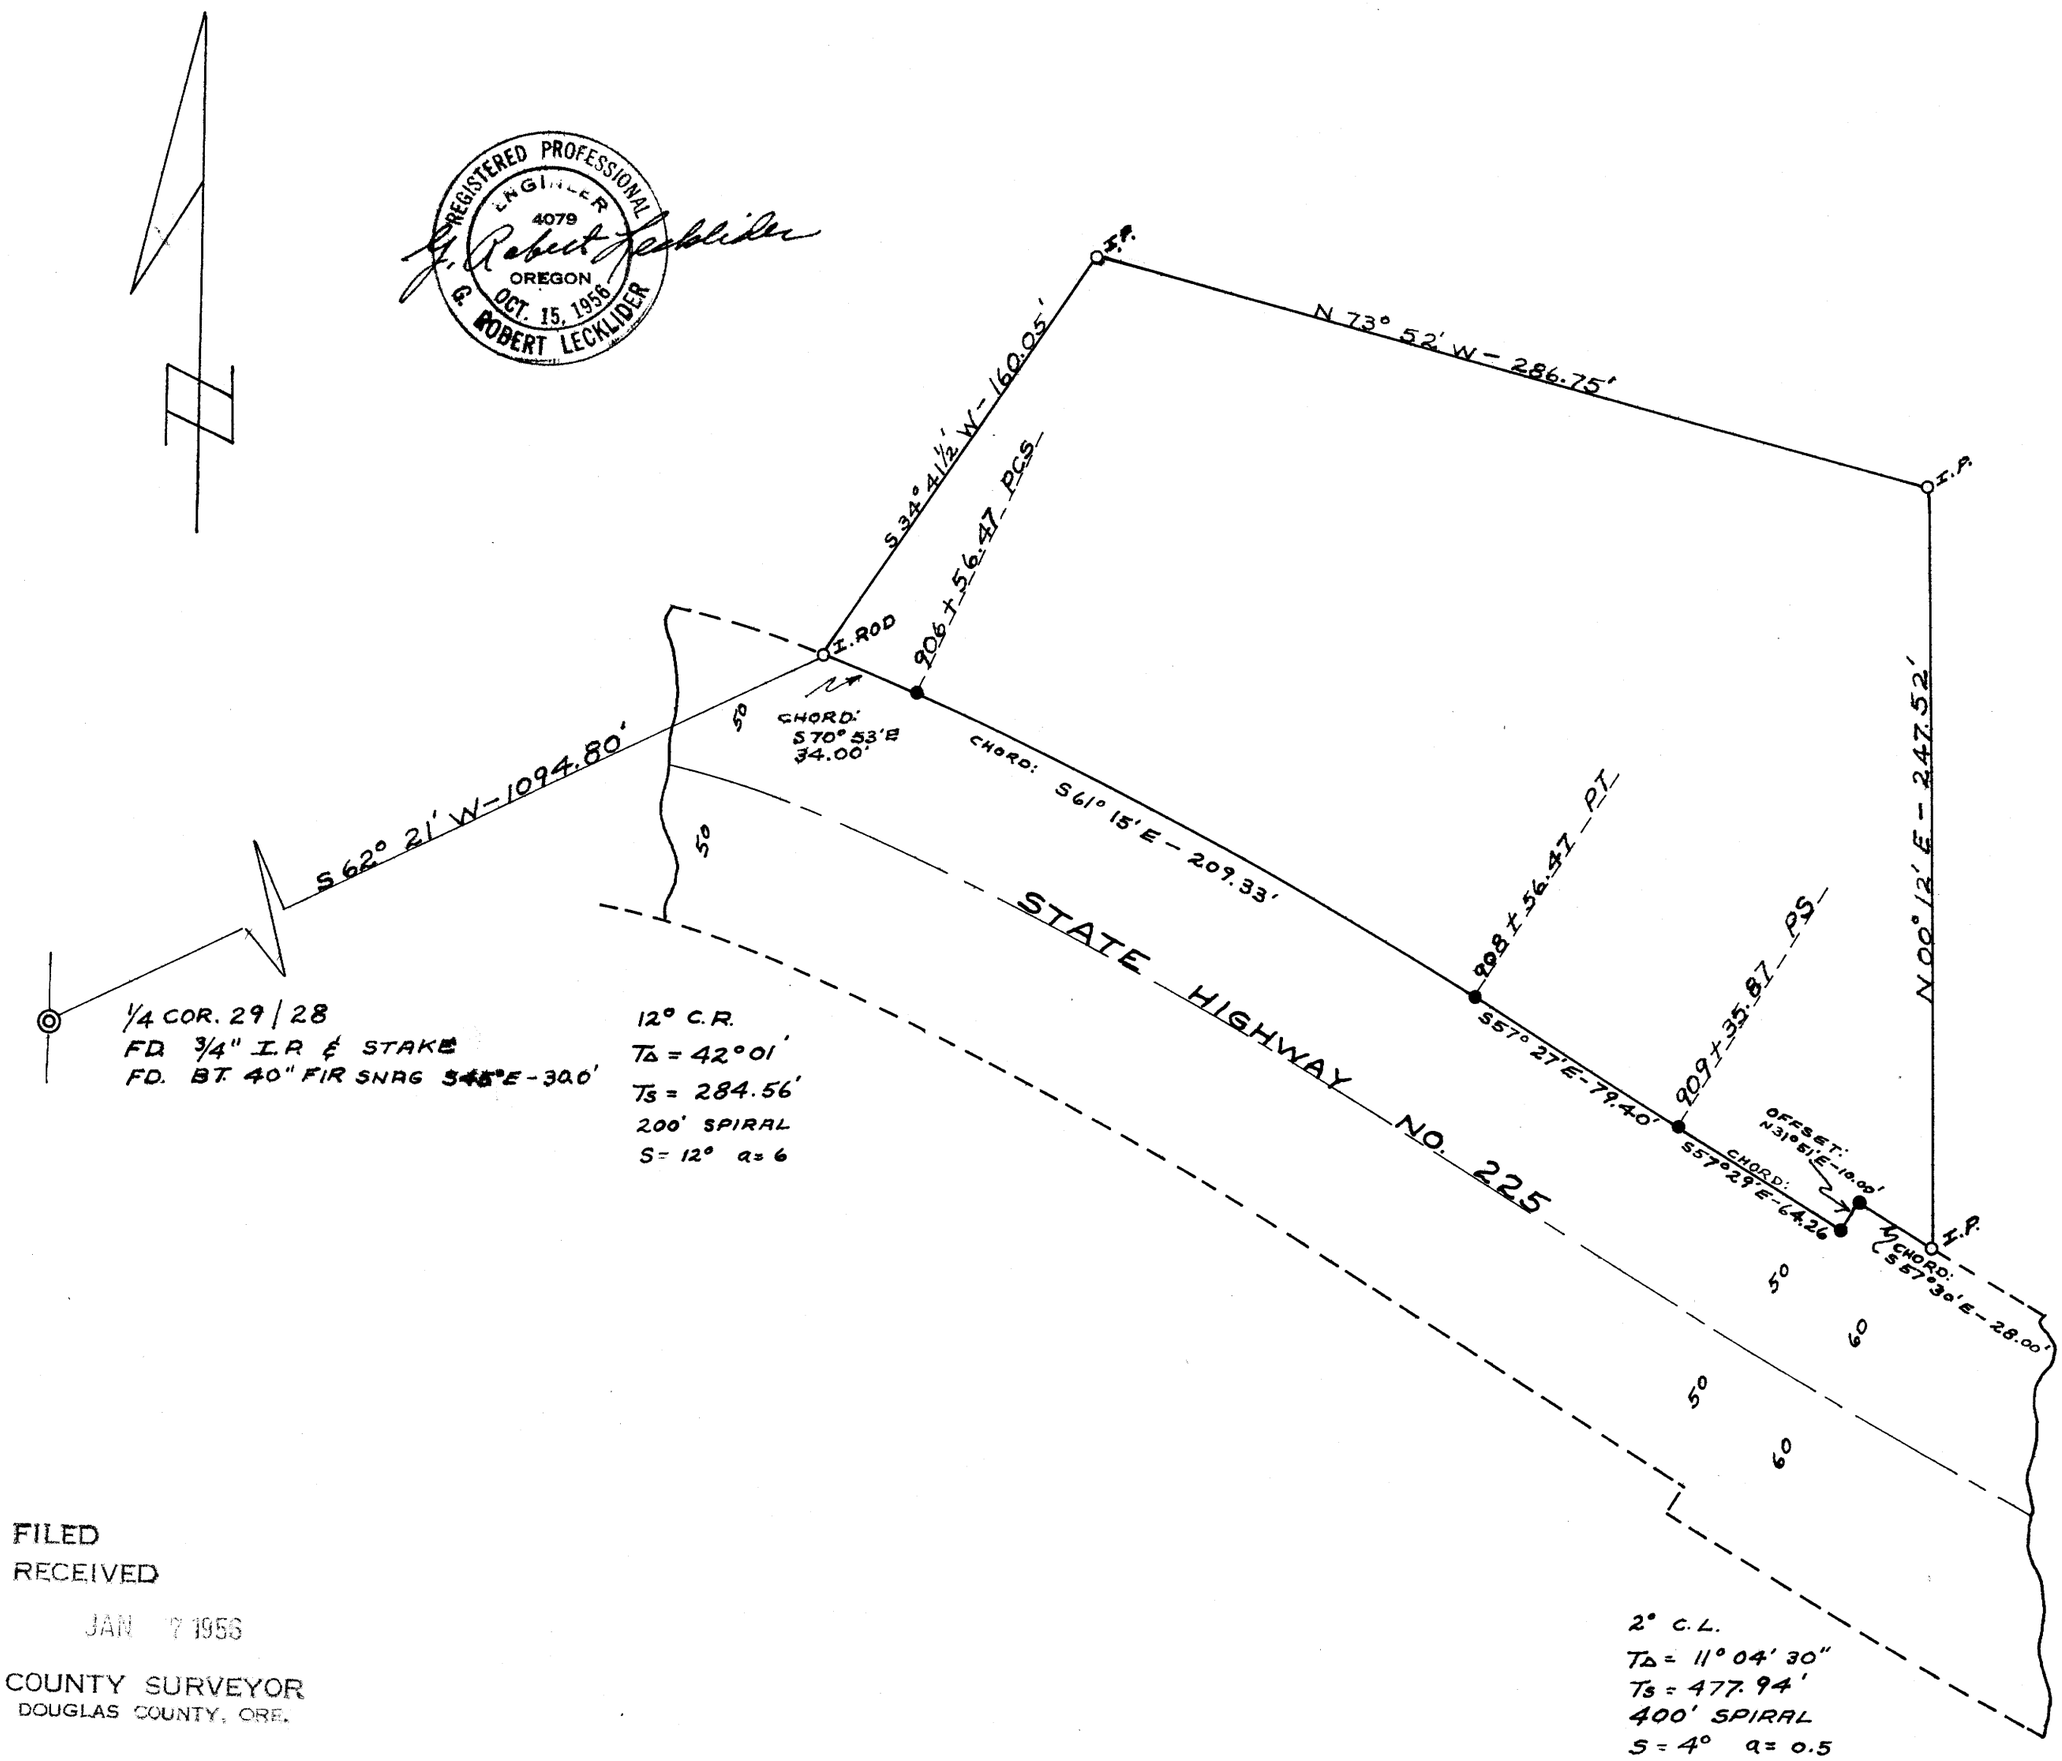

FILED
RECEIVED
JAN 7 1956
COUNTY SURVEYOR
DOUGLAS COUNTY, ORE.

MAP FILE M3 / 50

1