


C. S. File No. 36/29

MAP FILE M3 157

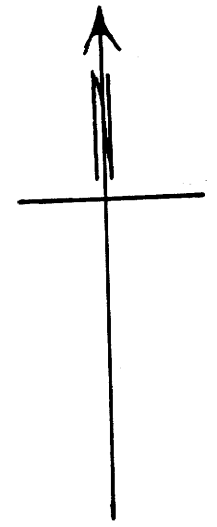

1/4 Sec Cor.  
W. Side Sec 19  
T. 29 S.; R. 4 W.

30° 24' W. 1198'

Section Line  
N 0° 24' E 402.2'

S 88° 34' E 1058.3' 10/84 d.h.  
N. LINE HUGH CARSON DONATION LAND CLAIM NO. 5Q 42

T. J. Bowman

Fence  
"West 25.25 Chs. from NE Cor Hugh Carson D.L.C." a/c Deed  
Vol. 80/Pg 11, Eugene Maulding to F. A. Warner.  
West on N. Line Donation L.N.A. Clm. 19.65 Chs a/c Deed  
of C Sellers et ux to G. A. Dillon Vol. 64 Pg. 78-9  
West 58 Chs  
a/c Deed  
V64/Pg. 78-9

NE Corner  
Hugh Carson D.L.C. 50  
10/84 d.h.  
42

N 62° 04' E 265'  
N. Line of oldest County Road

N 77° 26' E 100'  
Meander of County Road

S 4° 48' E 35 1/2 Chs a/c 80/11

S 85° E 725.6'  
N 84 1/2° W. a/c 80/11  
S. Myrtle Cr. Road

N. Line County Road  
Center Road

N 1° 22' E 294.7'  
South 47 Chs. a/c 80/11 & 64/78-9

S 87° E 9.9 Chs. to W. End Bridge over Carson Cr a/c V64/P 78-9

**COUNTY SURVEYORS FILE DATA  
DO NOT REMOVE FROM OFFICE**

COUNTY SURVEYOR'S OFFICE - ROSEBURG, ORE.  
PORTION OF T. J. BOWMAN RANCH, S. MYRTLE CR.,  
LYING NORTH OF MEANDER OF COUNTY ROAD IN  
SEC. 19, T. 29 S.; R. 4 W.; W. M.; DOUGLAS COUNTY, ORE.  
MAY 1942 BOYER, DEP. SCALE, 1" = 100 FT.