C. S. File No. 42/222
MAP FILE M4 / 12

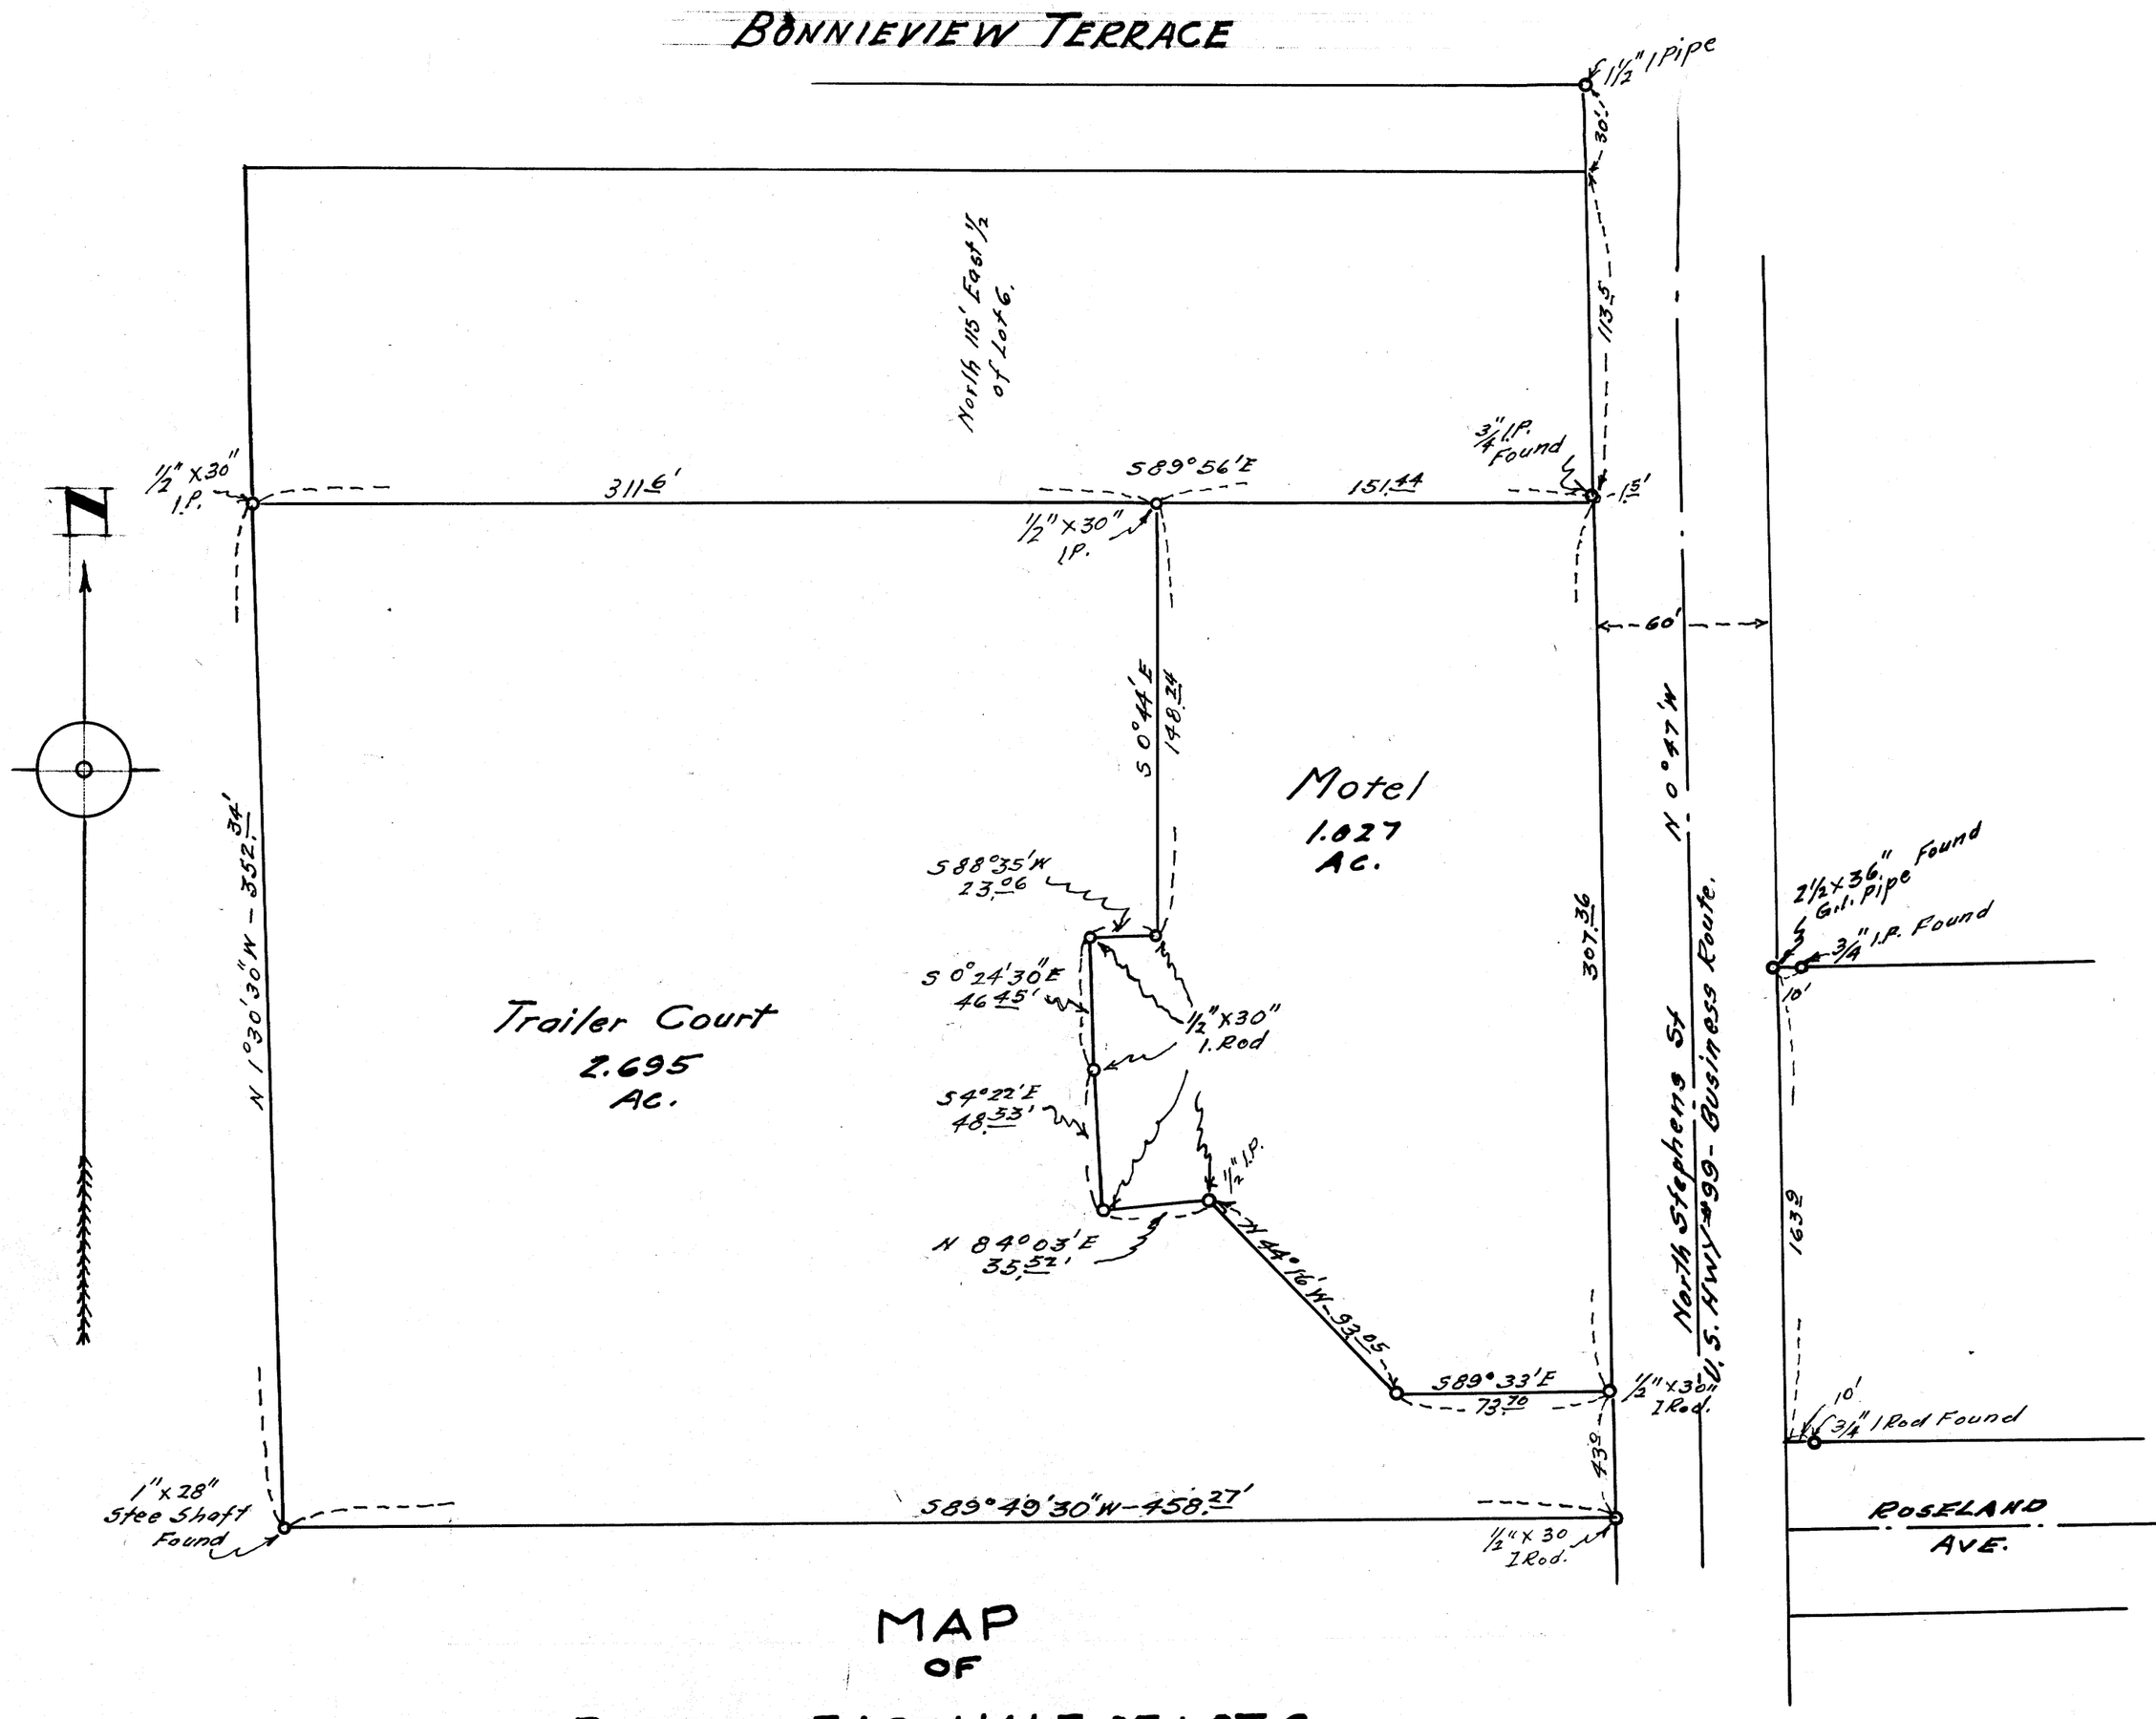

MAP
OF
PART OF EAST HALF OF LOT-6.
OF
FRUITVALE.

TP. 27S - RG. 6W WM.

SCALE - 1" = 50' AUGUST - 1956.

REGISTERED PROFESSIONAL ENGINEER #22 Edwin S. Woodford OREGON DEC. 8, 1919 Edwin S. Woodford

FILED
RECEIVED
JAN 30 1957
COUNTY SURVEYOR
DOUGLAS COUNTY, ORE.

DO NOT REMOVE

C. S. File No. 42/222
MAP FILE M4 / 12