COUNTY SURVEYORS FILE
DO NOT REMOVE FROM FILE

Survey For Deed Description
South Drain

Note: ○ Set lot markers with brass cap inscribed Survey Pt. Wilford N. Haines #239

Bearings taken from survey made by County Surveyor in 1948.

Scale: 1" = 20'

Surveyed Jan. 29-30, 1957

REGISTERED
OREGON
LAND SURVEYOR
Wilford N. Haines
MAY 7, 1948
WILFORD N. HAINES
239

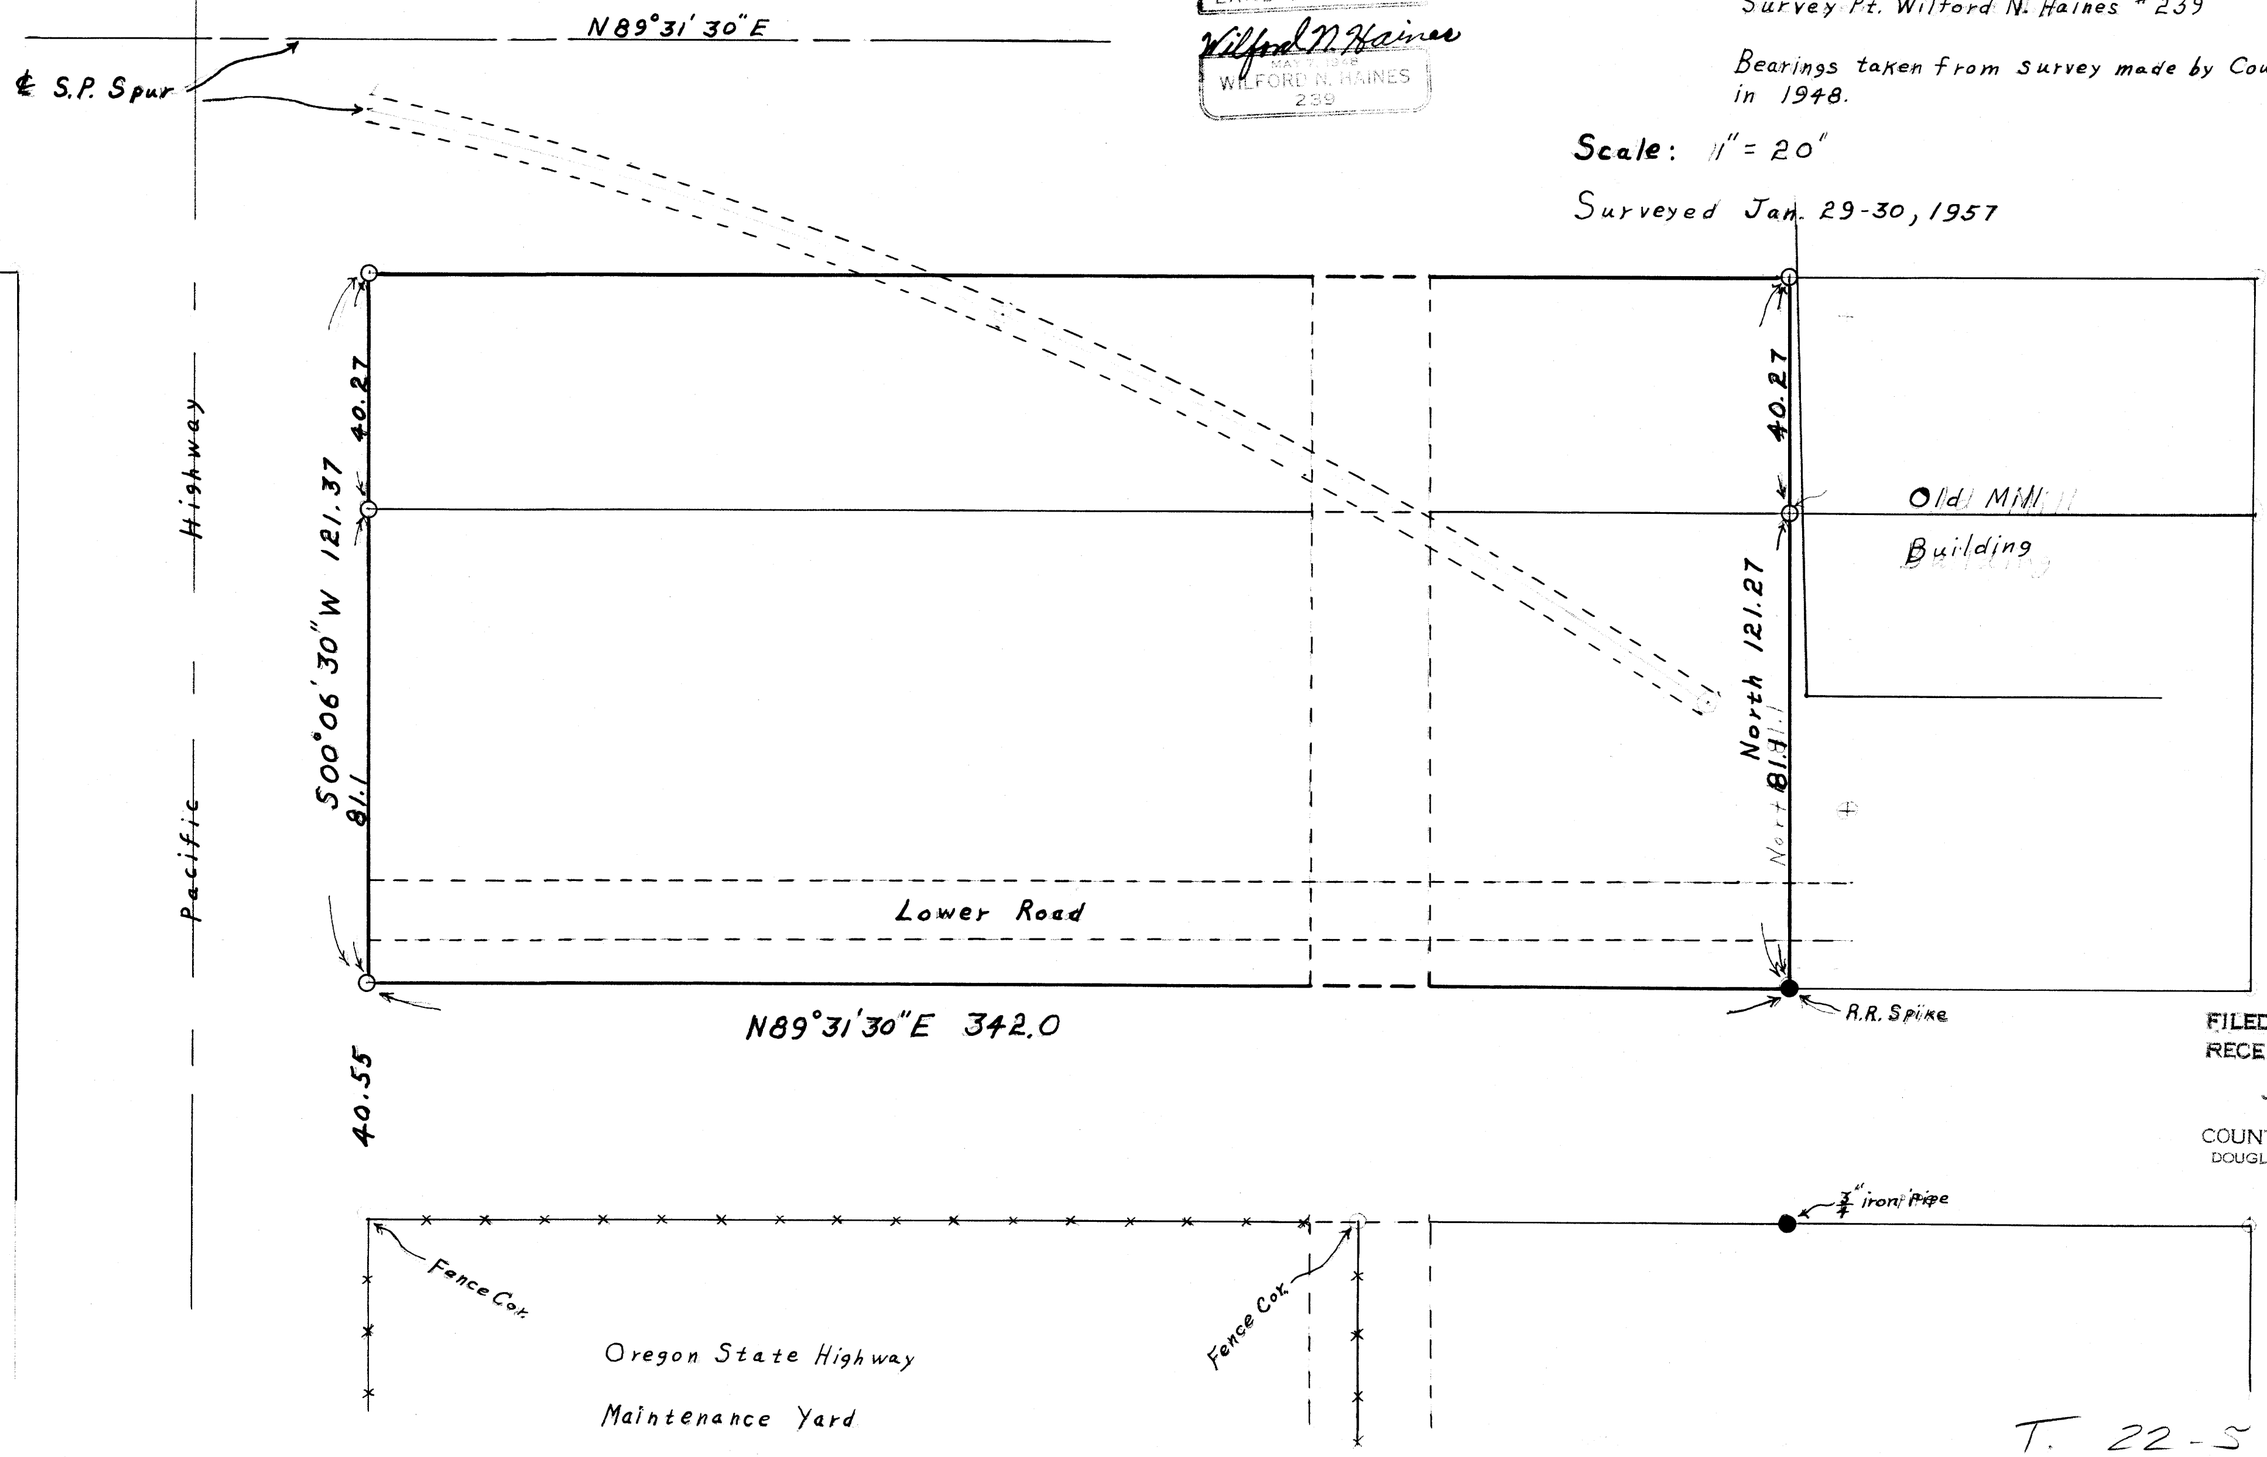

FILED
RECEIVED
JAN 31 1957
COUNTY SURVEYOR
DOUGLAS COUNTY, ORE.

NW of SE ¼
T. 22-S SEC. 17

MAP FILE M4 1 17
MAP FILE M4 1 17