C.S. FILE 87/67
M4-55

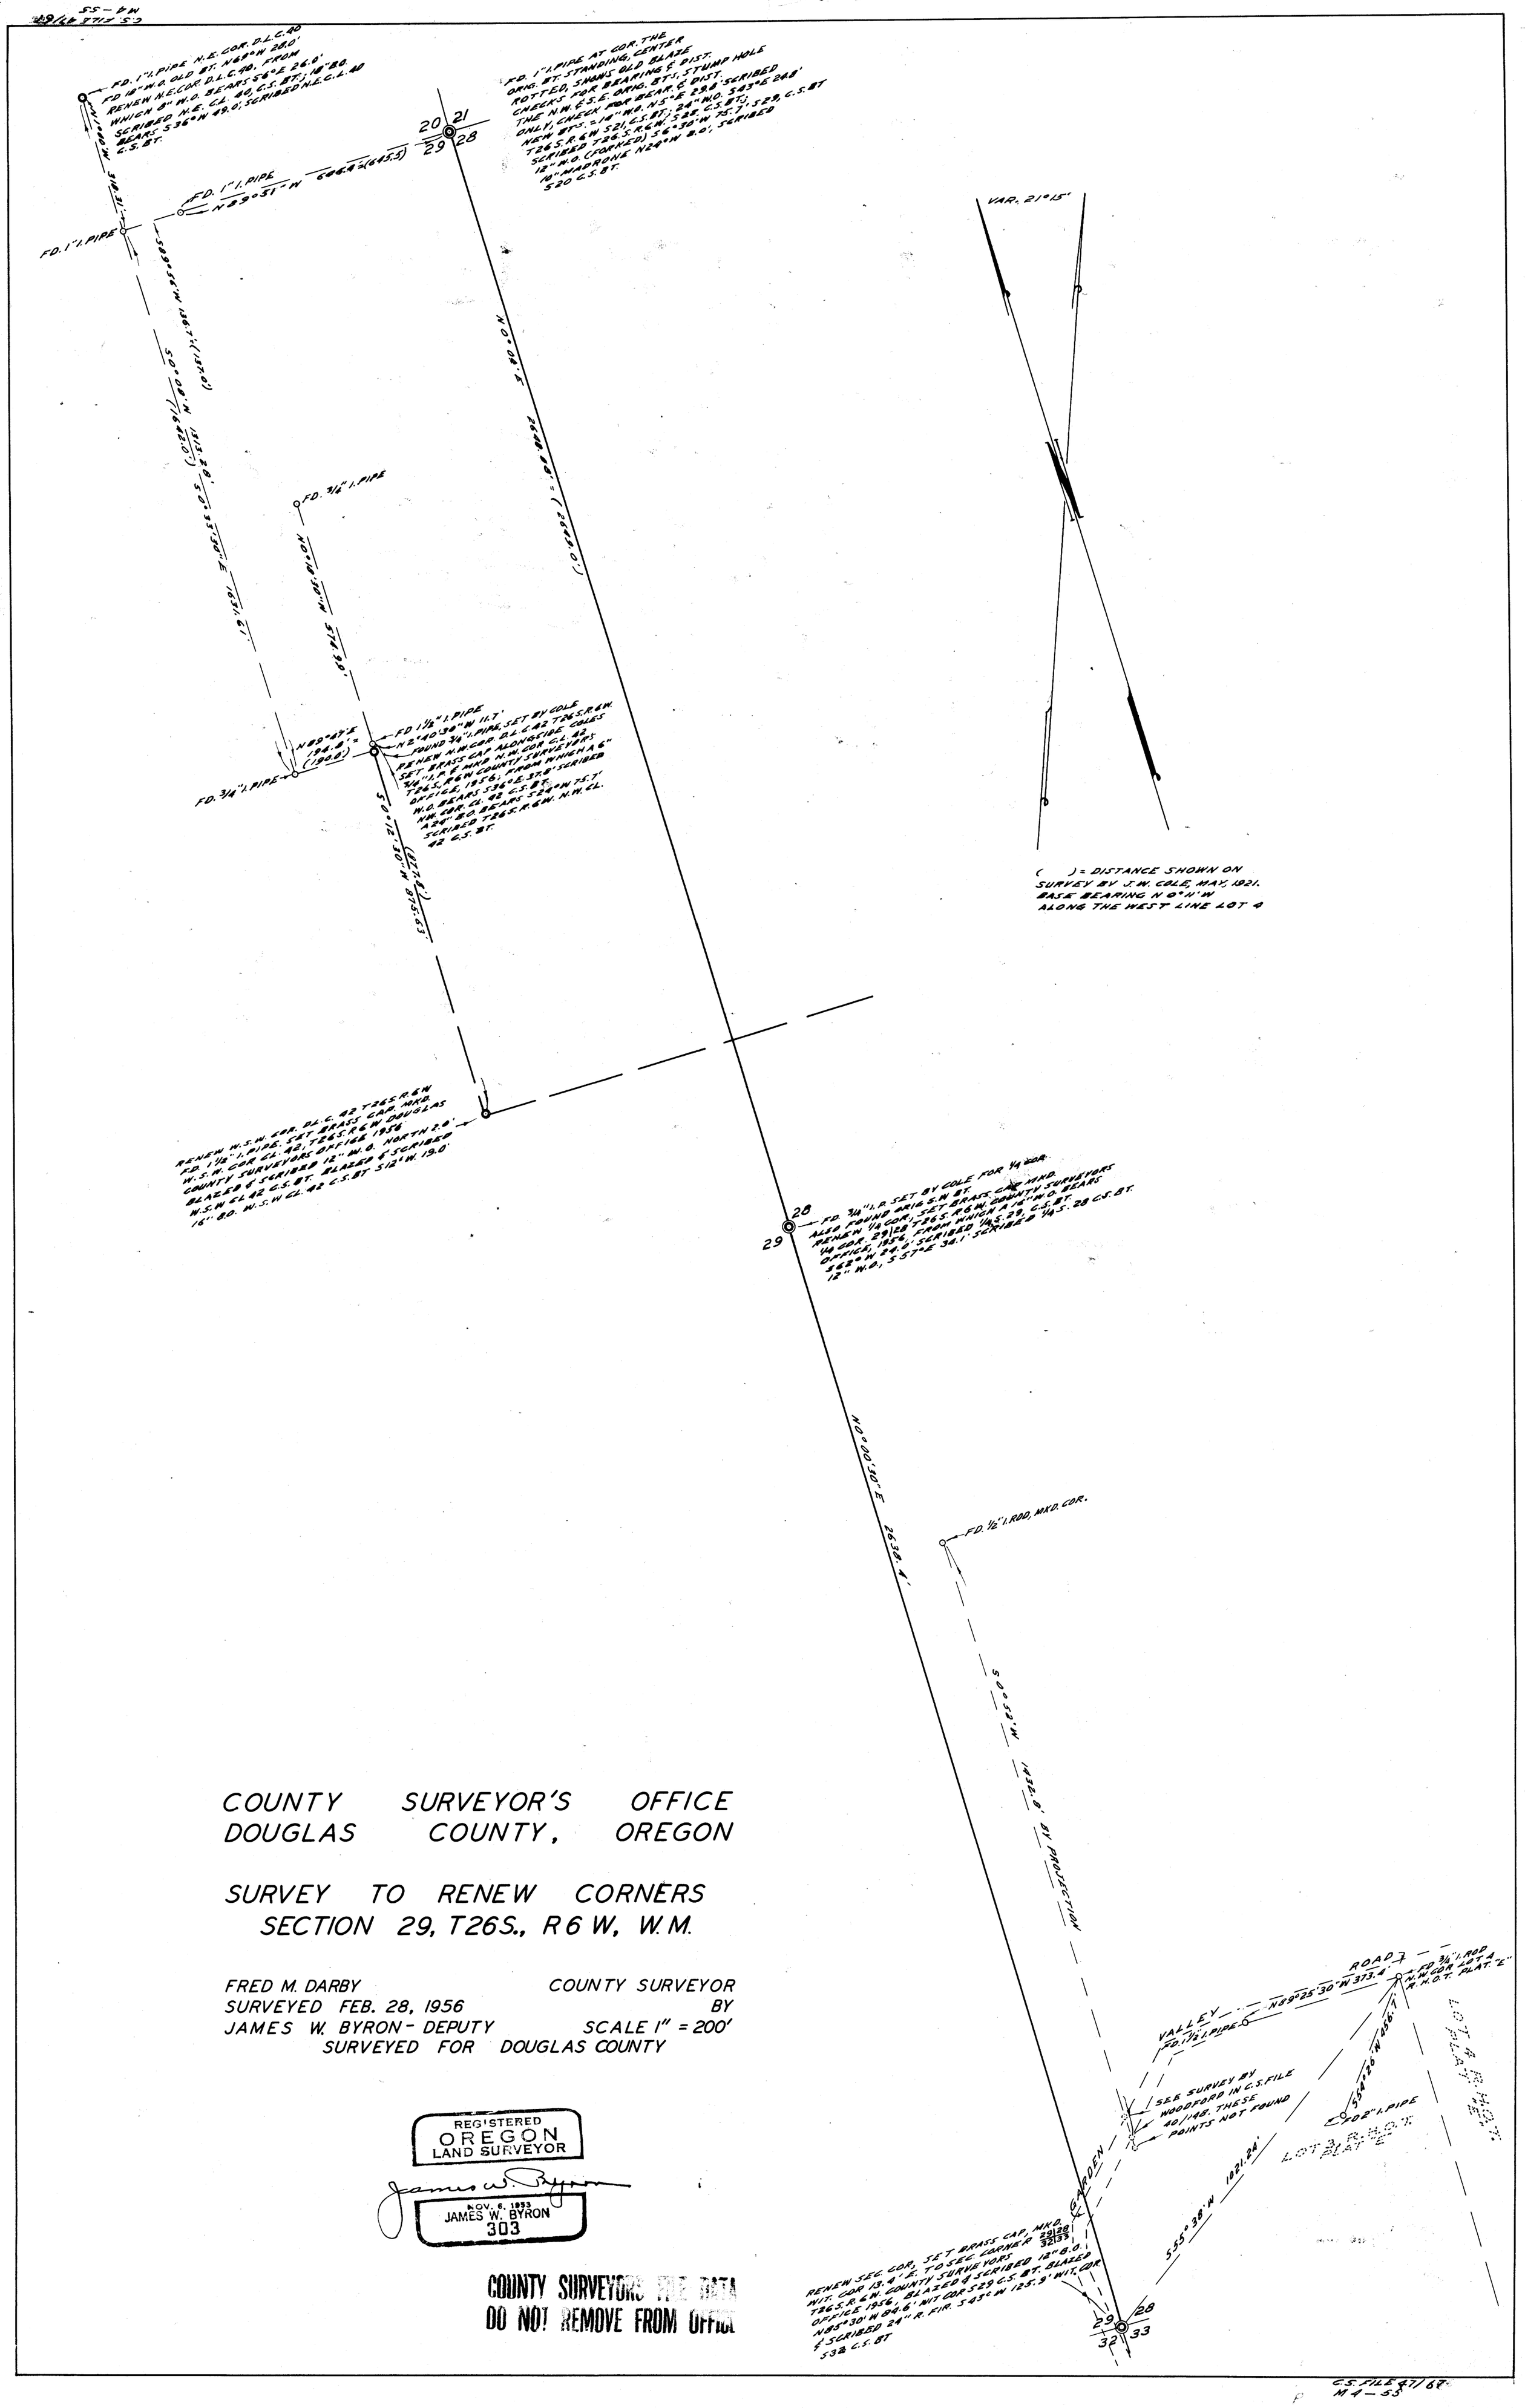

COUNTY SURVEYOR'S OFFICE
DOUGLAS COUNTY, OREGON

SURVEY TO RENEW CORNERS
SECTION 29, T26S., R6W, W.M.

FRED M. DARBY — COUNTY SURVEYOR
SURVEYED FEB. 28, 1956 — BY
JAMES W. BYRON - DEPUTY — SCALE 1" = 200'
SURVEYED FOR DOUGLAS COUNTY

REGISTERED
OREGON
LAND SURVEYOR

James W. Byron

NOV. 6, 1953
JAMES W. BYRON
303

COUNTY SURVEYORS FILE DATA
DO NOT REMOVE FROM OFFICE

C.S. FILE 87/67
M4-55