


Sec. 17
 Sec. 16
 1/4 Corner

COUNTY SURVEYORS FILE DATA
 DO NOT REMOVE FROM OFFICE

W. A. SMITH TRACT
 Sec. 17, Twp. 26 S; Rg 3 W., W. M.
 scale 1" = 100 ft. Surveyed Sept. 1935.
 C.S. No. 23/3 Vol. 4 P. 25
 MAP FILE M 4 56

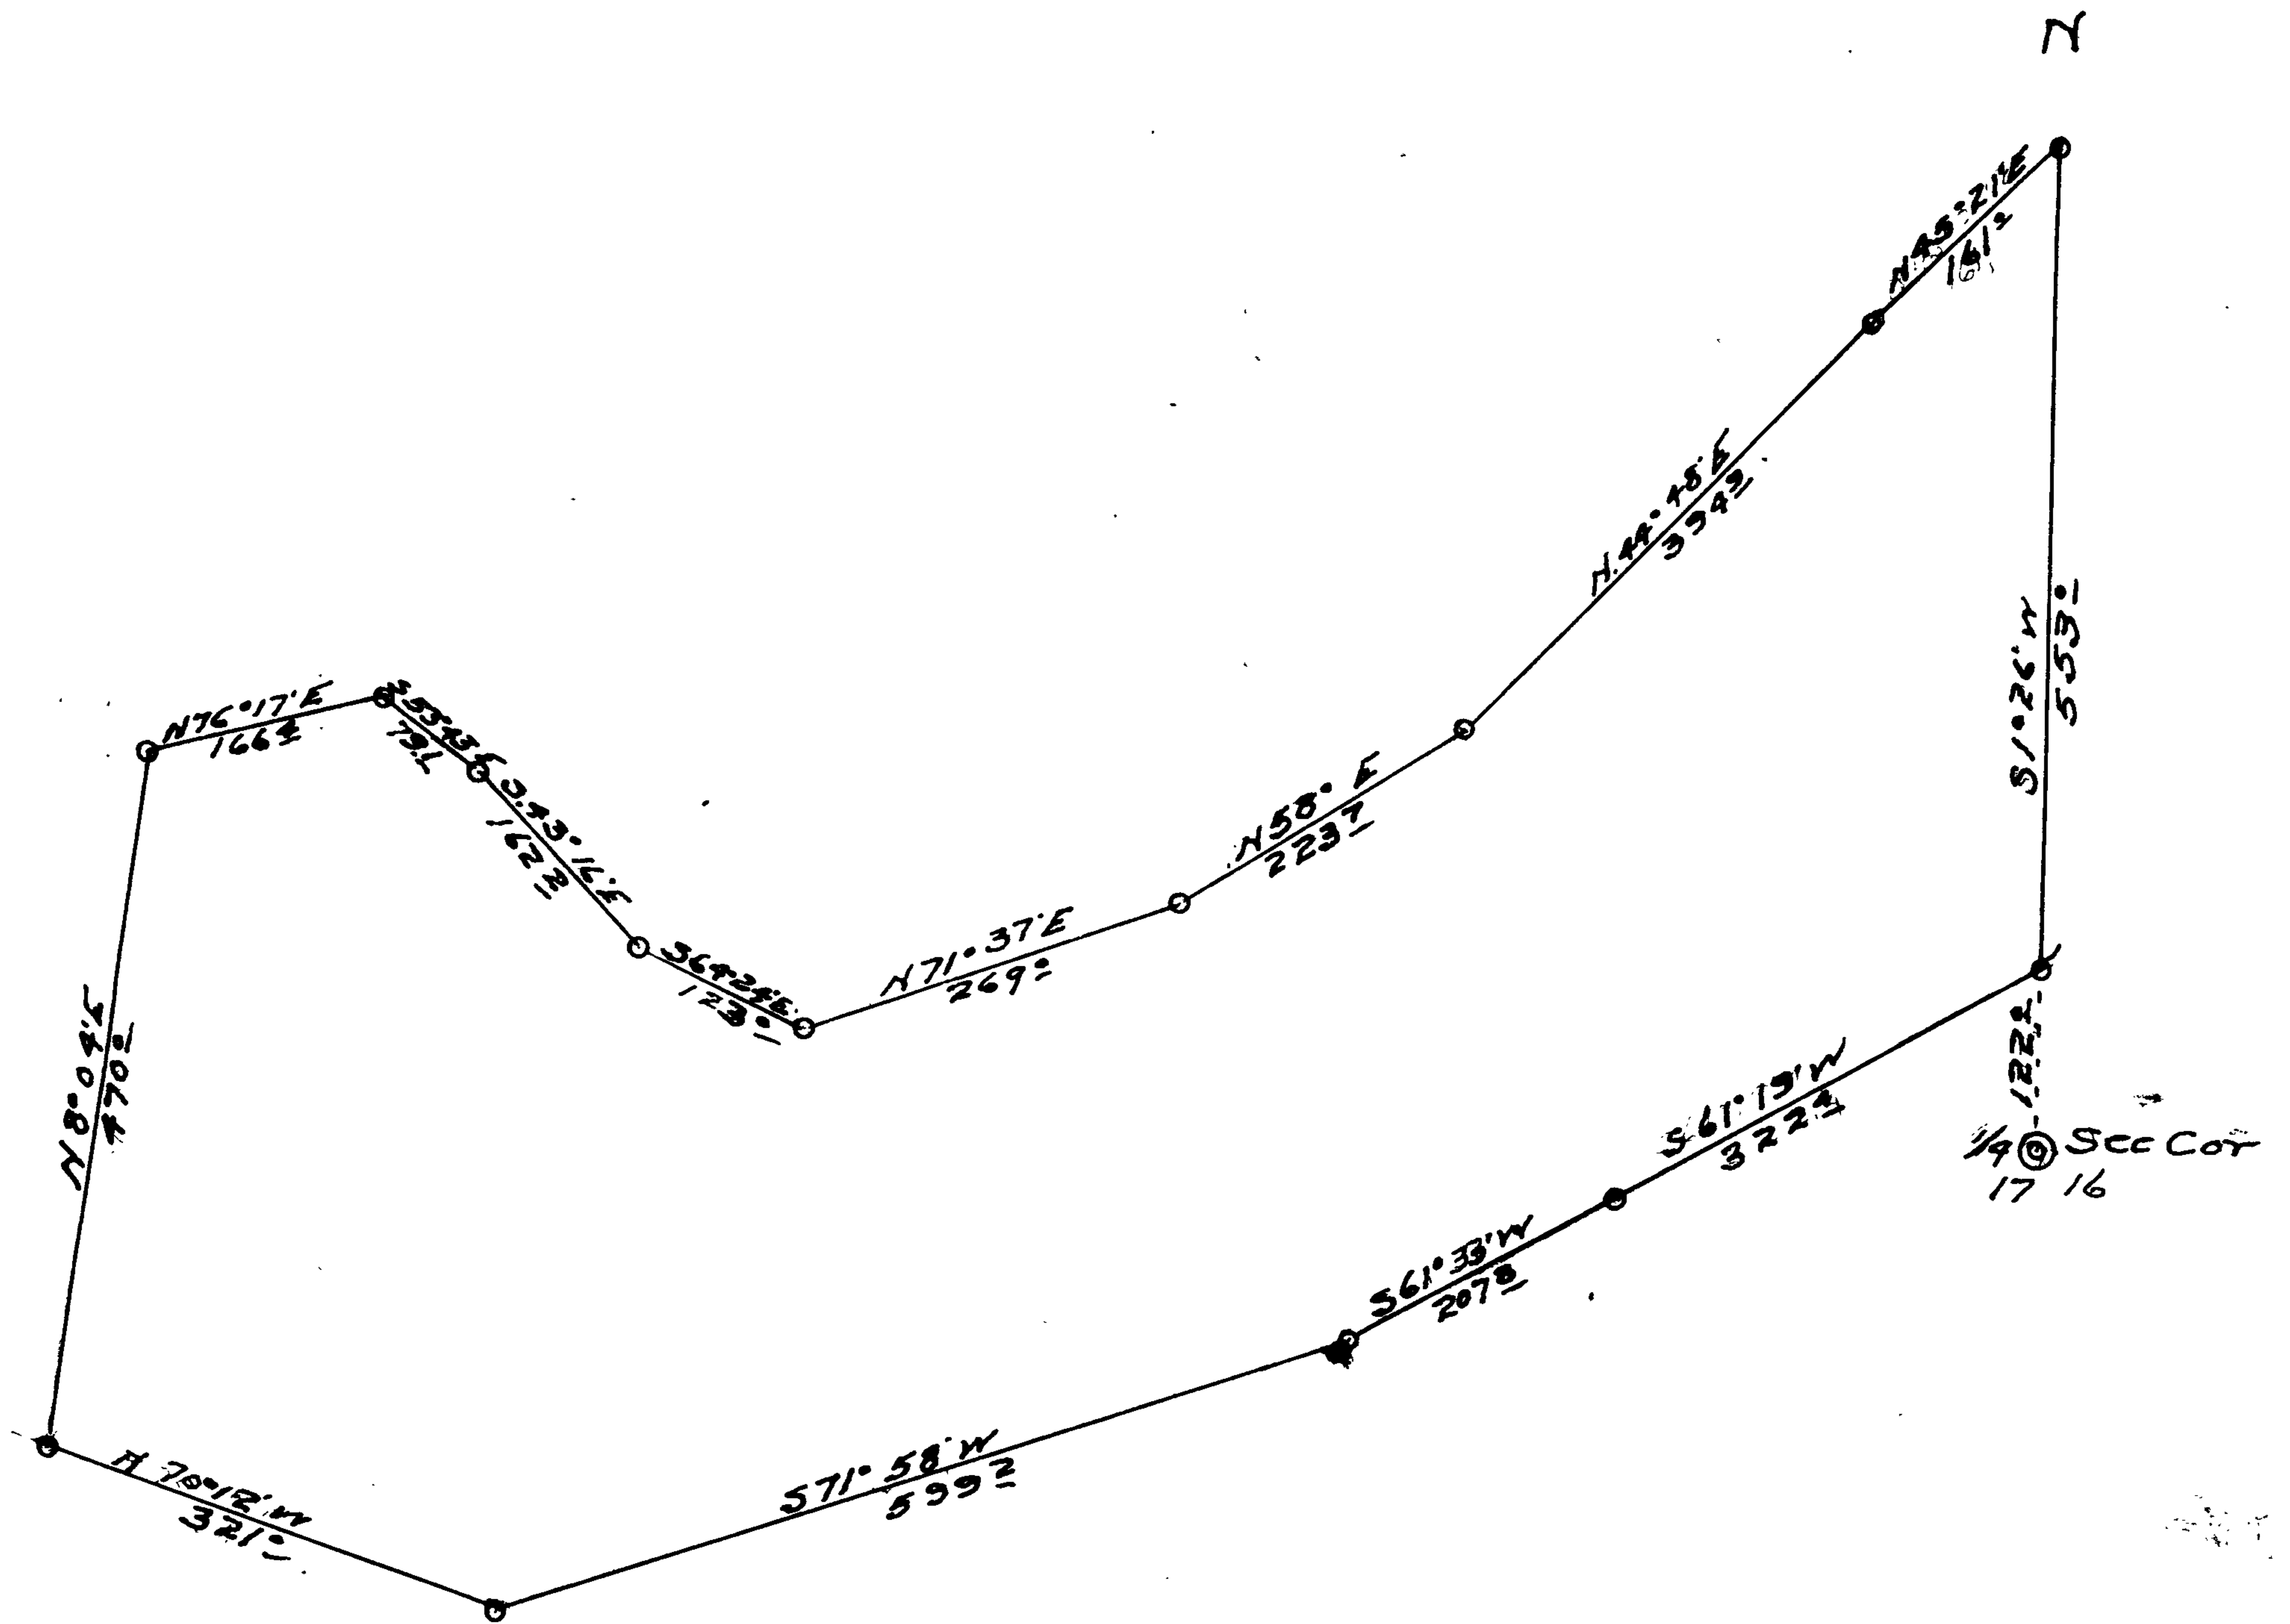

Map of Land

Surveyed Sep, 4, & 5, 1935, For W. A. Smith.

In Sec. 17

Scale, 200ft to 1 inch.

Township 26 S. R. 3 W. W.M.