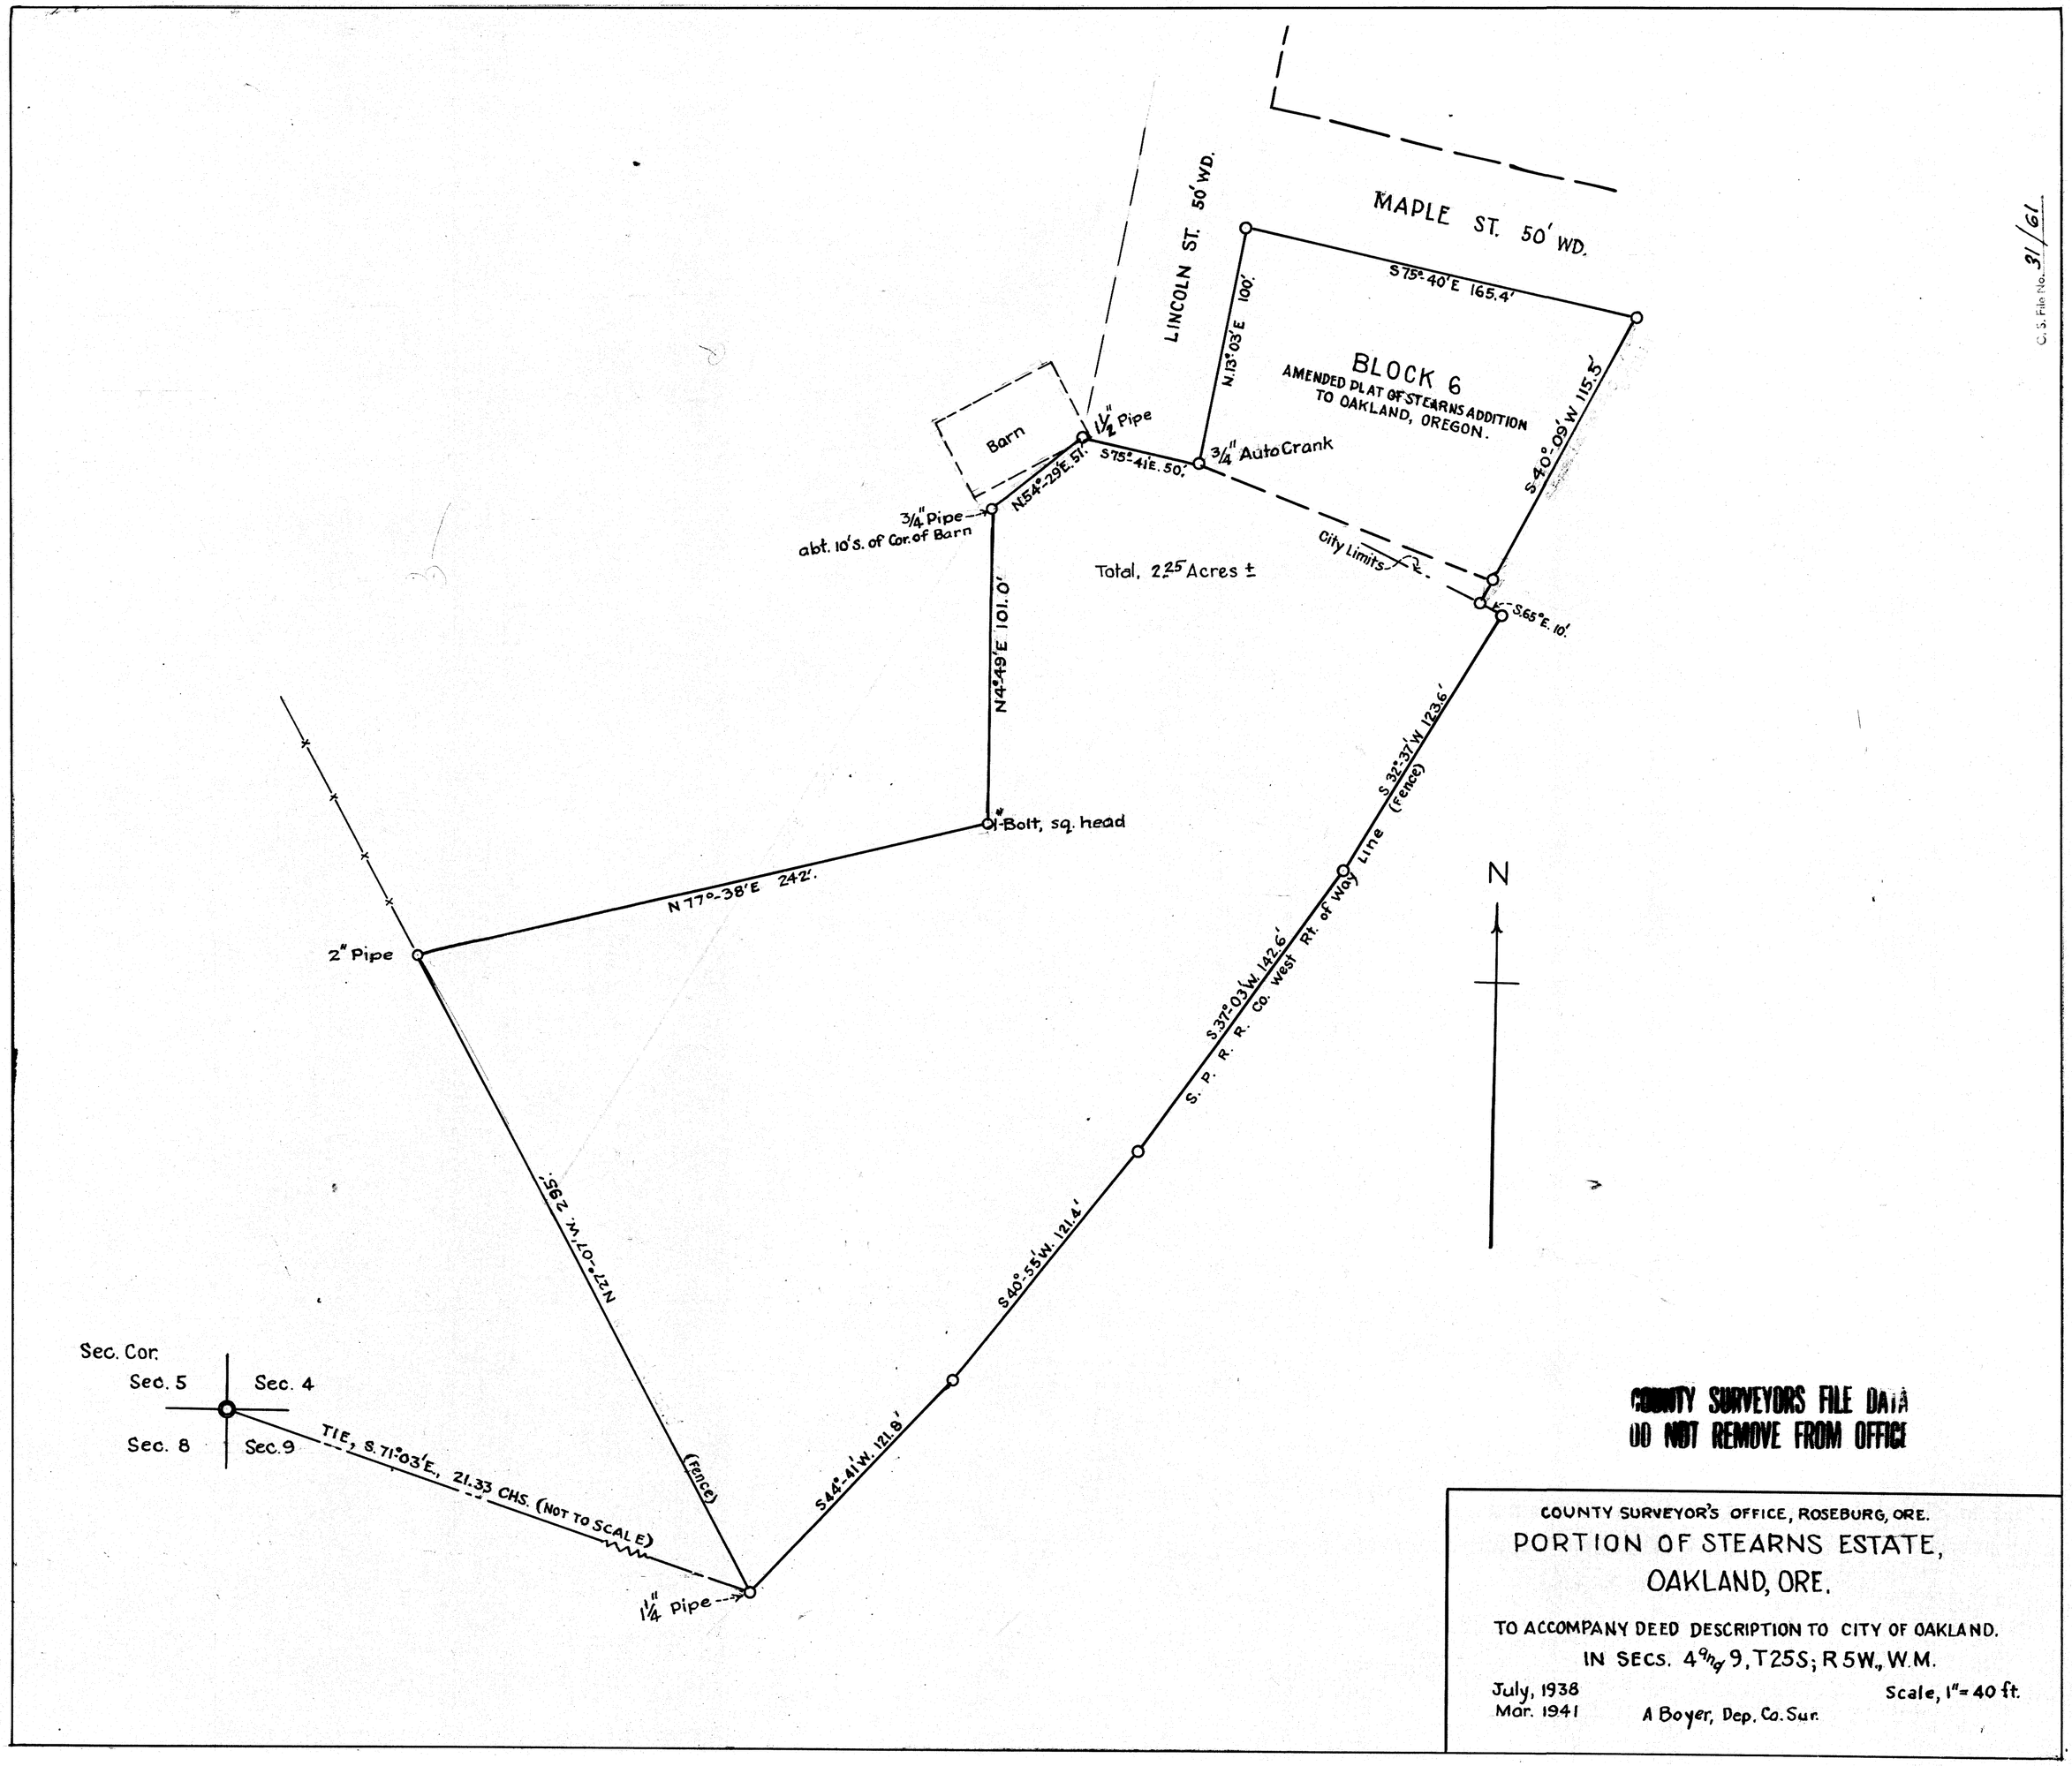

COUNTY SURVEYOR'S FILE DATA
DO NOT REMOVE FROM OFFICE

COUNTY SURVEYOR'S OFFICE, ROSEBURG, ORE.

PORTION OF STEARNS ESTATE,
OAKLAND, ORE.

TO ACCOMPANY DEED DESCRIPTION TO CITY OF OAKLAND.
IN SECS. 4 and 9, T25S; R5W., W.M.

July, 1938
Mar. 1941

Scale, 1" = 40 ft.

A Boyer, Dep. Co. Sur.

C. S. File No. 31/61
MAP FILE M4, 58
M 4-58