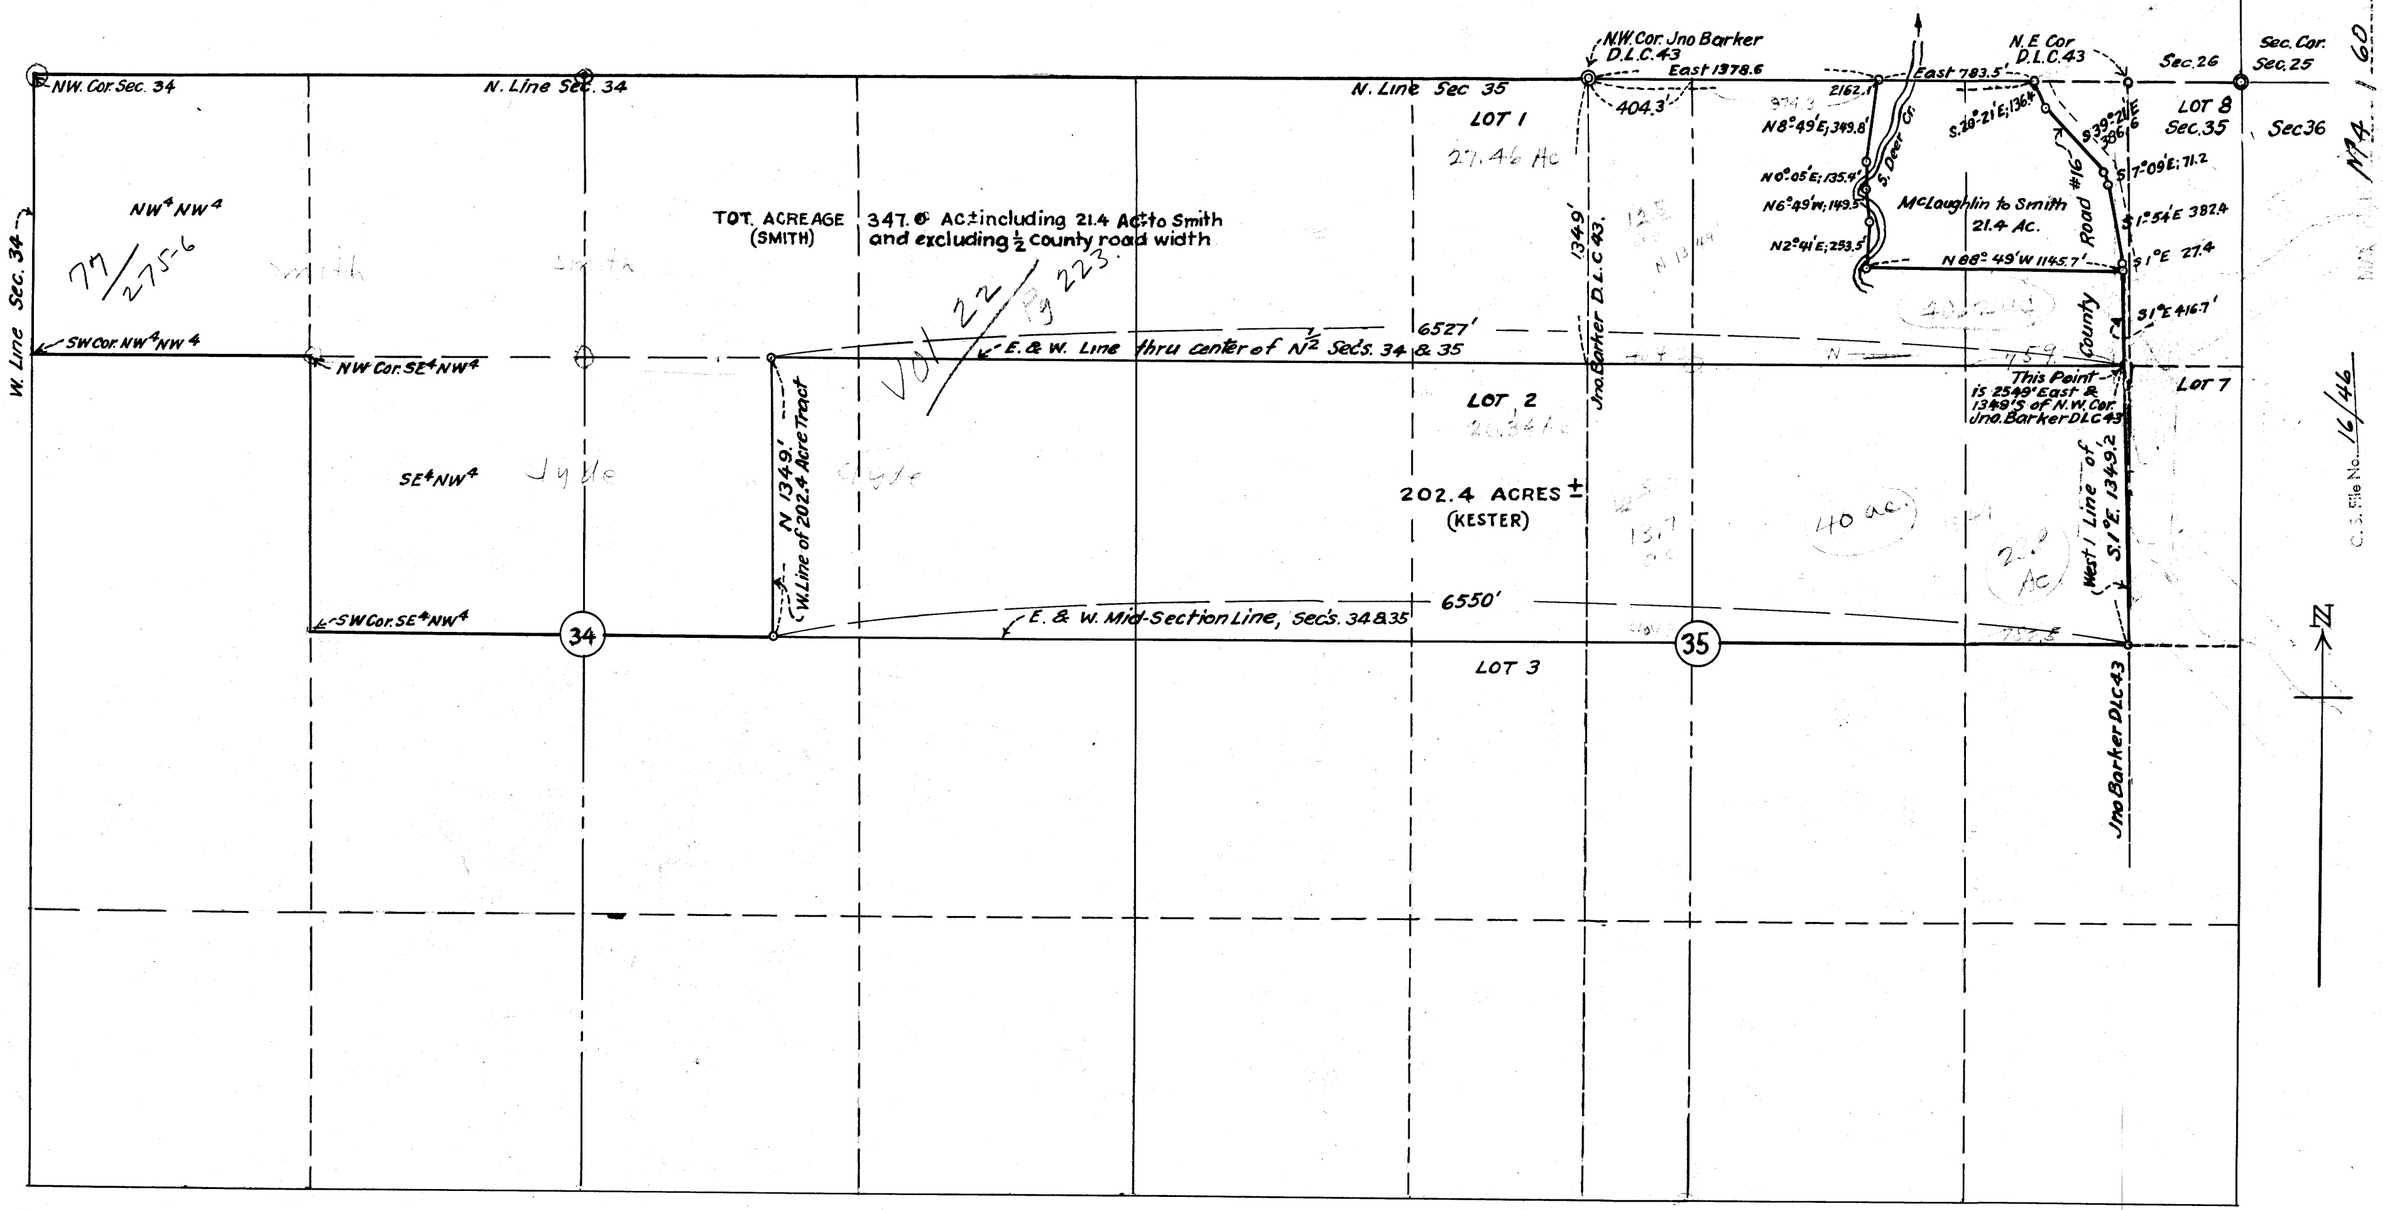

COUNTY SURVEYORS FILE DATA
DO NOT REMOVE FROM OFFICE

COUNTY SURVEYOR'S OFFICE, ROSEBURG, ORE.
R. L. McLAUGHLIN RANCH ON S. DEER CR.
IN NORTH HALF OF SECS. 34 & 35, T.27S; R.5W. W.M.
DOUGLAS COUNTY, ORE.
OCT. 1939 ARTHUR BOYER, DEP. CO. SUR. SCALE, 1" = 600 FT.

C.S. File No. 16/46
N 4-60