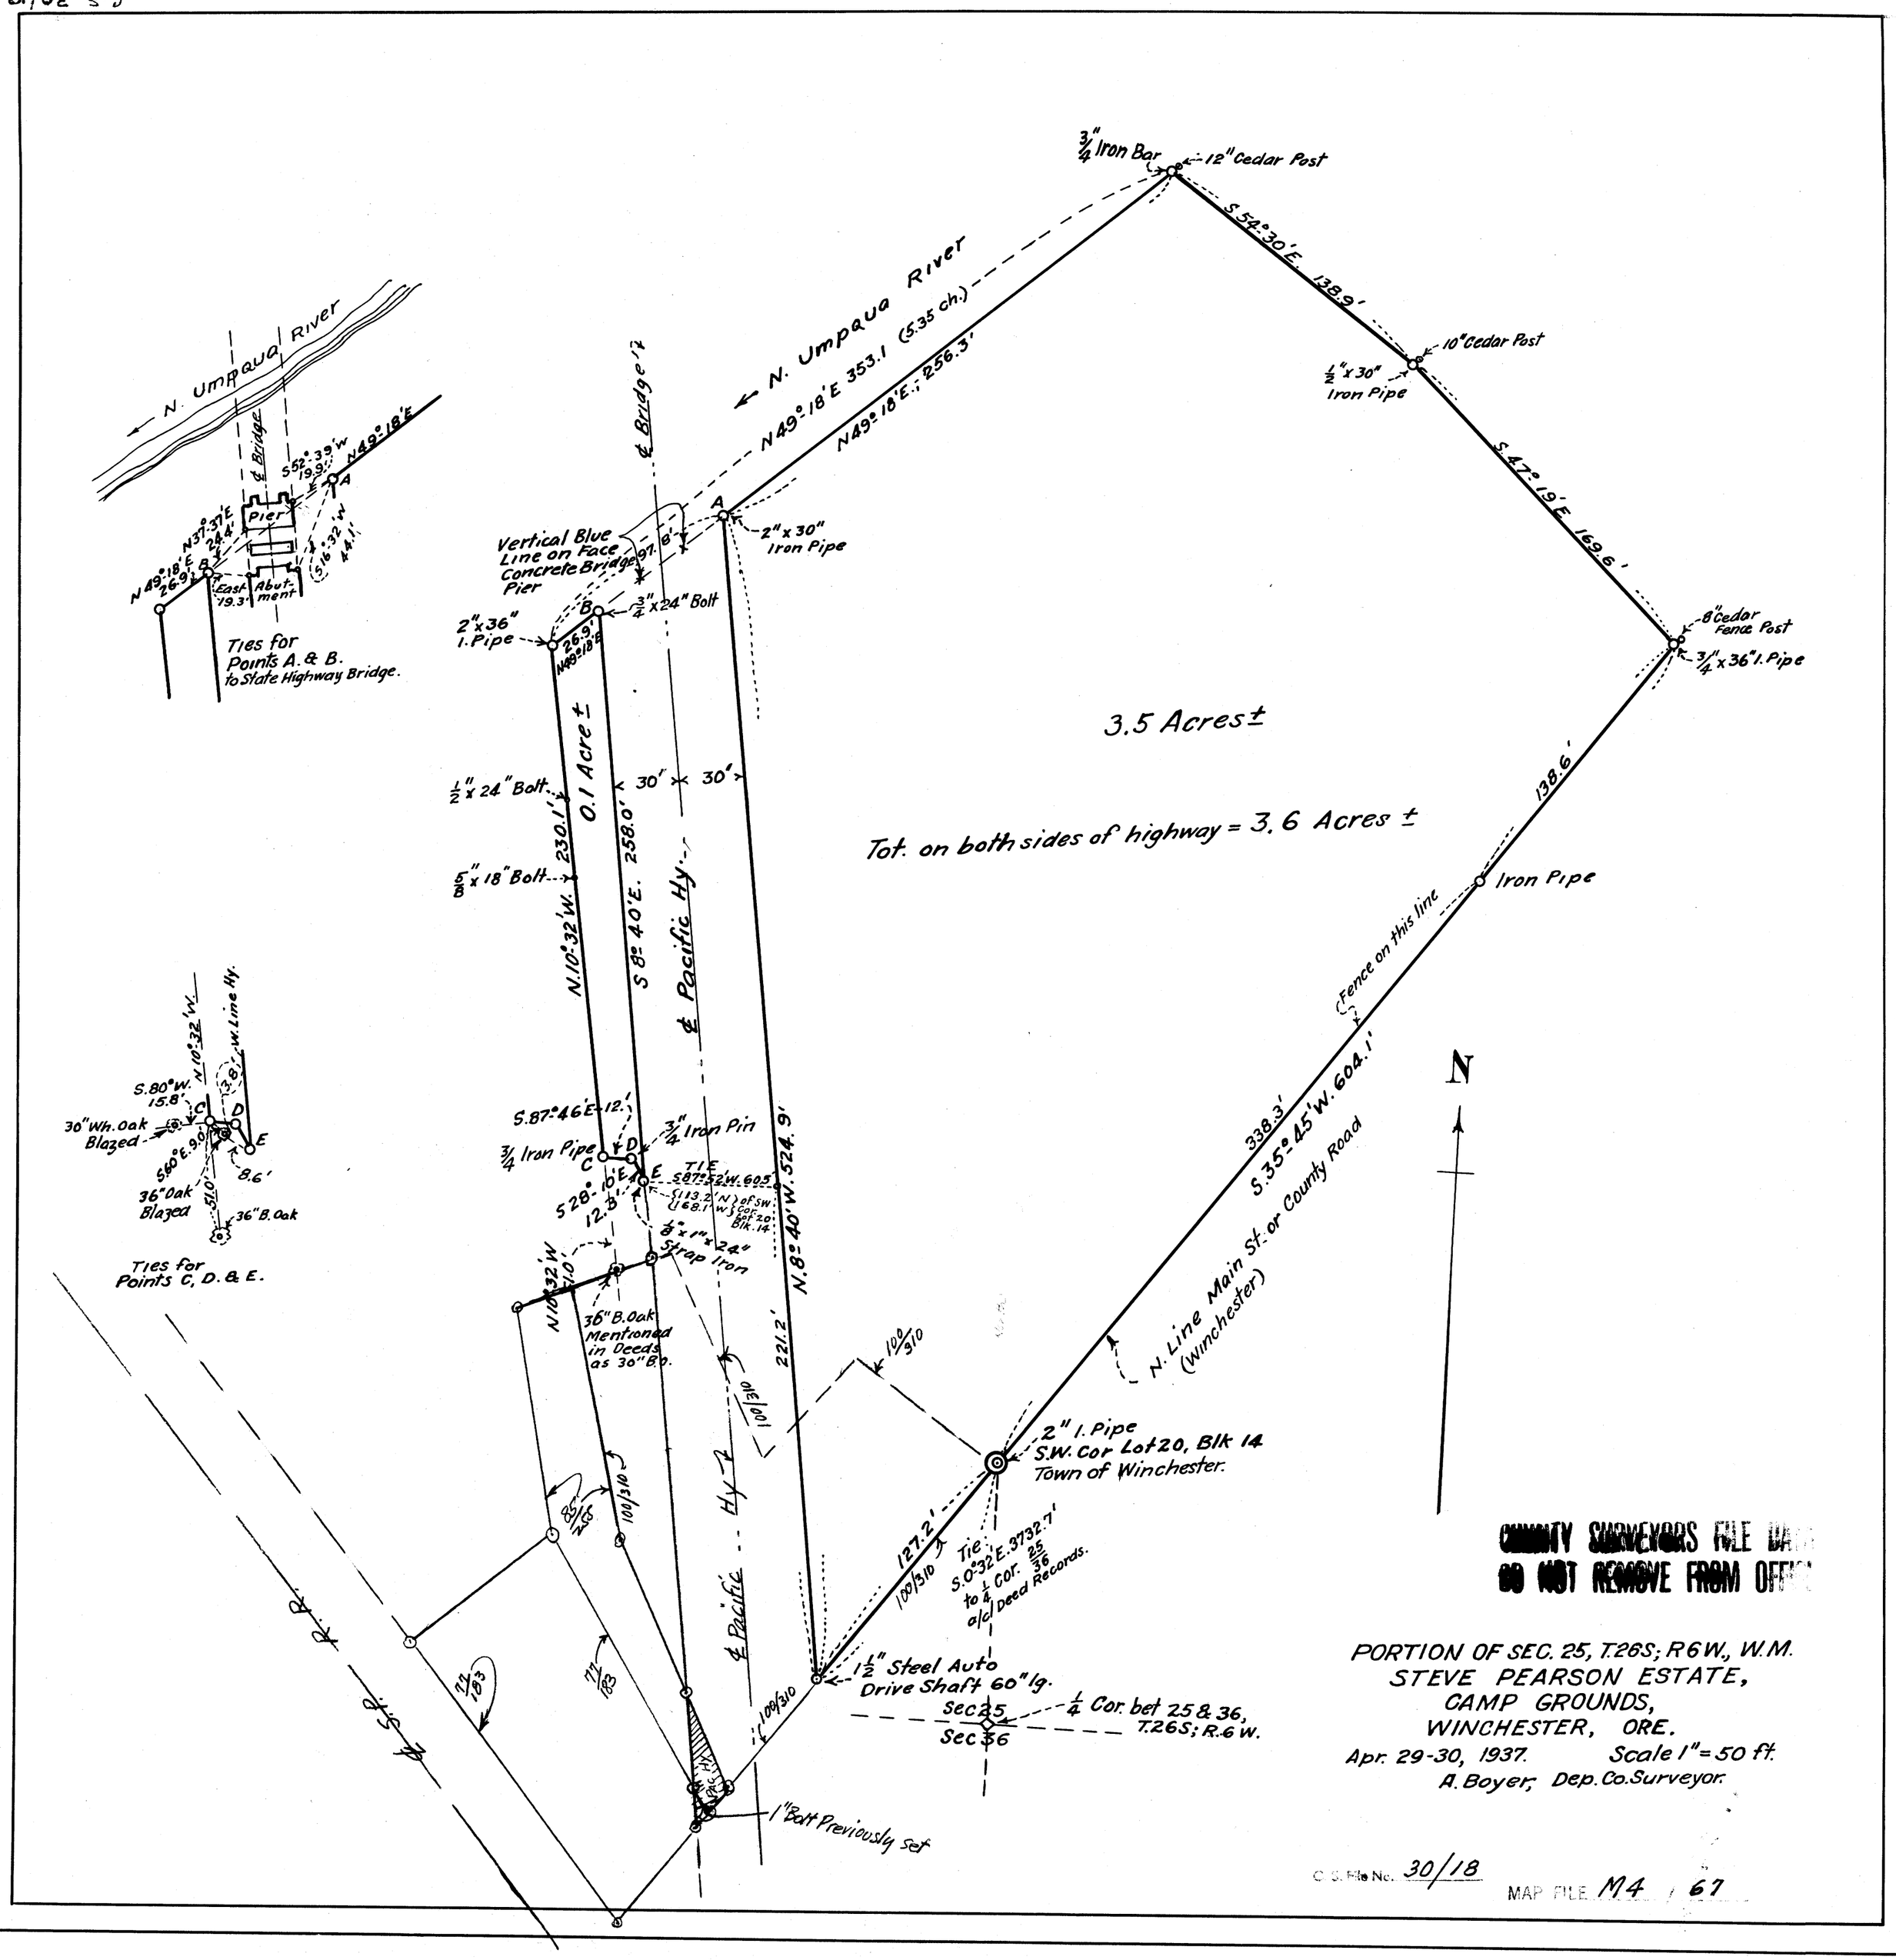

PORTION OF SEC. 25, T.26S; R6W., W.M.
STEVE PEARSON ESTATE,
CAMP GROUNDS,
WINCHESTER, ORE.

Apr. 29-30, 1937. Scale 1" = 50 ft.

A. Boyer, Dep. Co. Surveyor.

C.S. File No. 30/18

MAP FILE M4 / 67