MAP FILE M5 / 16

COUNTY SURVEYORS FILE DA
DO NOT REMOVE FROM OFF

BEN P. METZ

YONCALLA

SEC. 15, T. 23 S. R. 5 W.WM

FEBRURY 1955 1" = 100'

REGISTERED PROFESSIONAL ENGINEER 1362 OREGON MAR. 9 1928 FRED L. DOW

FILED
RECEIVED
MAR 25 1957
COUNTY SURVEYOR
DOUGLAS COUNTY, ORE.

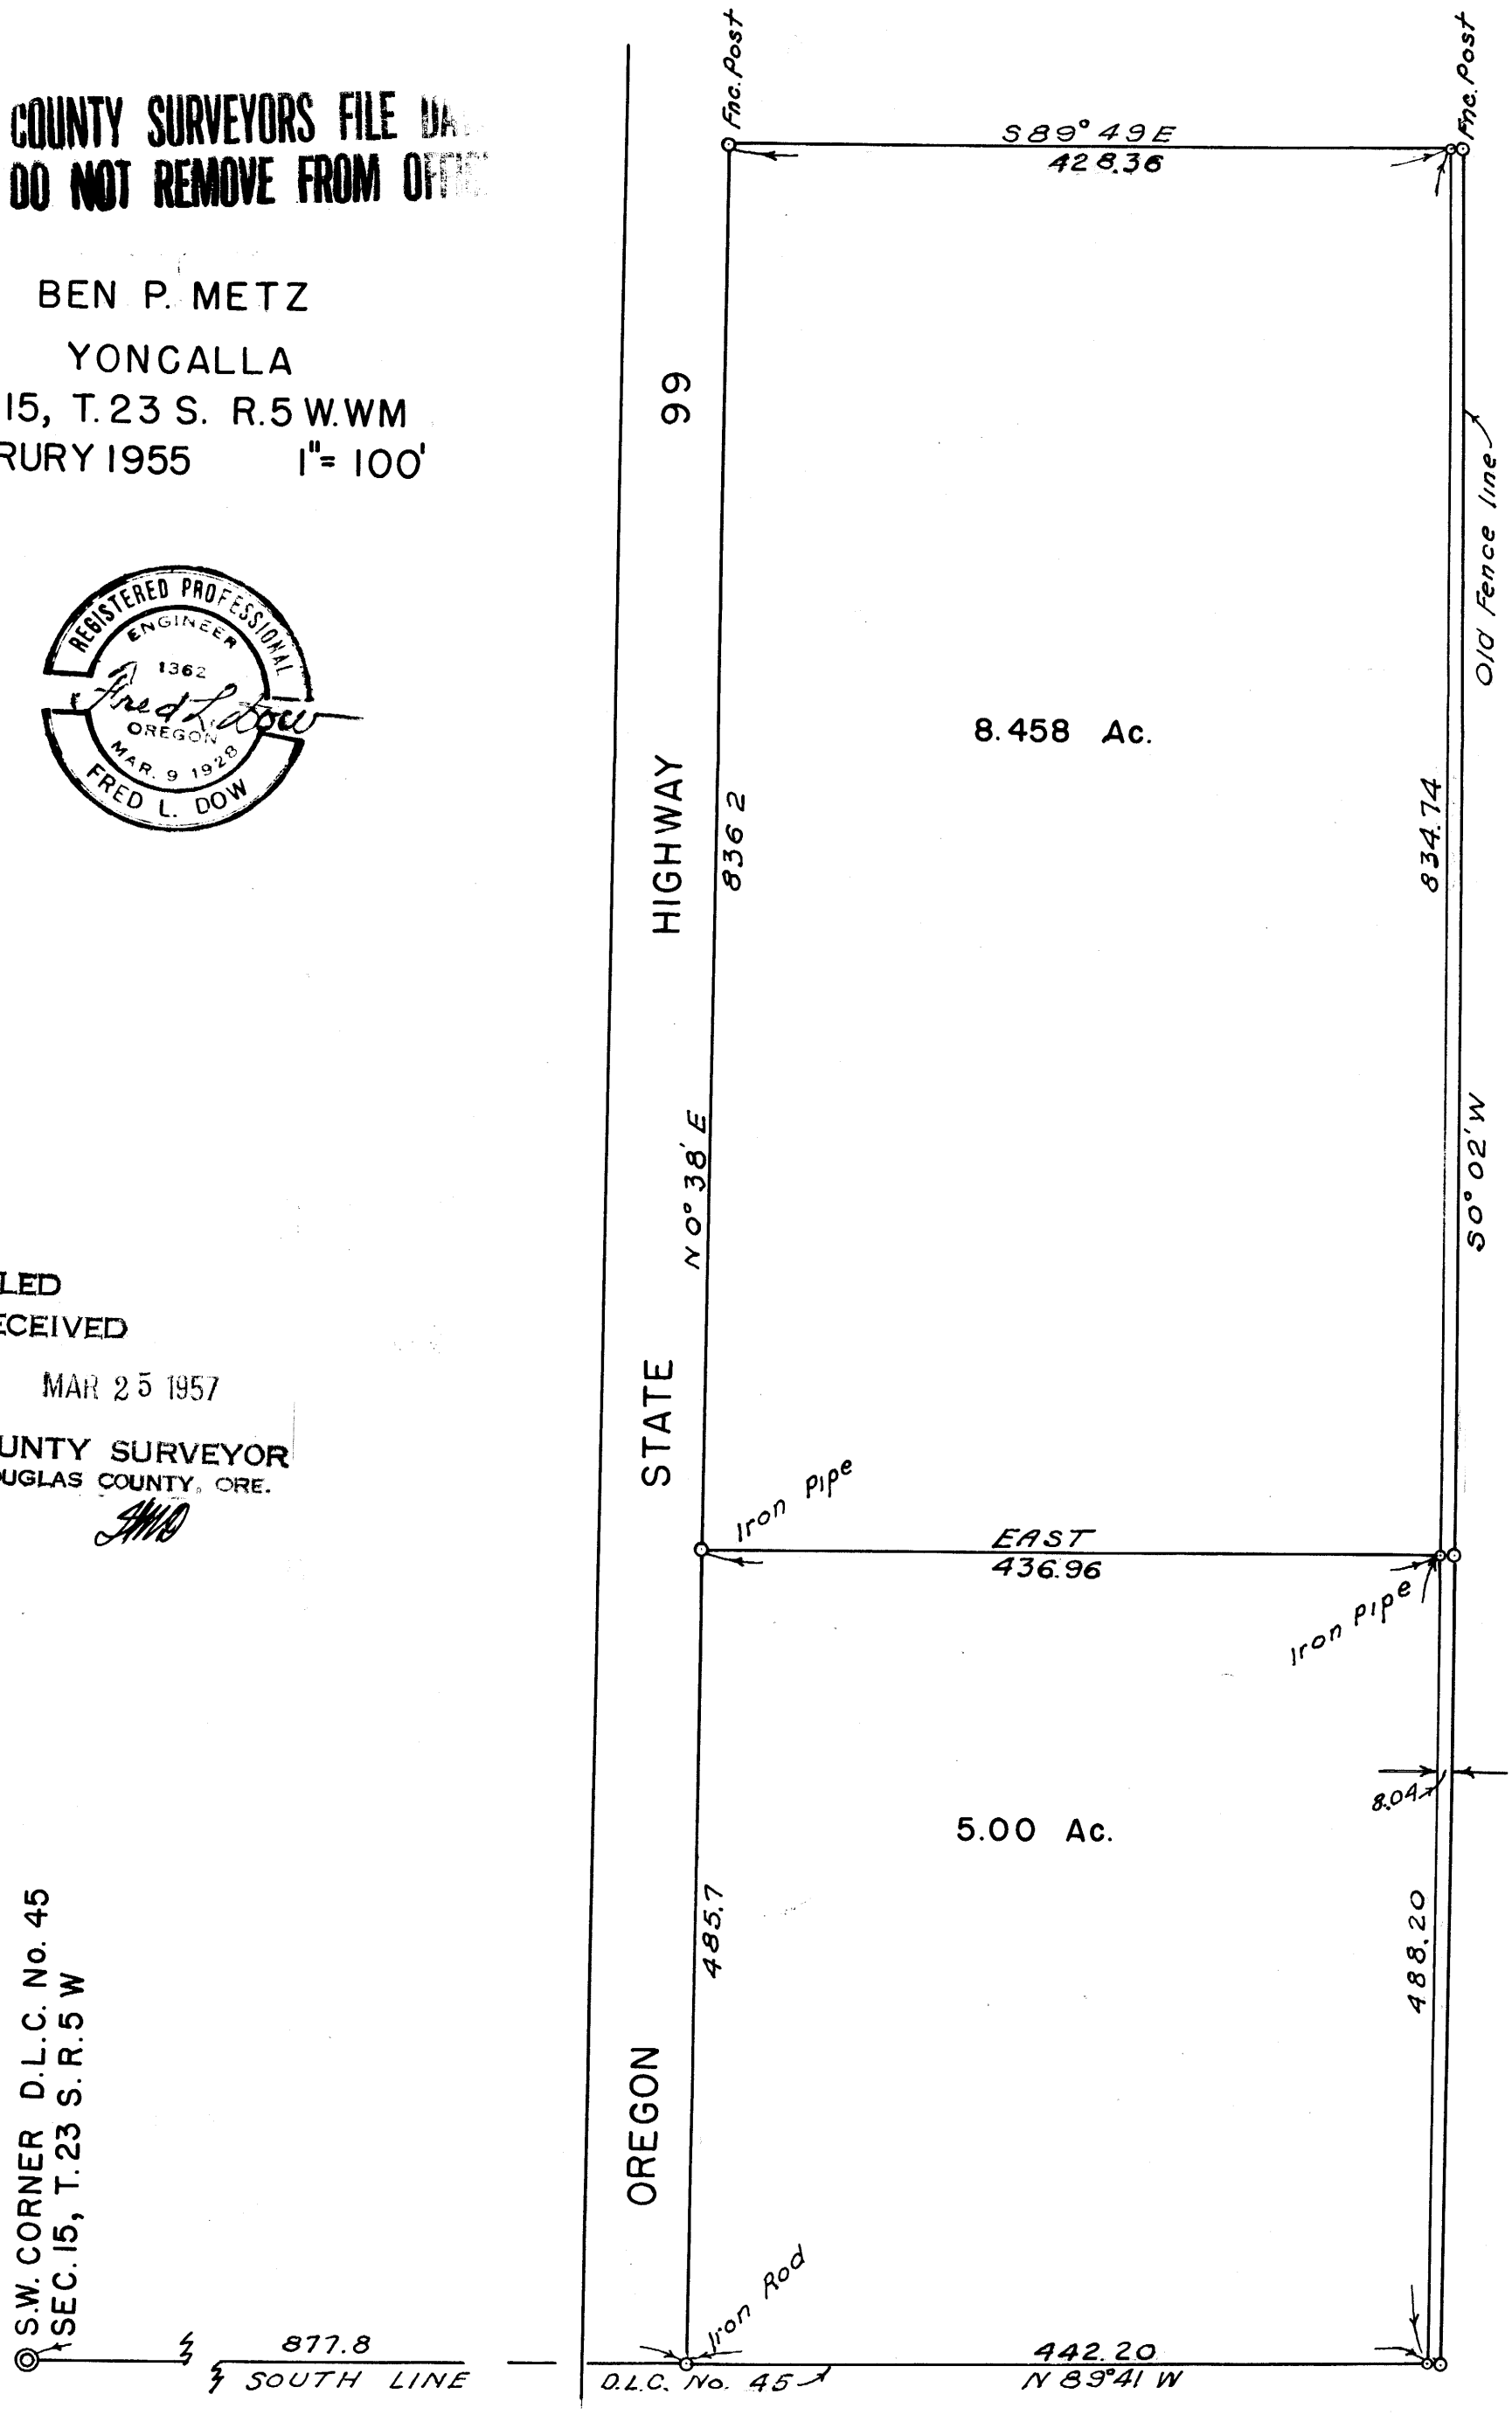

MAP FILE M5 / 16 E

C.S. File No. CS 50/80

W) 220 H WILSON D L C