C.S. 45/132
M 5-29

E.L. Pfaff Sept. 1946
S.D. Hemphill Dec. 1955

MS 29
45/132

COUNTY SURVEYOR'S OFFICE
DOUGLAS COUNTY, OREGON
Survey's in
SECTION 32, T.30S., R.5W.W.M.

Geo J. WenderoTH, Deputy

COUNTY SURVEYOR'S FILE
DO NOT REMOVE FROM

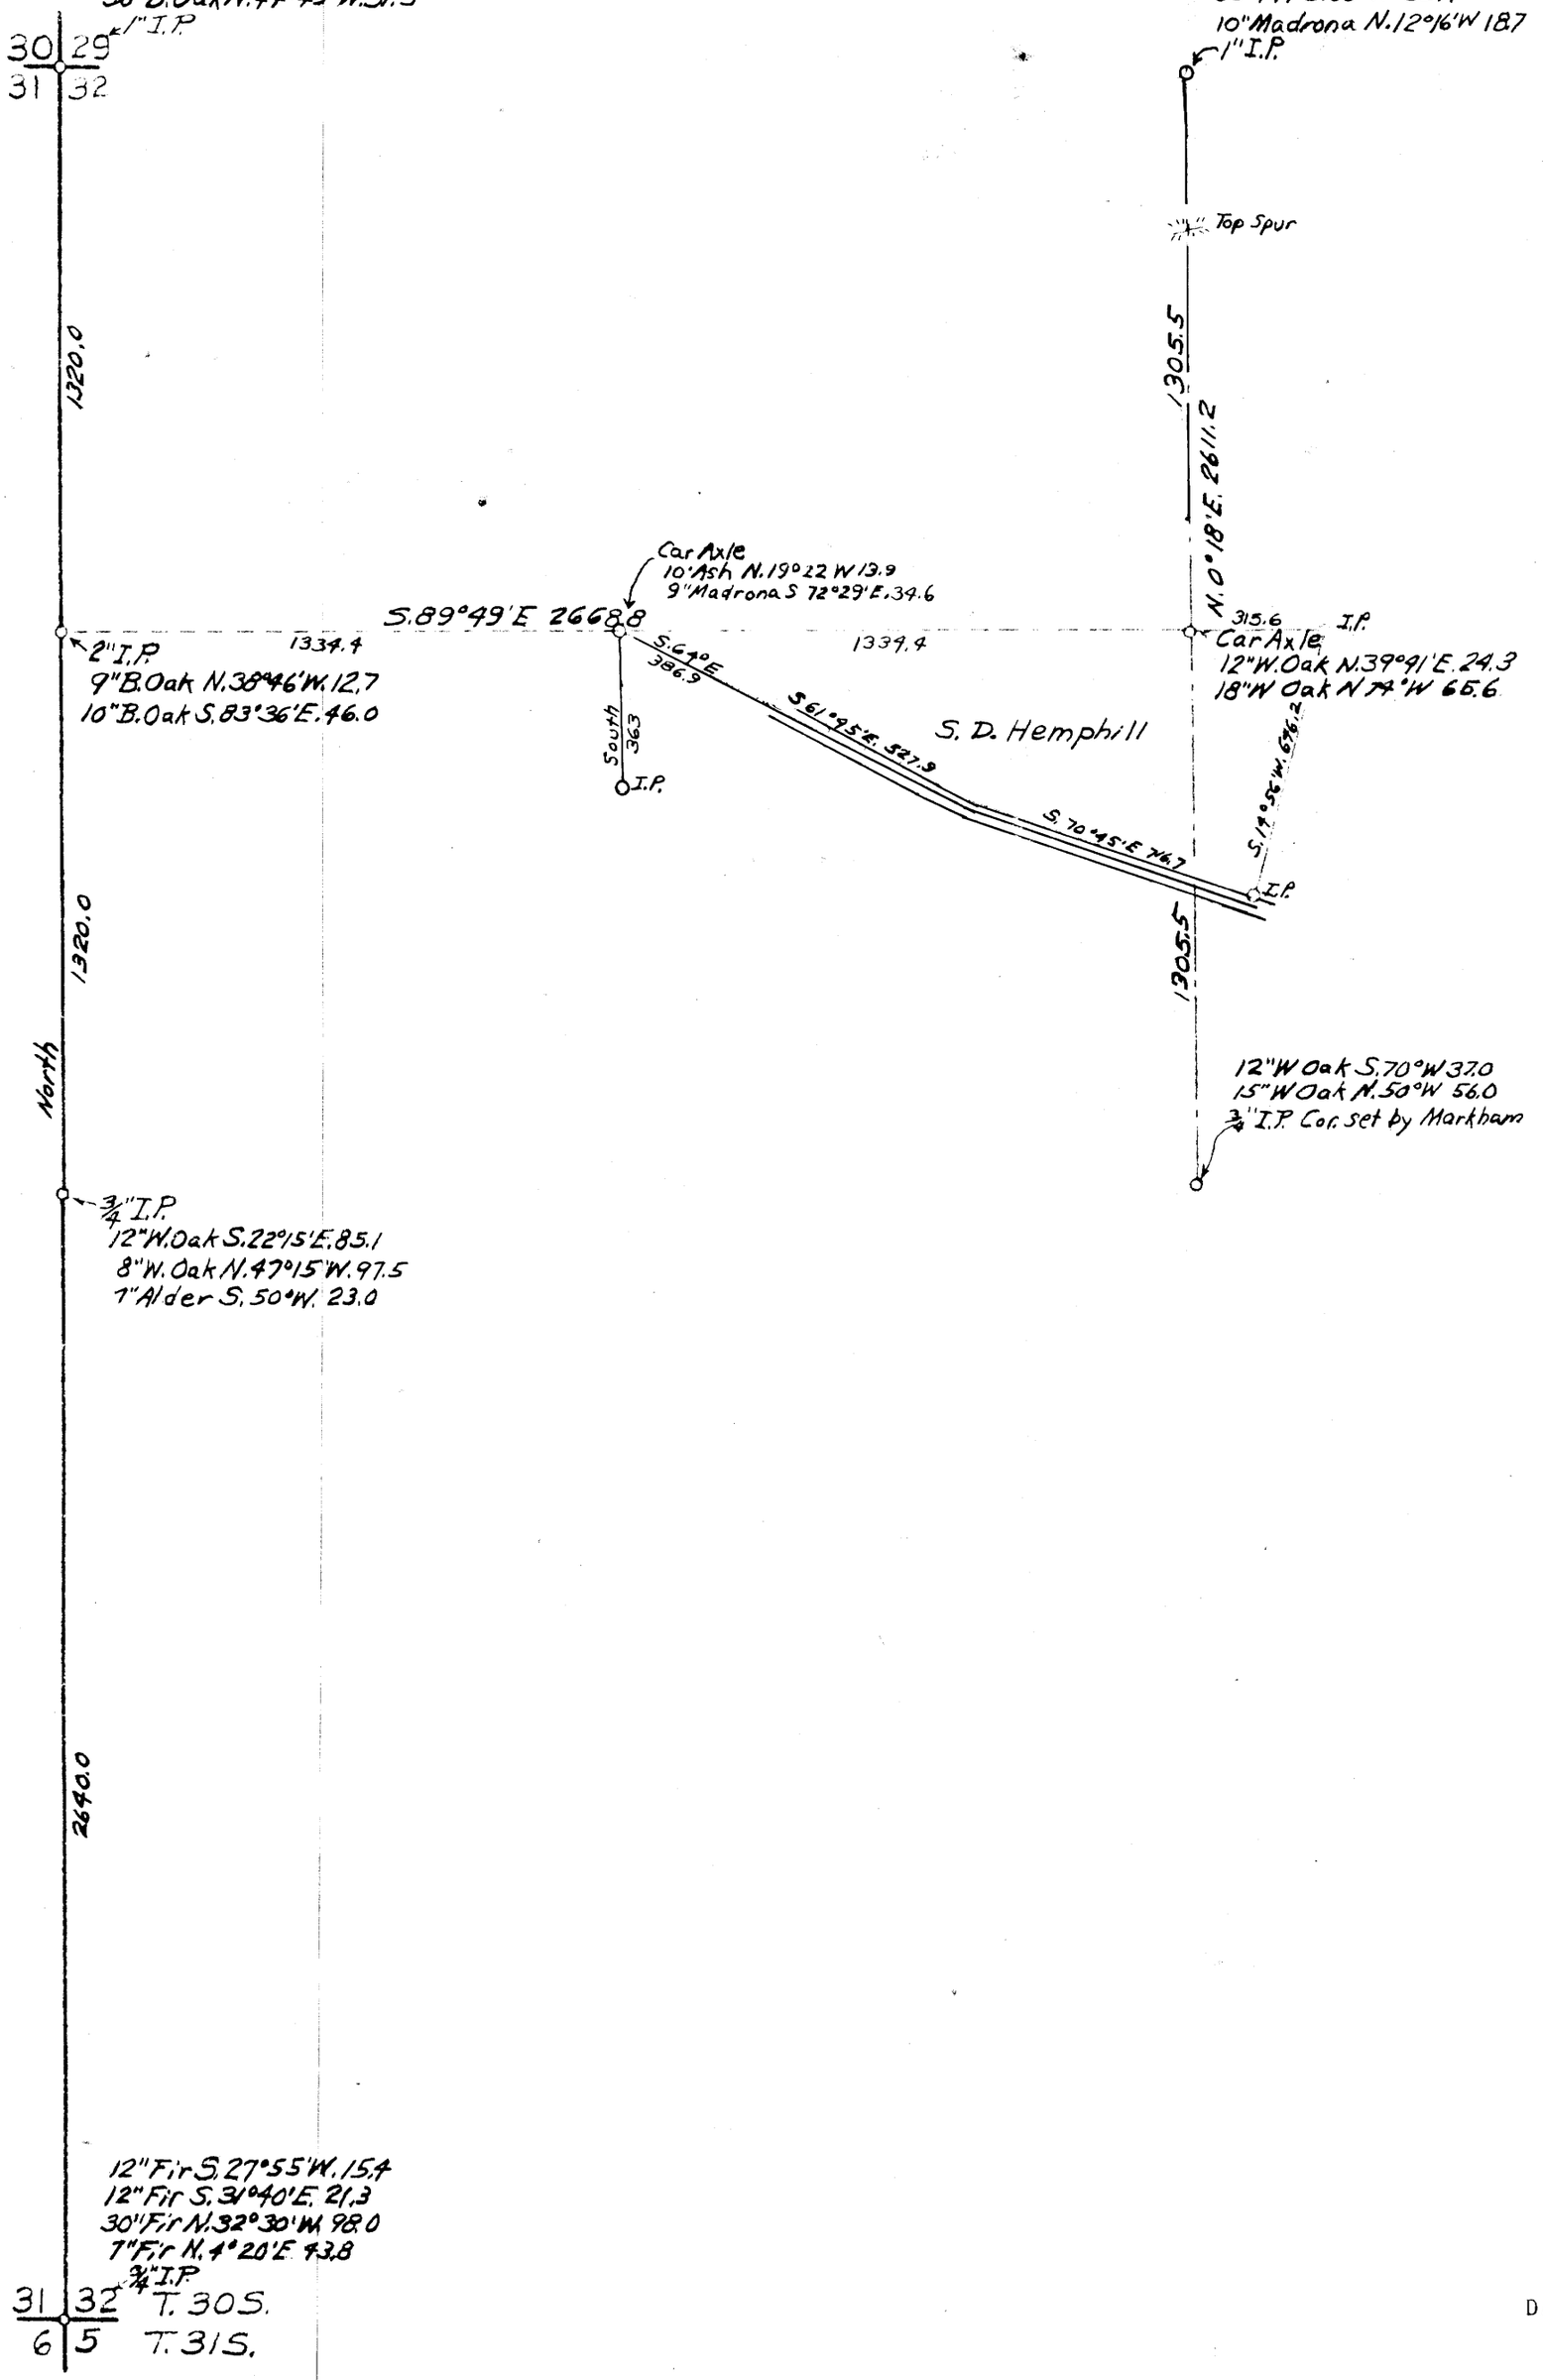

JUN 5 1957

THIS COPY MADE FROM
A XEROX 2510
DATE 2-16-89

MS 29
45/132

45 132
5 - 29