FILED
RECEIVED
JULY 15 1957
COUNTY SURVEYOR
DOUGLAS COUNTY, ORE

Gene E. Johnson

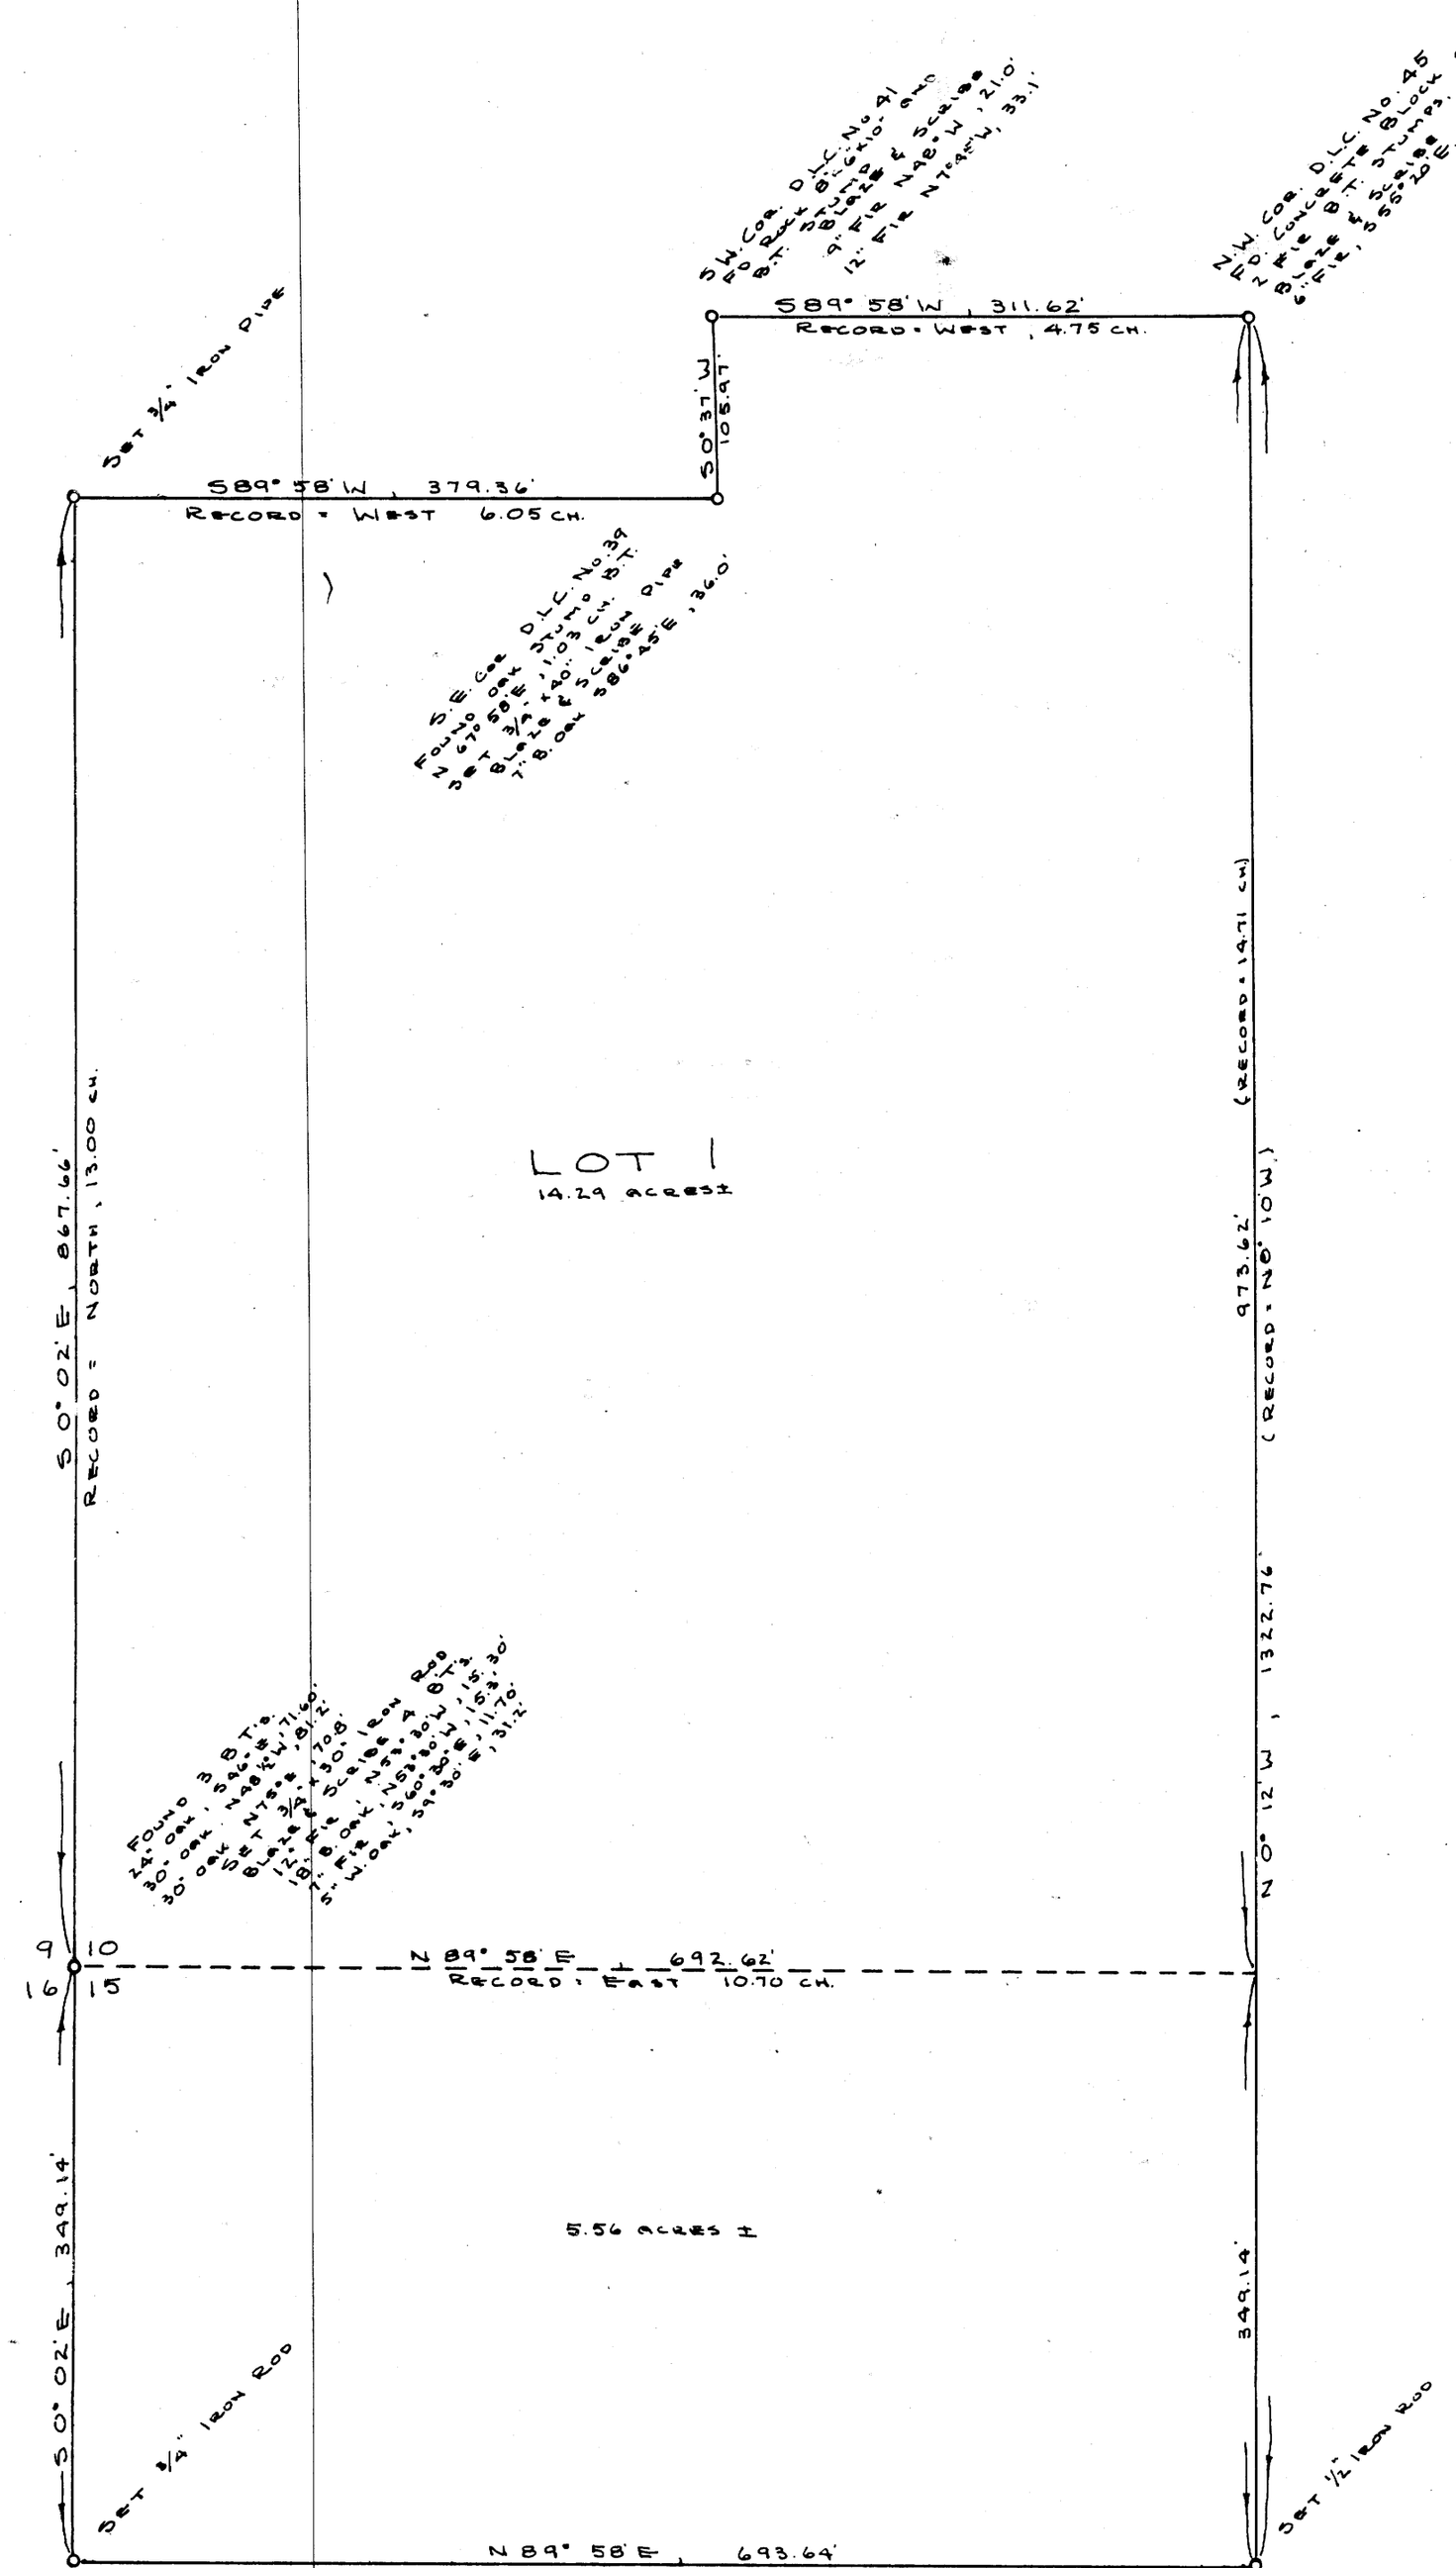

SURVEY TO ESTABLISH AGGREEMENT
PROPERTY LINES OF
LOT 1, SEC. 10, AND A PORTION OF
SEC. 15, T. 23S., R. 5W., WILL. MER.
DOUGLAS COUNTY, OREGON
FOR
G. L. SEWELL

GENE E. JOHNSON, ENGINEER
ROSEBURG, OREGON

SURVEYED AUG. 1956 - SCALE 1" = 100'

N

THIS COPY MADE FROM
A XEROX 2510
DATE 2-21-89

NOTE: BEARINGS SHOWN ARE TRUE AND ARE BASED ON A SOLAR OBSERVATION TAKEN DURING THE COURSE OF THIS SURVEY.

COUNTY SURVEYORS FILE COPY
DO NOT REMOVE FROM OFFICE

MS 40
C.S. 42/218