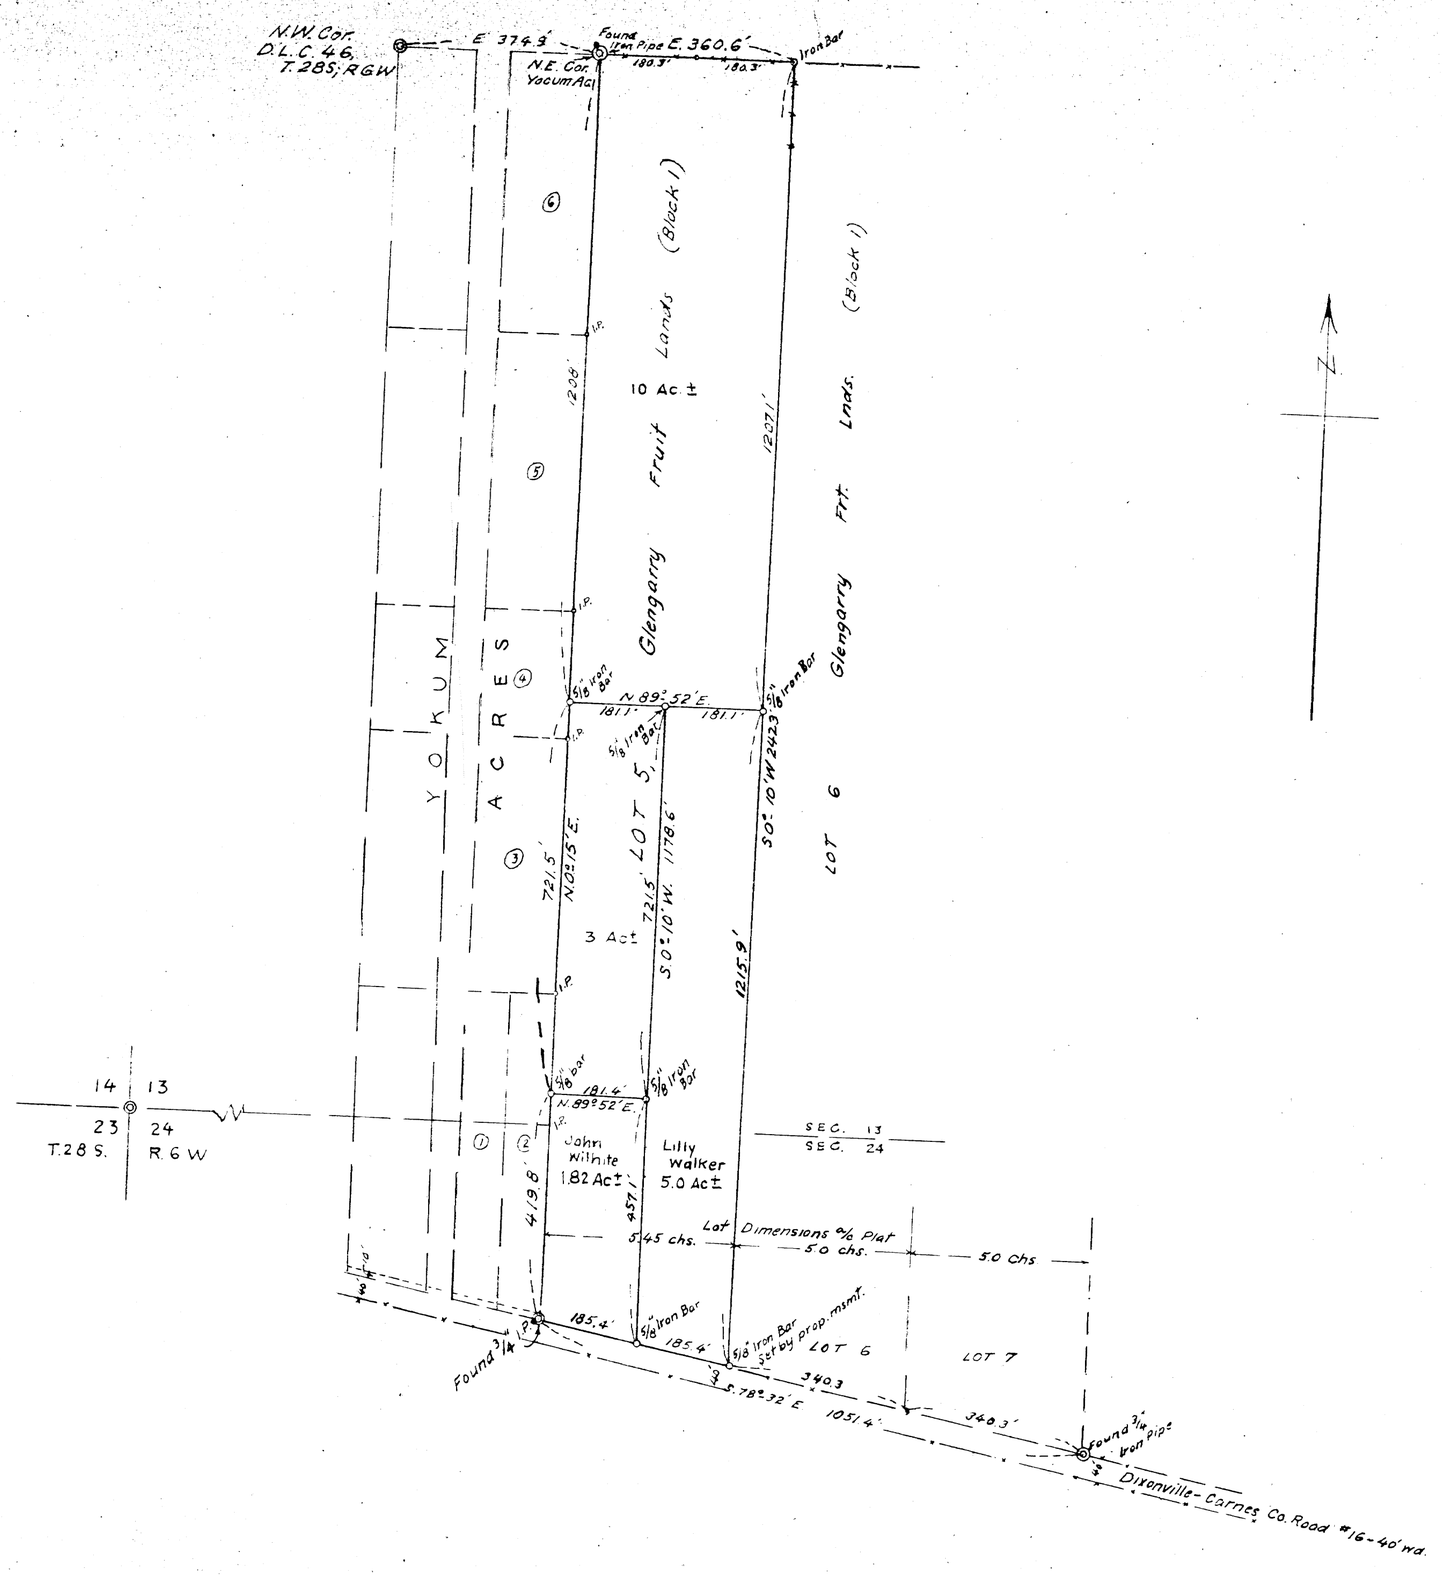

THIS COPY MADE FROM
A XEROX 2510
DATE 2-23-89

RECEIVED
JUL 18 1957
COUNTY SURVEYOR

COUNTY SURVEYOR FILE
DO NOT REMOVE FROM

WILHITE-WALKER DIVISION OF
LOT 5, BLOCK #1, GLENGARRY FRUIT LANDS
LOT 5 BEING IN SEC'S 13 & 24, T.28S; R.6W, W.M.
APR. 1957 1" = 200'
Arthur Boyer

M5 42

M5 42