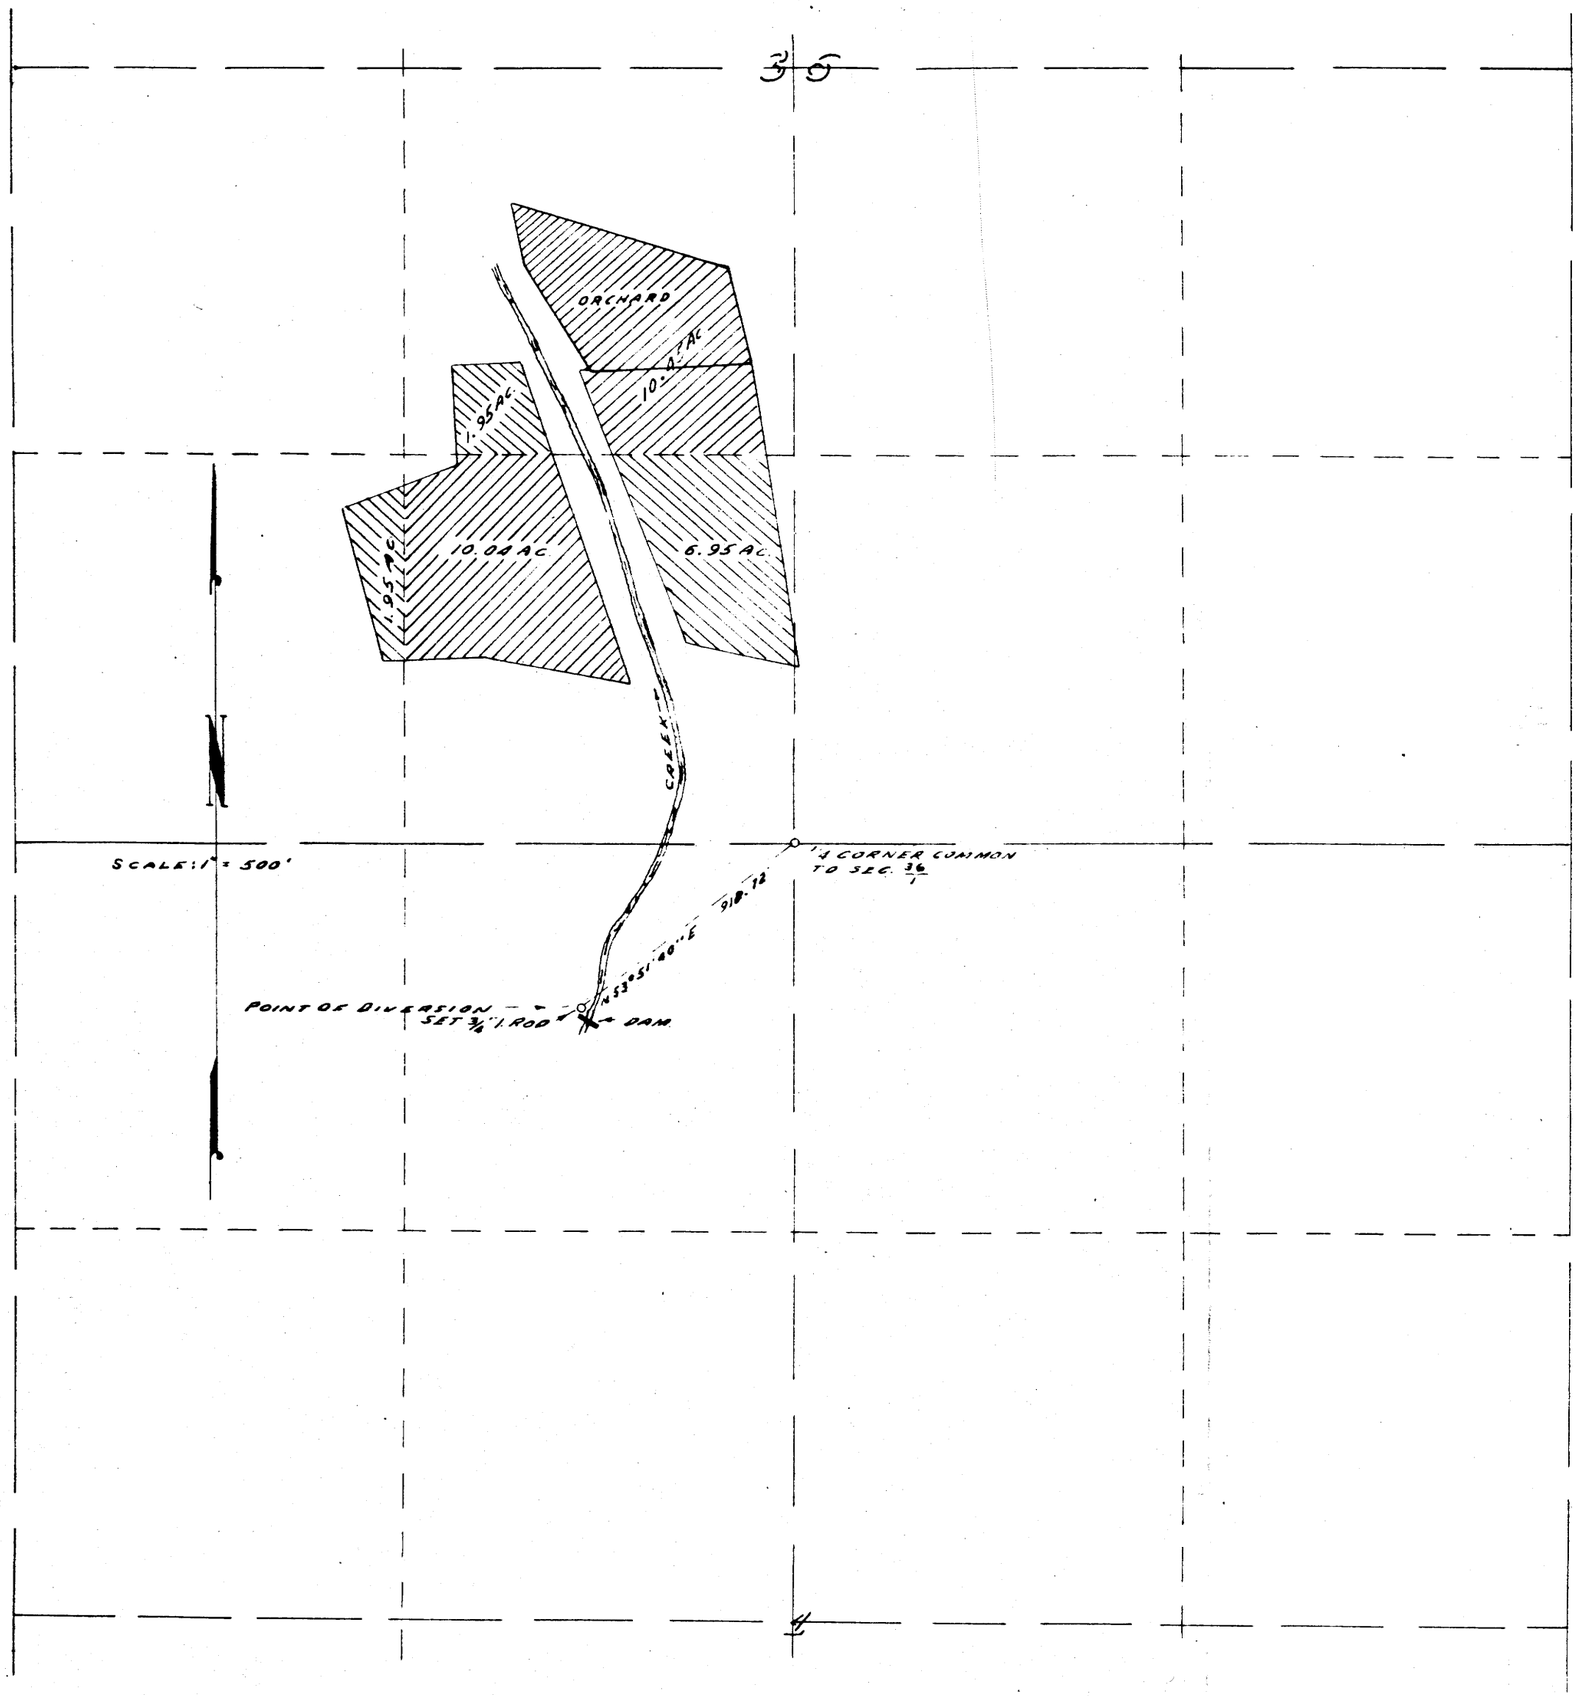

I, JAMES W. BYRON, OF ROSEBURG, OREGON DO HEREBY CERTIFY THAT THIS MAP WAS MADE FROM NOTES TAKEN DURING AN ACTUAL SURVEY MADE JULY 9, 1957 BY ME; THAT THE MONUMENT SHOWN ON THIS MAP CONSISTING OF A 3/4" X 30" IRON ROD, IS S 53°51'40" W 918.72' FROM THE 1/4 CORNER COMMON TO SECTIONS 36/1 T 30 S 31 S, R 6 W. W.M.

James W. Byron
JAMES W. BYRON

REGISTERED
OREGON
LAND SURVEYOR

James W. Byron
NOV. 6, 1933
JAMES W. BYRON
303

THIS COPY MADE FROM
A XEROX 2510
DATE 3-1-89

WATER RIGHT
FOR
H. W. HILES
SECTION 36 T30S., R.6W. W.M.

OFFICE OF
FRED M. DARBY
COUNTY SURVEYOR DOUGLAS COUNTY
ROSEBURG OREGON

DO NOT SELL
ONLY COPY

COUNTY SURVEYOR'S FILE DATA
DO NOT REMOVE FROM OFFICE

MAP FILE M-5-57

M5-57

C.S. FILE 49/3
M5-57 (NOT IN FILE)

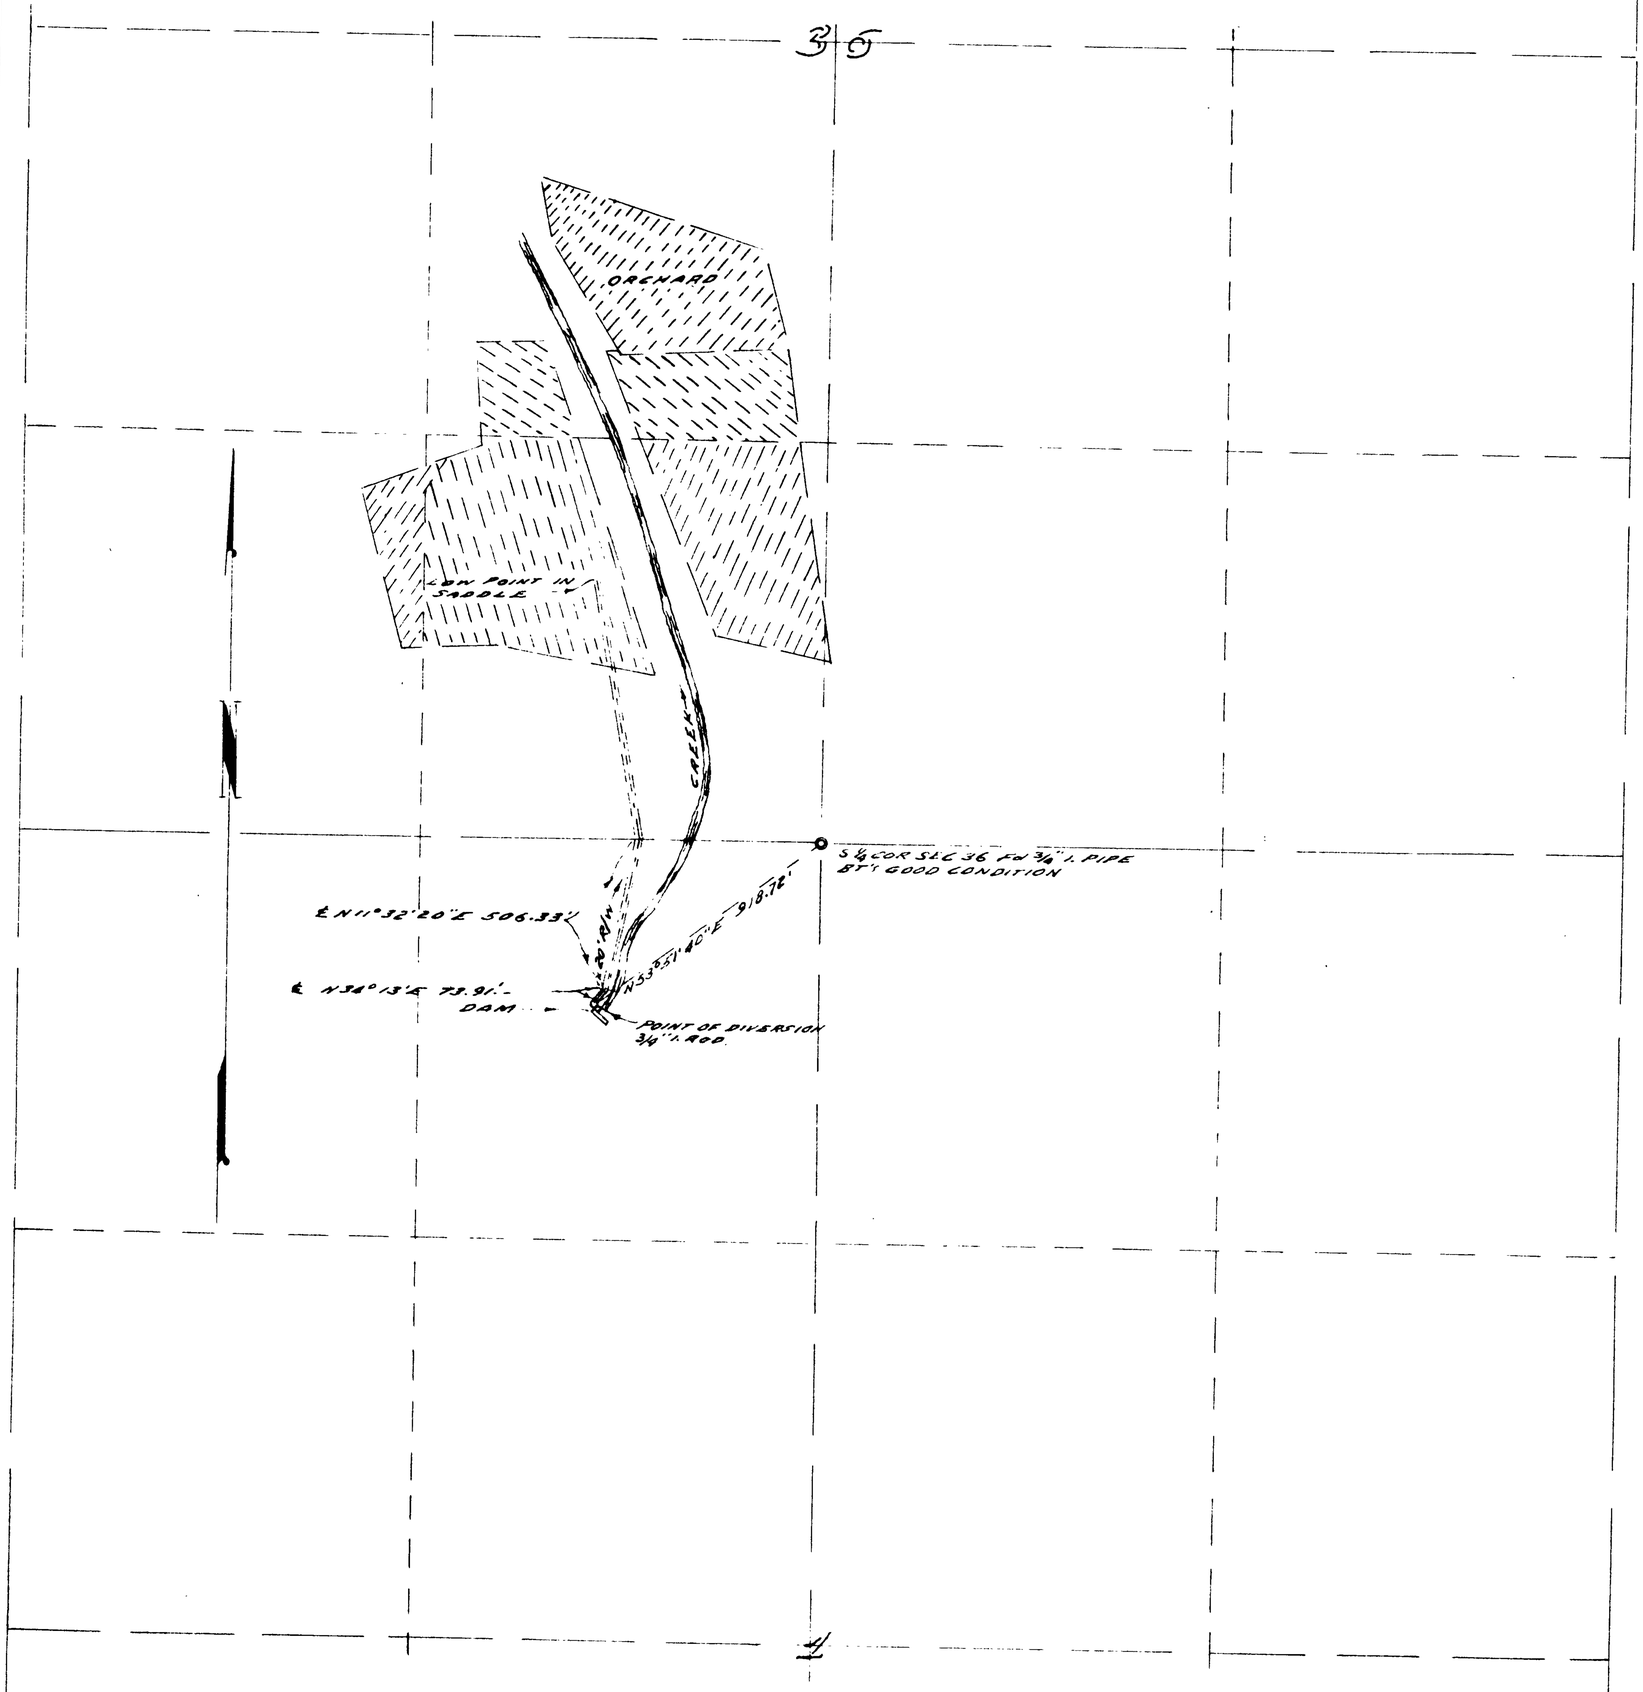

JAMES W. BYRON STATES HE IS BY OCCUPATION A REGISTERED LAND SURVEYOR EMPLOYED BY H. W. HILES, TO MAKE THE SURVEY OF THE RIGHT OF WAY AS DESCRIBED AND SHOWN ON THIS MAP; THAT THE SURVEY OF SAID WORKS WAS MADE BY HIM AND UNDER AUTHORITY, COMMENCING ON THE 9 TH DAY OF JULY 1957 AND ENDING ON THE 9 TH DAY OF JULY 1957; AND THAT SUCH SURVEY IS ACCURATELY REPRESENTED UPON THIS MAP

James W. Byron

James W. Byron

THIS IS TO CERTIFY THAT JAMES W. BYRON, WHO SUBSCRIBED THE STATEMENT HEREON IS THE PERSON EMPLOYED BY THE UNDERSIGNED APPLICANT TO PREPARE THIS MAP WHICH HAS BEEN ADOPTED BY THE APPLICANT AS THE APPROXIMATE FINAL LOCATION OF THE WORKS THEREBY SHOWN; AND THAT THIS MAP IS FILED AS A PART OF THE COMPLETE APPLICATION AND IN ORDER THAT THE APPLICANT MAY OBTAIN THE BENEFITS OF STATUTE _____ AND I FURTHER CERTIFY THAT THE RIGHT - OF - WAY HEREIN DESCRIBED IS DESIRED FOR WATER.

_____
H. W. HILES

= AREA TO BE IRRIGATED

RIGHT - OF - WAY
FOR
H. W. HILES
SECTION 1, T 31 S., R 6 W, W.M.

OFFICE OF
FRED M. DARBY
COUNTY SURVEYOR, DOUGLAS COUNTY
ROSEBURG, OREGON

C.S. FILE 49/3-2

CS FILE FOLDER

CONTAINS

MORE

INFORMATION