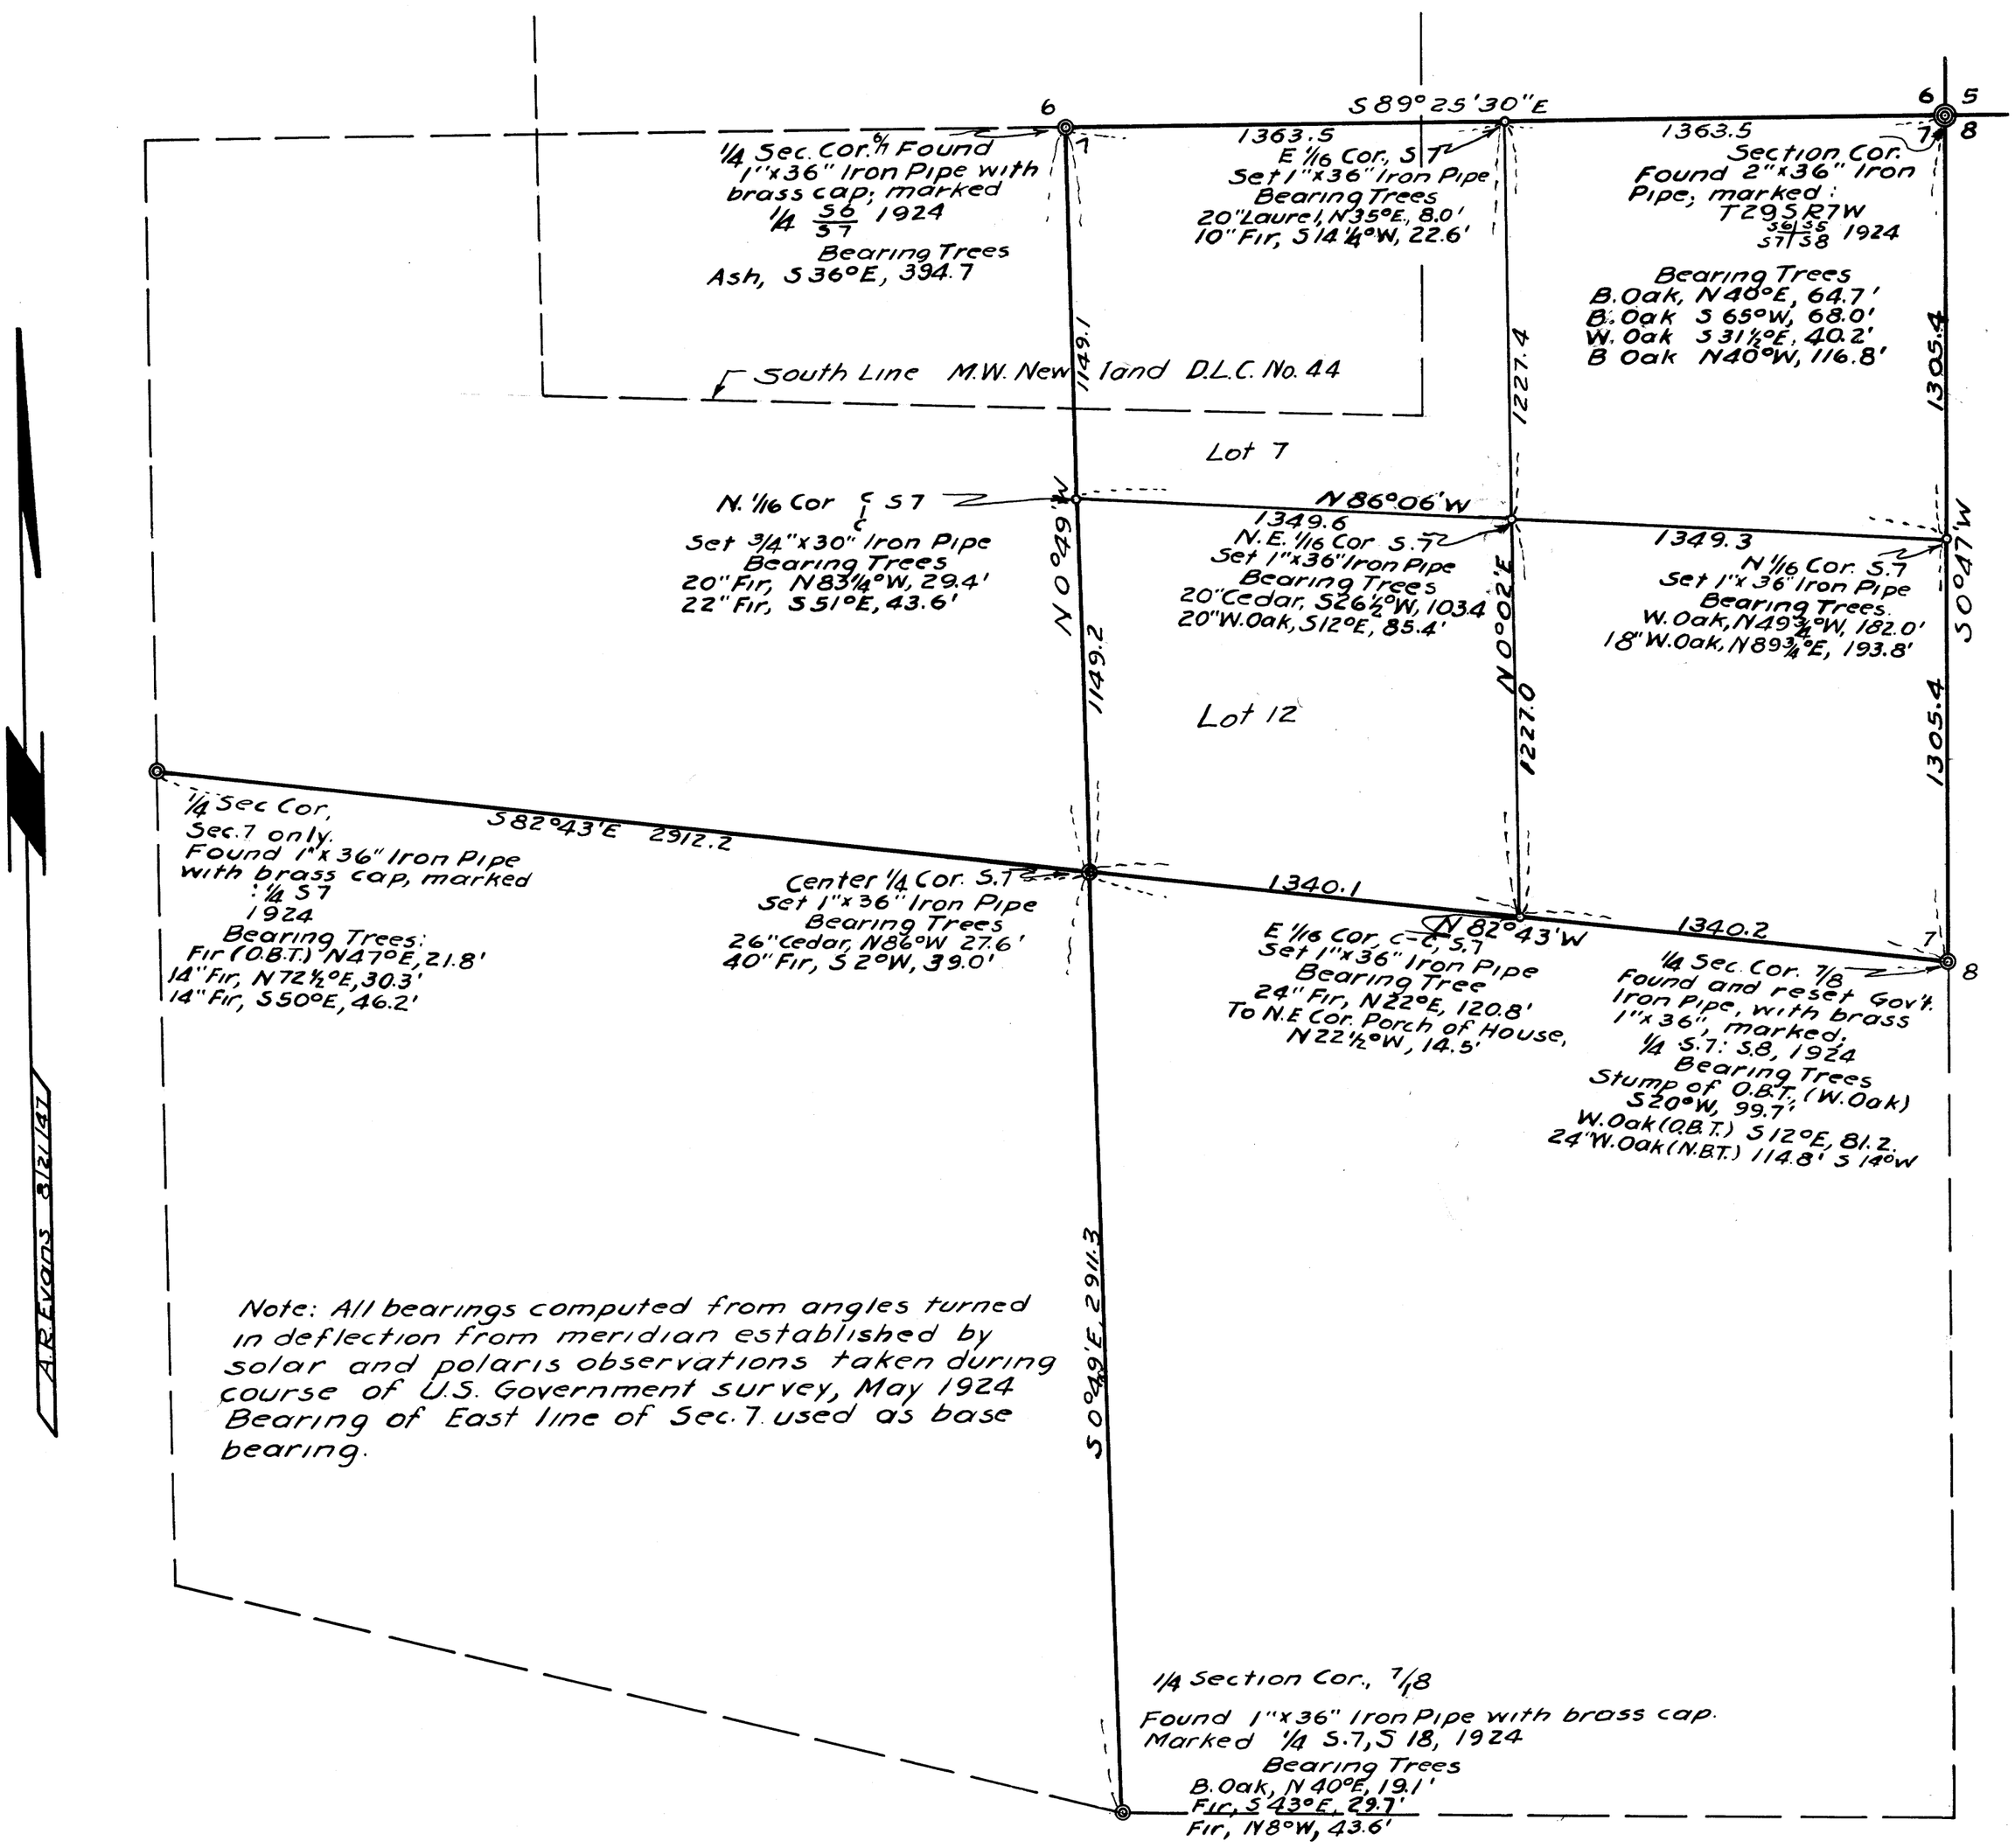

COUNTY SURVEYOR'S OFFICE
DOUGLAS COUNTY OREGON
LEGAL SUBDIVISION
NORTHEAST QUARTER
SECTION 7, T 29S., R 7 W. W.M.

BEN B. IRVING COUNTY SURVEYOR

SURVEYED, JULY - AUGUST, 1947; BY

N.E. RICHARDSON DEPUTY SURVEYOR

SCALE, 1" = 400'

COUNTY SURVEYORS FILE DATA
DO NOT REMOVE FROM OFFICE

C.S. FILE No. 38/188
MAP FILE M 6-14 P