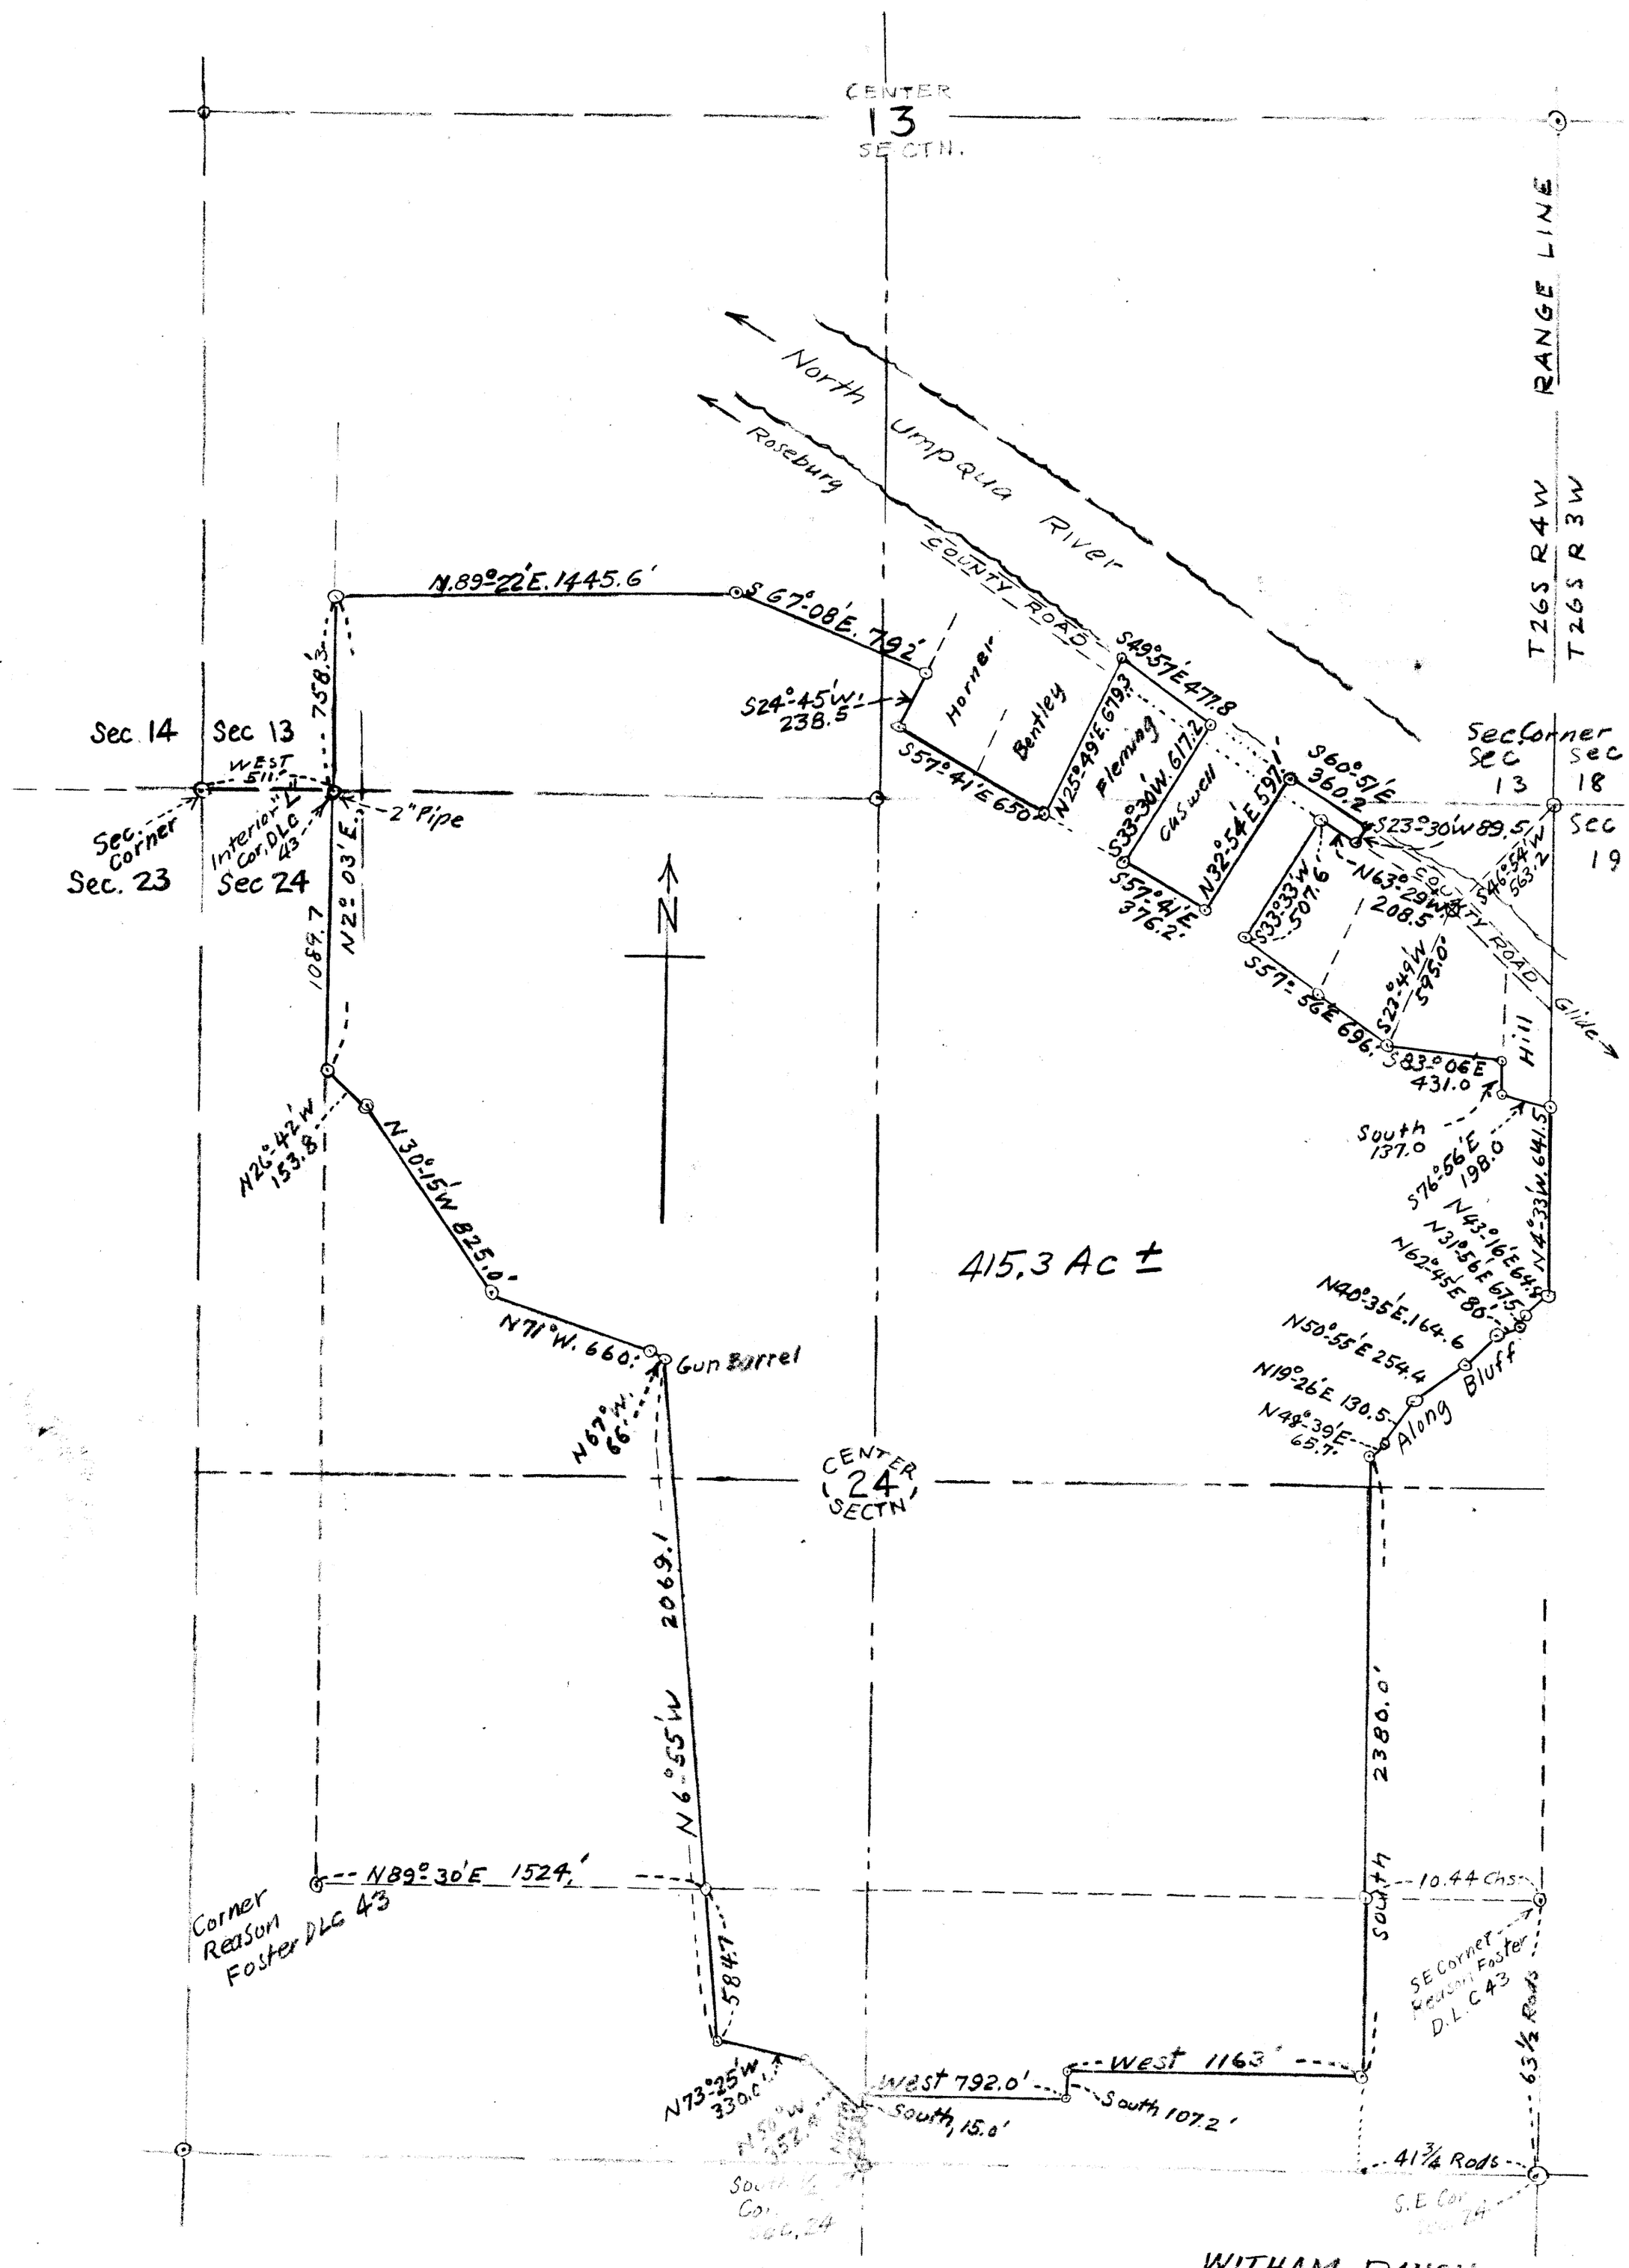

COUNTY SURVEYORS FILE DATA
DO NOT REMOVE FROM OFFICE

WITHAM RANCH

SECS 13 & 24 T26S, R4W, WM.
June-July 1940 Scale 1" = 500'
A. BOYER Dep Co Surveyor
M 6-3