M 6-41

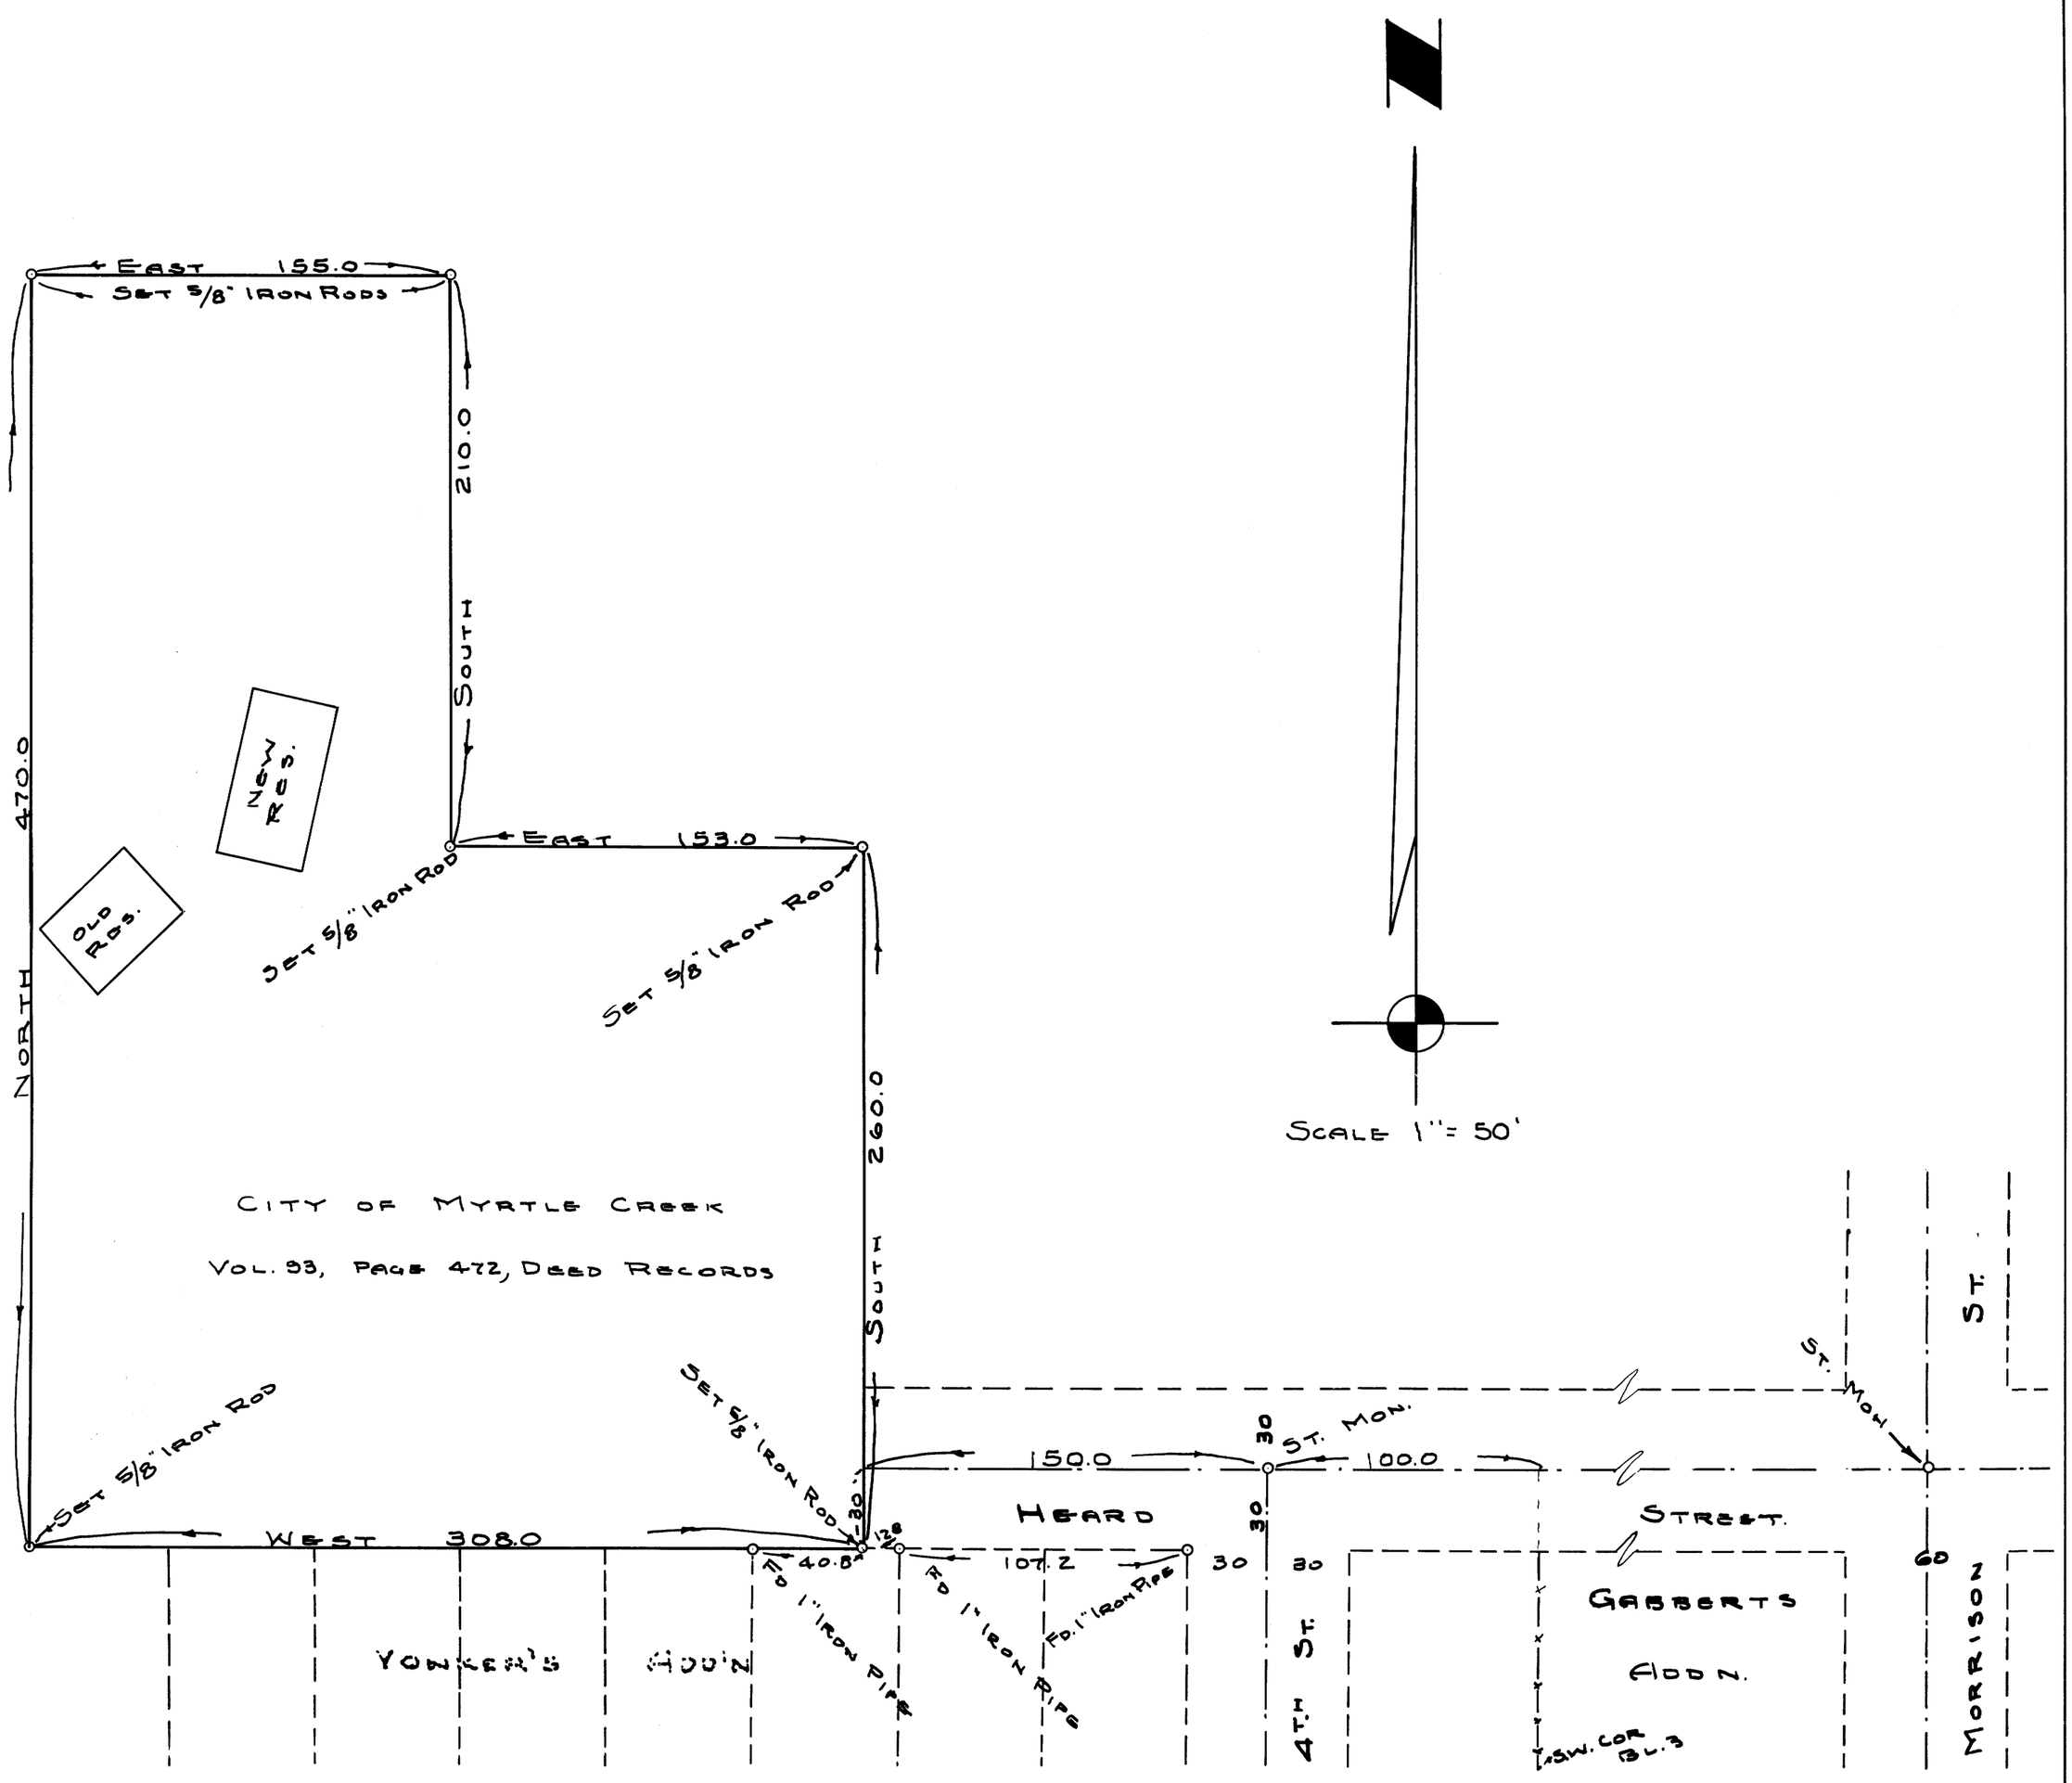

COUNTY SURVEYOR'S OFFICE
DOUGLAS COUNTY OREGON
CORNERS & BD'RY LINES OF RESERVOIR SITE, MYRTLE CREEK, ORE.

REGISTERED PROFESSIONAL ENGINEER 2741 OREGON NOV. 7, 1947 ARTHUR R. EVANS

BEN B. IRVING, REG. PROF. ENG'R., COUNTY SURVEYOR
SURVEYED & PLATTED, JUNE, 1951, BY
A. R. EVANS, REG. PROF. ENG'R., DEP. CO. SURVEYOR

COUNTY SURVEYORS FILE DATA
DO NOT REMOVE FROM OFFICE

M 6-41