MAP FILE M 6-47

FILED
RECEIVED
DEC 20 1955
COUNTY SURVEYOR
DOUGLAS COUNTY, ORE.

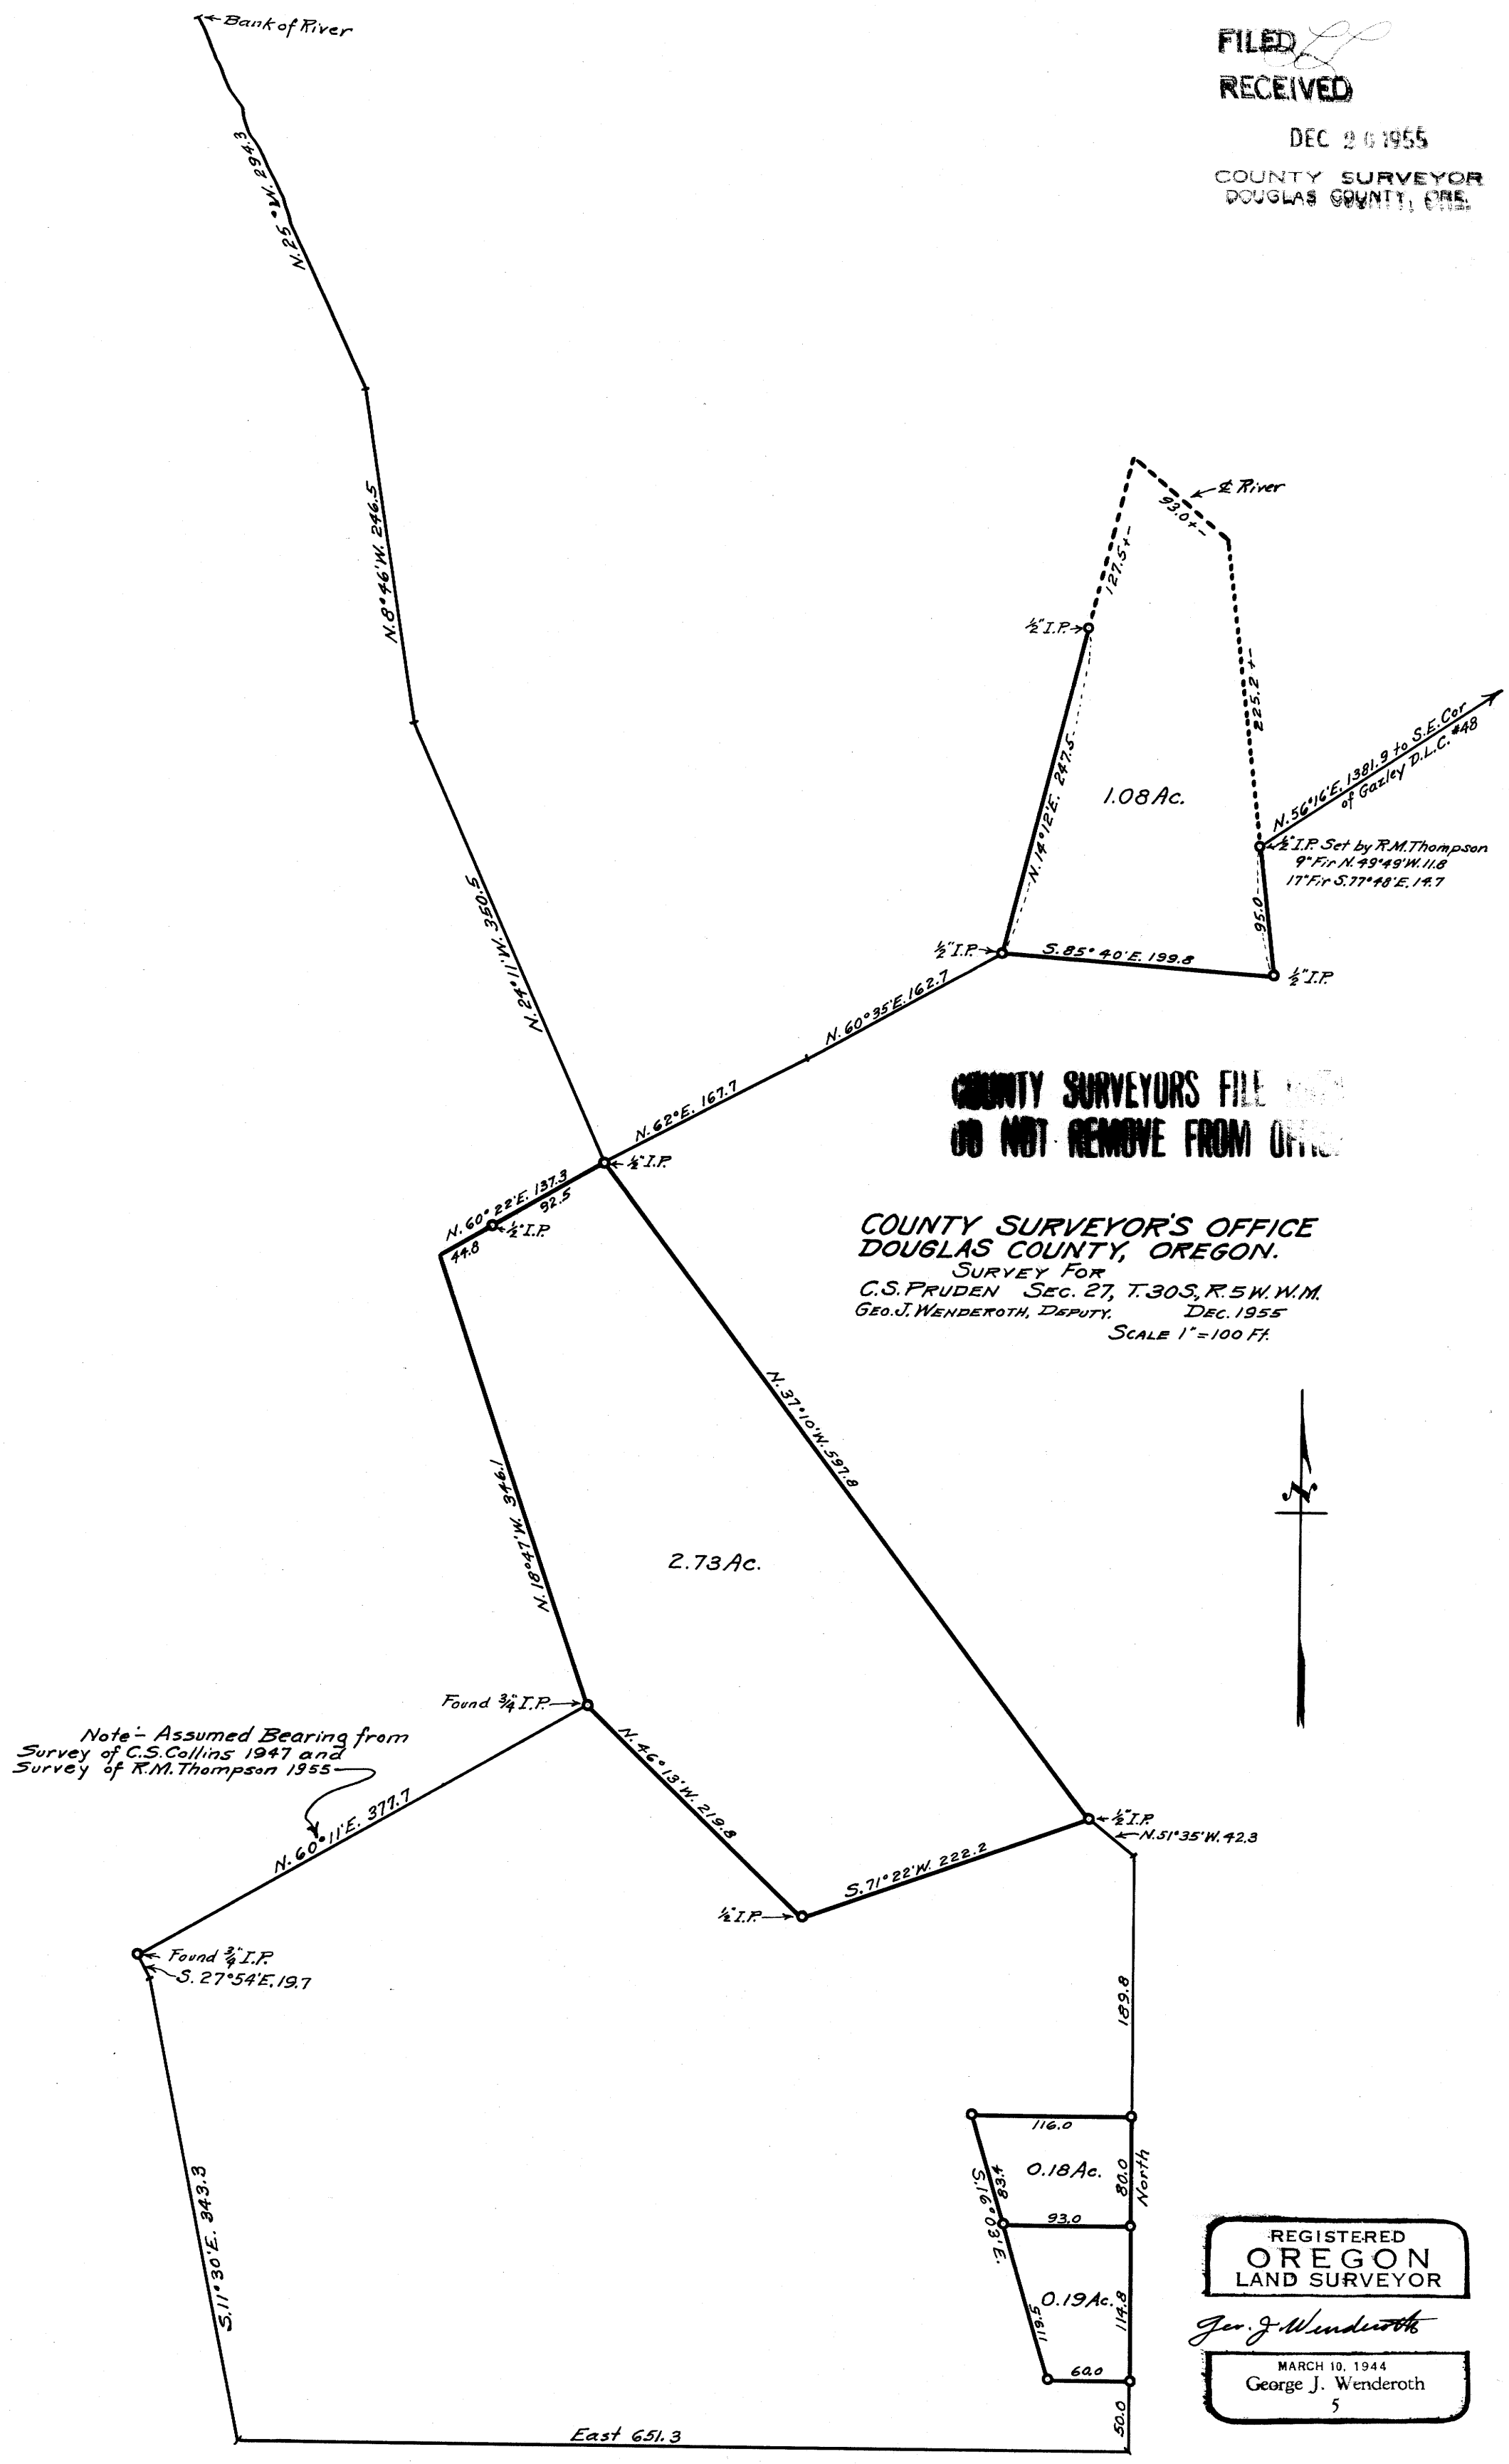

COUNTY SURVEYORS FILE
DO NOT REMOVE FROM OFFICE

COUNTY SURVEYOR'S OFFICE
DOUGLAS COUNTY, OREGON.
SURVEY FOR
C.S. PRUDEN SEC. 27, T.30S, R.5W. W.M.
GEO. J. WENDEROTH, DEPUTY. DEC. 1955
SCALE 1" = 100 FT.

REGISTERED
OREGON
LAND SURVEYOR
Geo. J. Wenderoth
MARCH 10, 1944
George J. Wenderoth
5

M6-47
C. S. File No. 47/36