

LOT 3
 LOT 4
 LOT 5
 T W J N
 PLAT BOOK 8
 A C F L S
 PAGE 30
 84.0
 86.3
 50°07'E = 50°04'E (TWIN ACRES)
 Fd. 3/4" I.P.
 Fd. 1/2" I.P.
 Fd. 5/8" I.P.

55
 ROAD

55
 KEARSEY

ERNEST S. & EULA M. WENTJAR
 VOL. 185 PAGE 475
 DEED RECORDS


EARL T. & DOROTHY G. NELSON
 VOL. 96 PAGE 233
 DEED RECORDS

1 1/2" I.P. - BRASS CAP
 N.W. COR. ISAAC JONES
 D.L.C. NO. 65

ADRIAN & VERA STANLEY
 CIRCUIT COURT CASE # 14360

S.E. COR. JOHN LEHNHERR
 D.L.C. NO. 52
 (CORNER NOT IN PLACE)

NOTE:-
 BEARINGS SHOWN ARE TRUE, BASED ON
 A SOLAR OBSERVATION MADE FOR SURVEY OF
 U.S. VETERANS FACILITY.

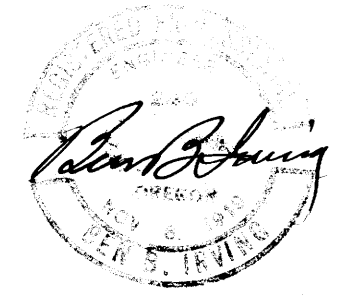

COUNTY SURVEYOR'S OFFICE
 DOUGLAS COUNTY, OREGON

SURVEY FOR DEED DESCRIPTION,
 IN JOHN LEHNHERR D.L.C. NO. 52,
 T27S, R6W, W.M.

BEN B. IRVING COUNTY SURVEYOR
 SURVEYED APRIL 10, 1954 SCALE 1" = 40'
 SURVEYED FOR L.D. BAXTER

COUNTY SURVEYORS FILE DATA
 DO NOT REMOVE FROM OFFICE

M 6-64

M 6-

4