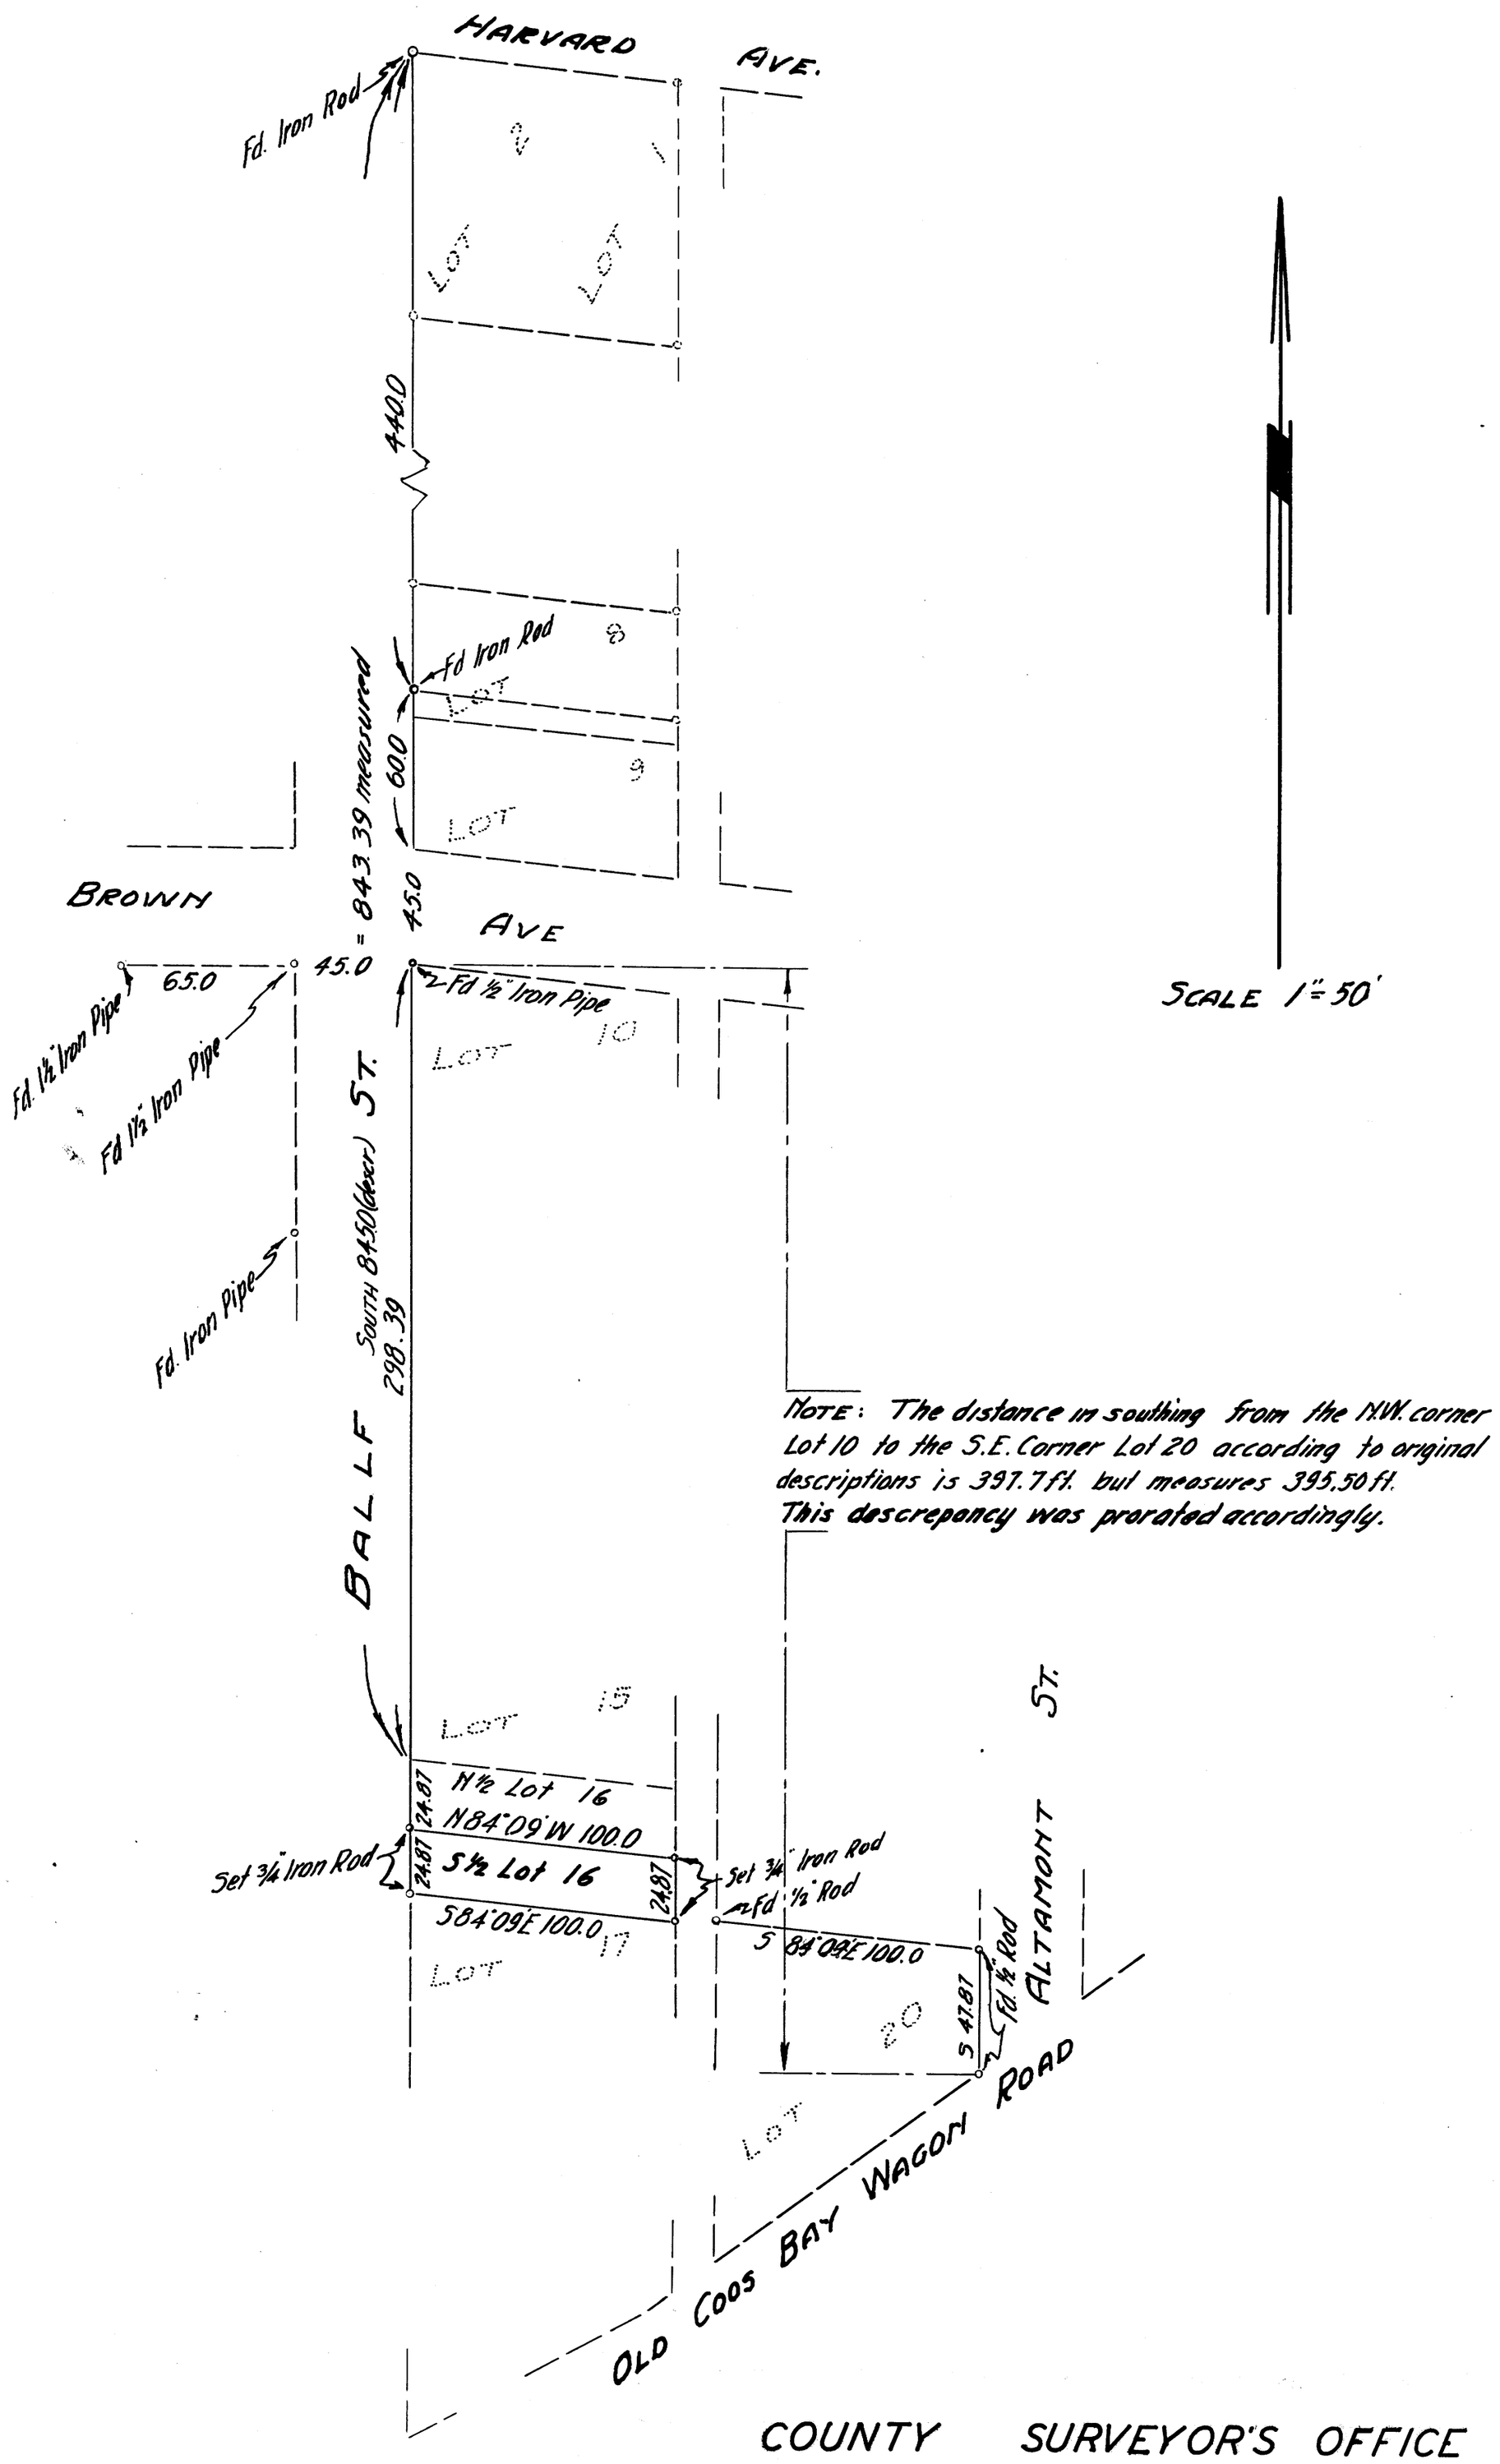

NOTE: The distance in southing from the N.W. corner Lot 10 to the S.E. Corner Lot 20 according to original descriptions is 397.7 ft. but measures 395.50 ft. This descrepancy was prorated accordingly.

COUNTY SURVEYOR'S OFFICE
DOUGLAS COUNTY OREGON

SURVEY FOR SOUTH HALF LOT 16
UNRECORDED BALLF TRACTS

L. L. POWERS OWNER

BEN. B. IRVING COUNTY SURVEYOR
SURVEYED MARCH 1954

COUNTY SURVEYORS FILE COPY
DO NOT REMOVE FROM OFFICE

FILE 46-5