

N 89° 19' E 600.2

LOT 12

LOT 13

LOT 14

LOT 15

B L O C K

ONE

A N D

20.37 AC.

10 ACRES

1.01 ACRES

NOTE: Base Bearing NOT TO BE ALONG THE NORTH LINE OF THE COUNTY ROAD AS SHOWN ON MAP OF GLENGARRY FRUIT LANDS.



SET 3/4 INCH IRON ROD

SET 3/4 INCH IRON ROD

SET 3/4 INCH IRON ROD

SET 3/4 INCH IRON ROD

351.5' PRORATED = (349.8' PART)


462.87' PRORATED

427.37' PRORATED
N 87° 49' E
226.9 COUNTY ROAD NO 16

NOTE: - THIS MAP REVISED BY ADDING SURVEY OF 20.37 AC. PARCEL AS DEFINED BY 3/4" IRON RODS SHOWN THUS; •. THIS SURVEY MADE IN OCTOBER, 1955.

COUNTY SURVEYORS FILE DO NOT REMOVE FROM OFF

COUNTY SURVEYOR'S OFFICE
DOUGLAS COUNTY, OREGON
SURVEY FOR DEED DESCRIPTION
PORTION OF LOTS 13 AND 14
GLENGARRY FRUIT LANDS

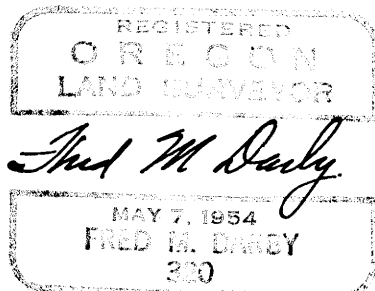

BEN B. IRVING COUNTY SURVEYOR
SURVEYED JULY 22, 1955 BY
JAMES W. BYRON - DEPUTY SCALE 1" = 100'
SURVEYED FOR C. B. MC. GHEHEY