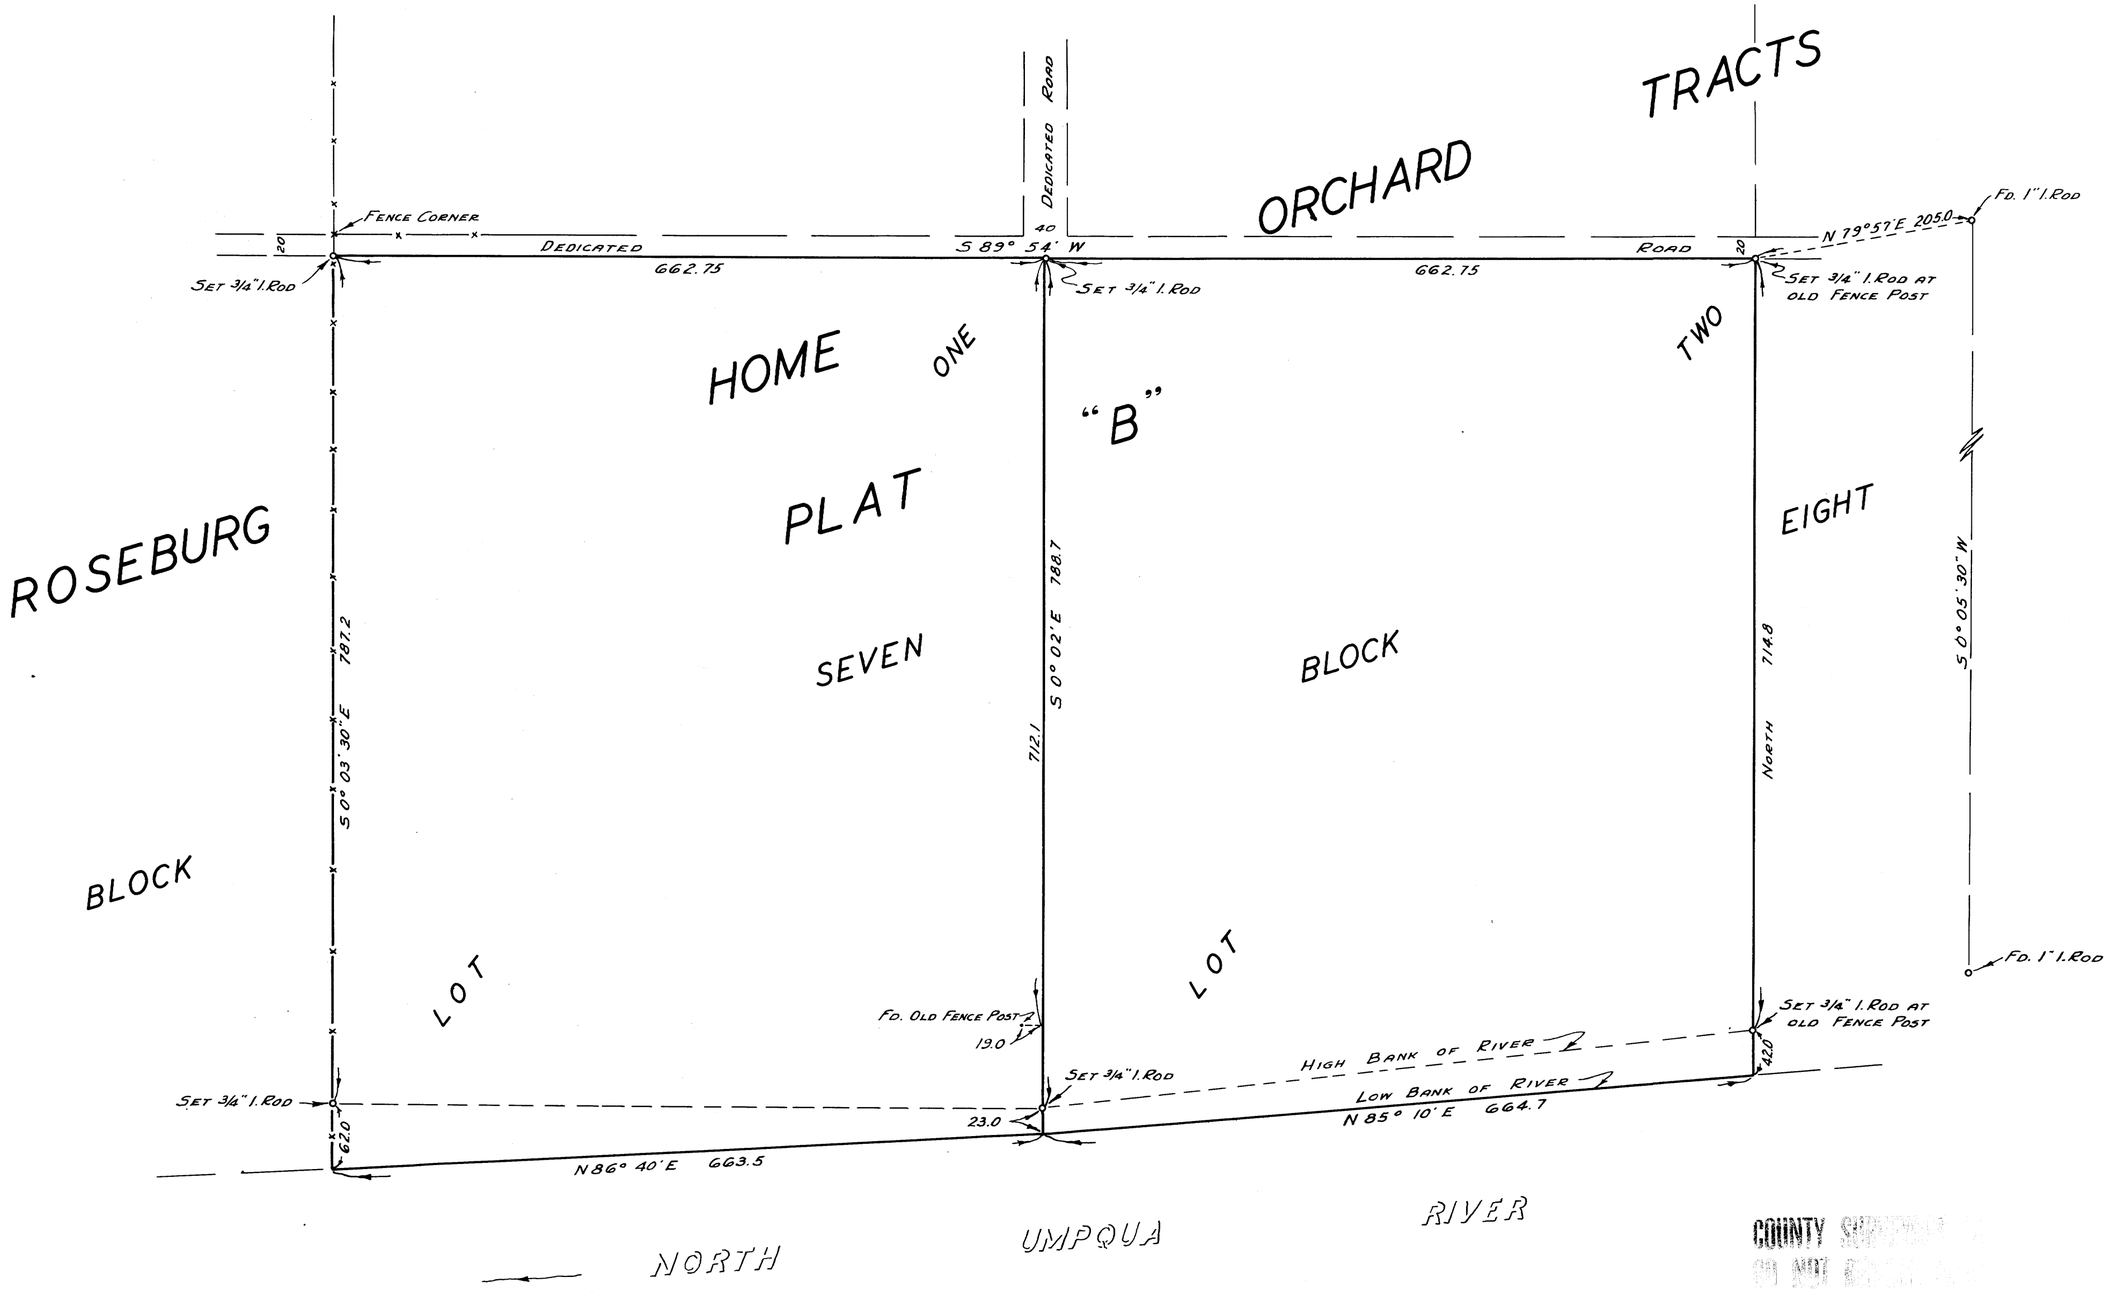


COUNTY SURVEYOR'S OFFICE
DO NOT REMOVE

COUNTY SURVEYOR'S OFFICE
DOUGLAS COUNTY. OREGON

SURVEY TO ESTABLISH LOT CORNERS.

N.E. Richardson

BEN. B. IRVING COUNTY SURVEYOR
SURVEYED FEB. 9-13. 1951 BY
N.E. RICHARDSON DEPUTY
SCALE 1" = 100'

MAP FILE M-7-35

45/7