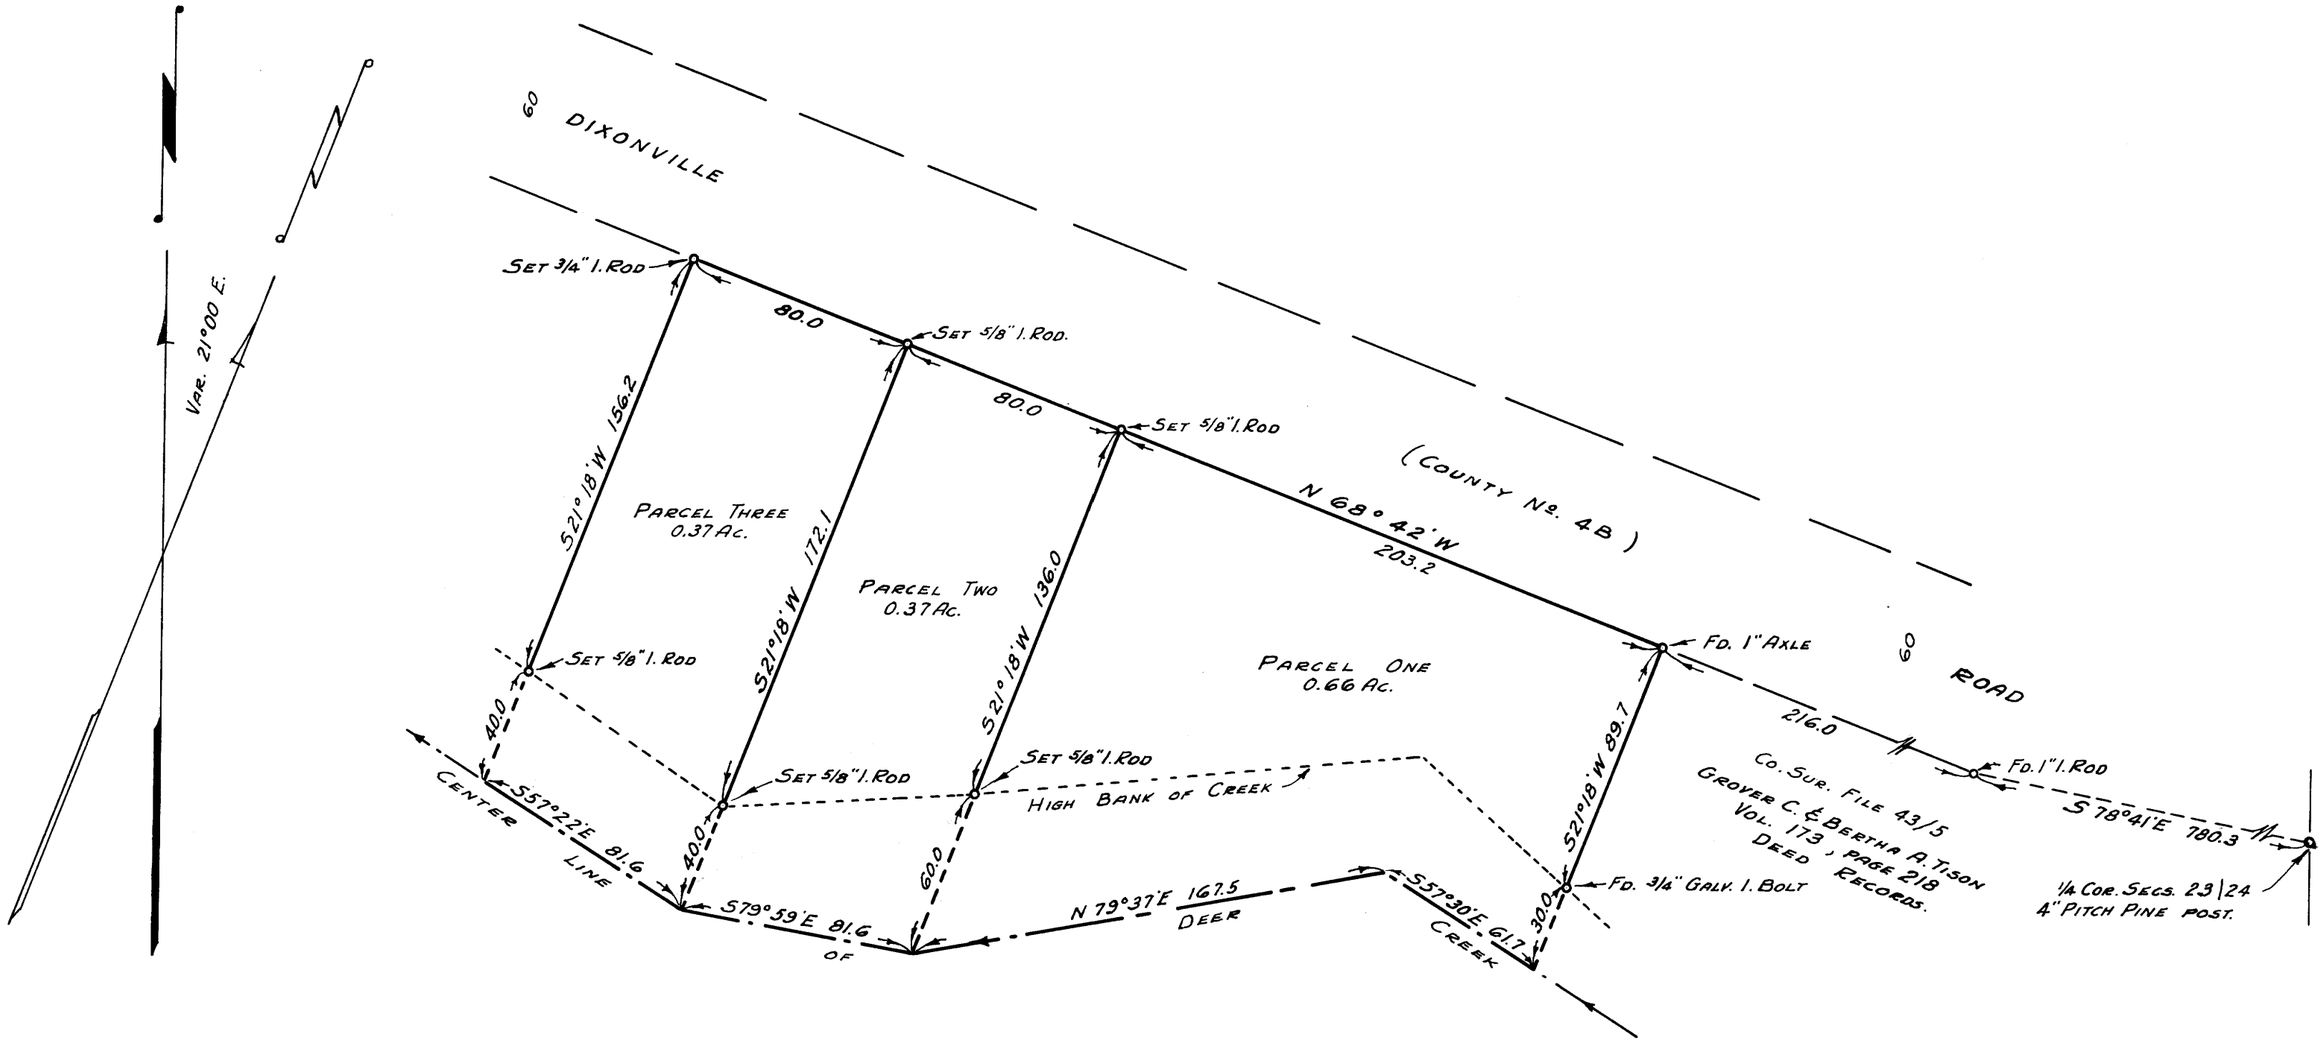

COUNTY SURVEYORS OFFICE
DOUGLAS COUNTY, OREGON

SURVEY FOR DEED DESCRIPTIONS,
SECTION 23, T27S., R5W., W.M.

BEN. B. IRVING COUNTY SURVEYOR
SURVEYED JAN. 24, 1952. SCALE 1" = 50'

COUNTY SURVEYORS FILE DO
DO NOT REMOVE FROM OFF

45/19
MAP FILE M 7-38

M 7-38

C. S. File No. 45/19