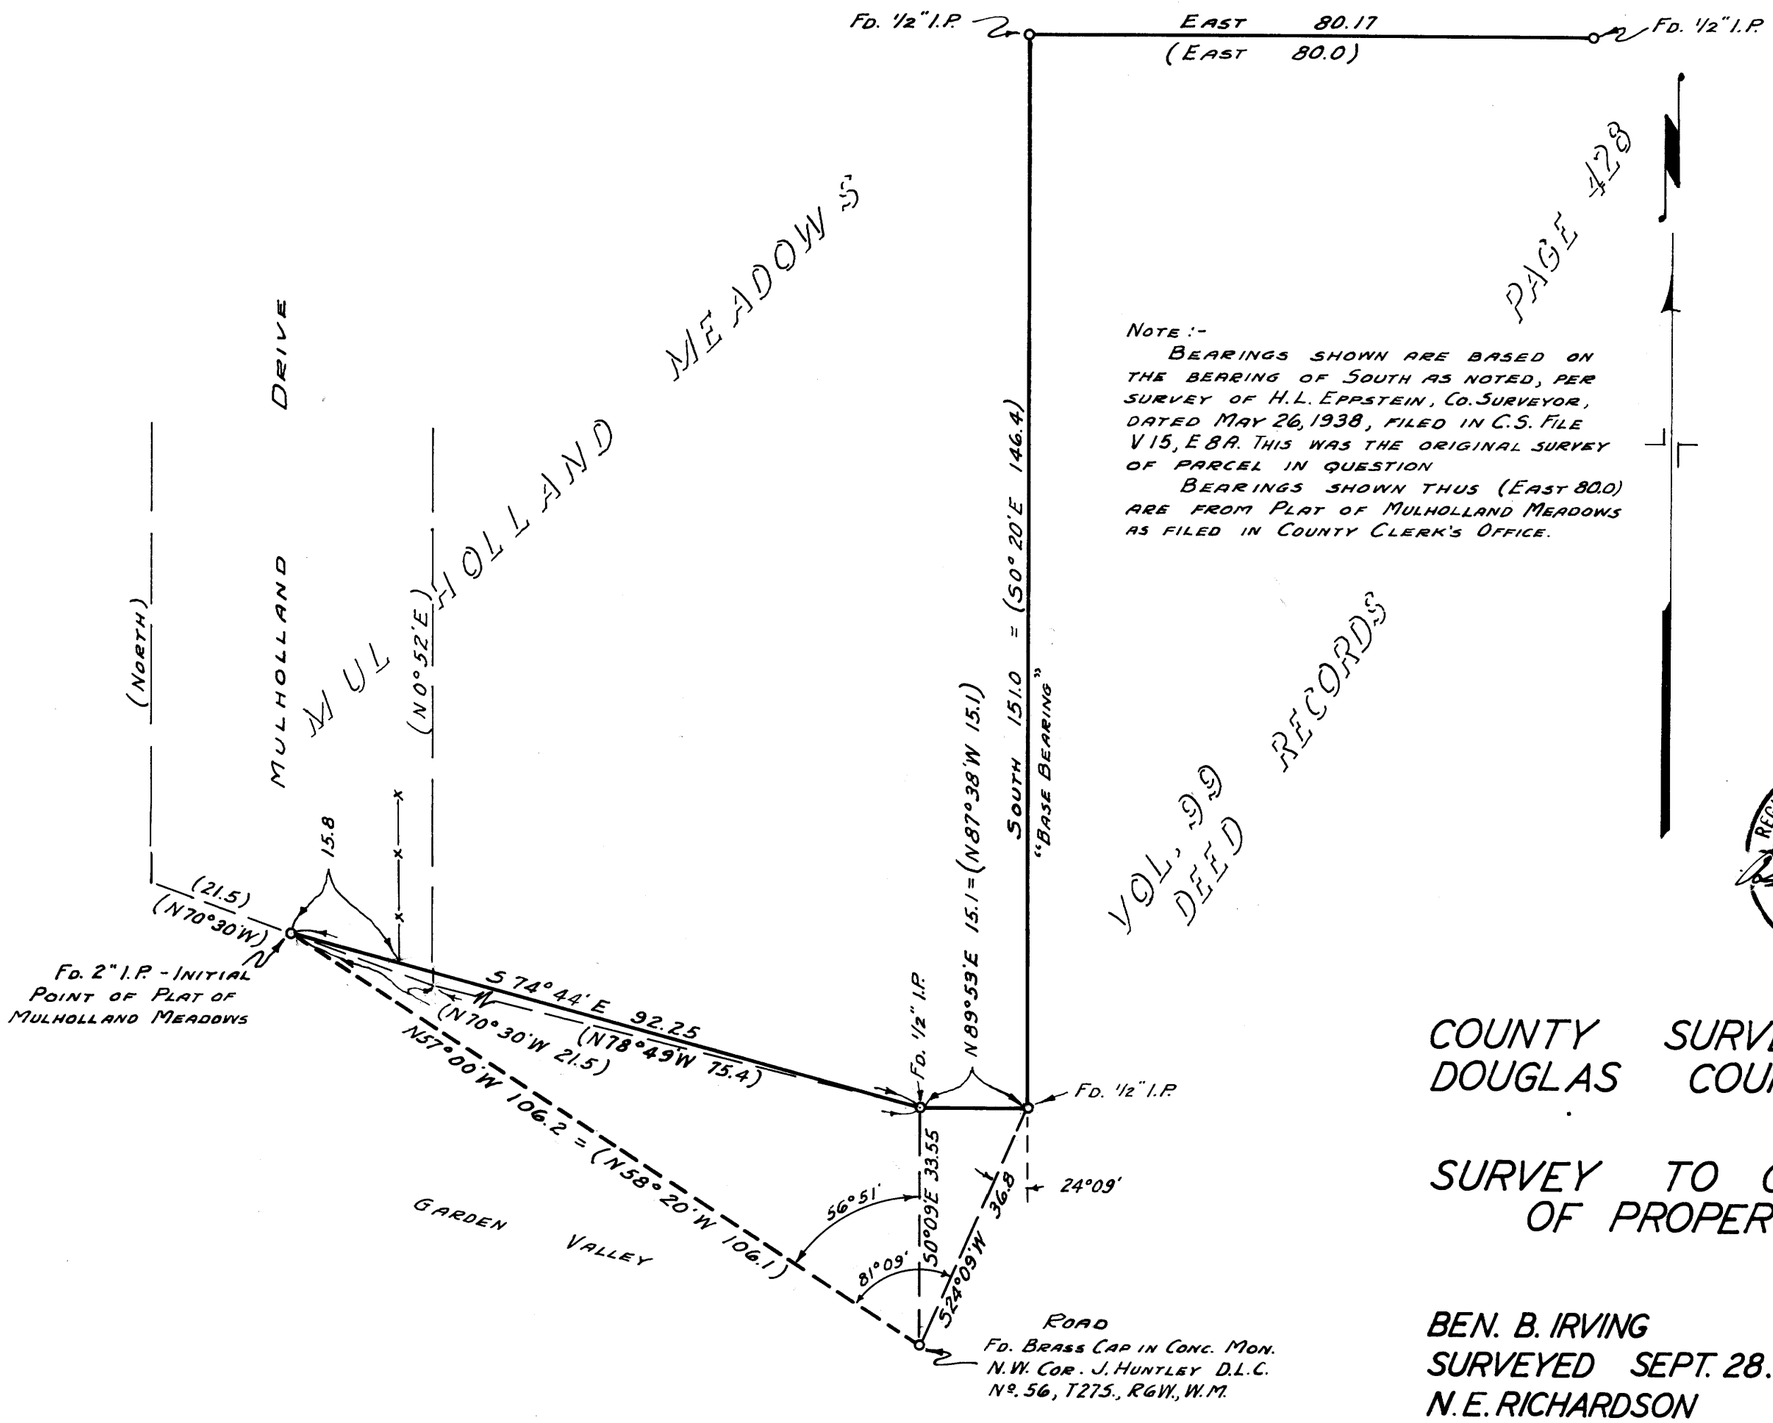

Registered Professional Engineer 240 Oregon Nov 8. 1919 Ben B. Irving

COUNTY SURVEYOR'S OFFICE
DOUGLAS COUNTY. OREGON

SURVEY TO CHECK LOCATION OF PROPERTY CORNERS.

BEN. B. IRVING COUNTY SURVEYOR
SURVEYED SEPT. 28. 1951 BY
N.E. RICHARDSON DEPUTY
SCALE 1"=20'

COUNTY SURVEYOR
DO NOT REMOVE

45/32
MAP FILE M 7-42

C.S. File No. 45/32
MAP FILE M 7-42