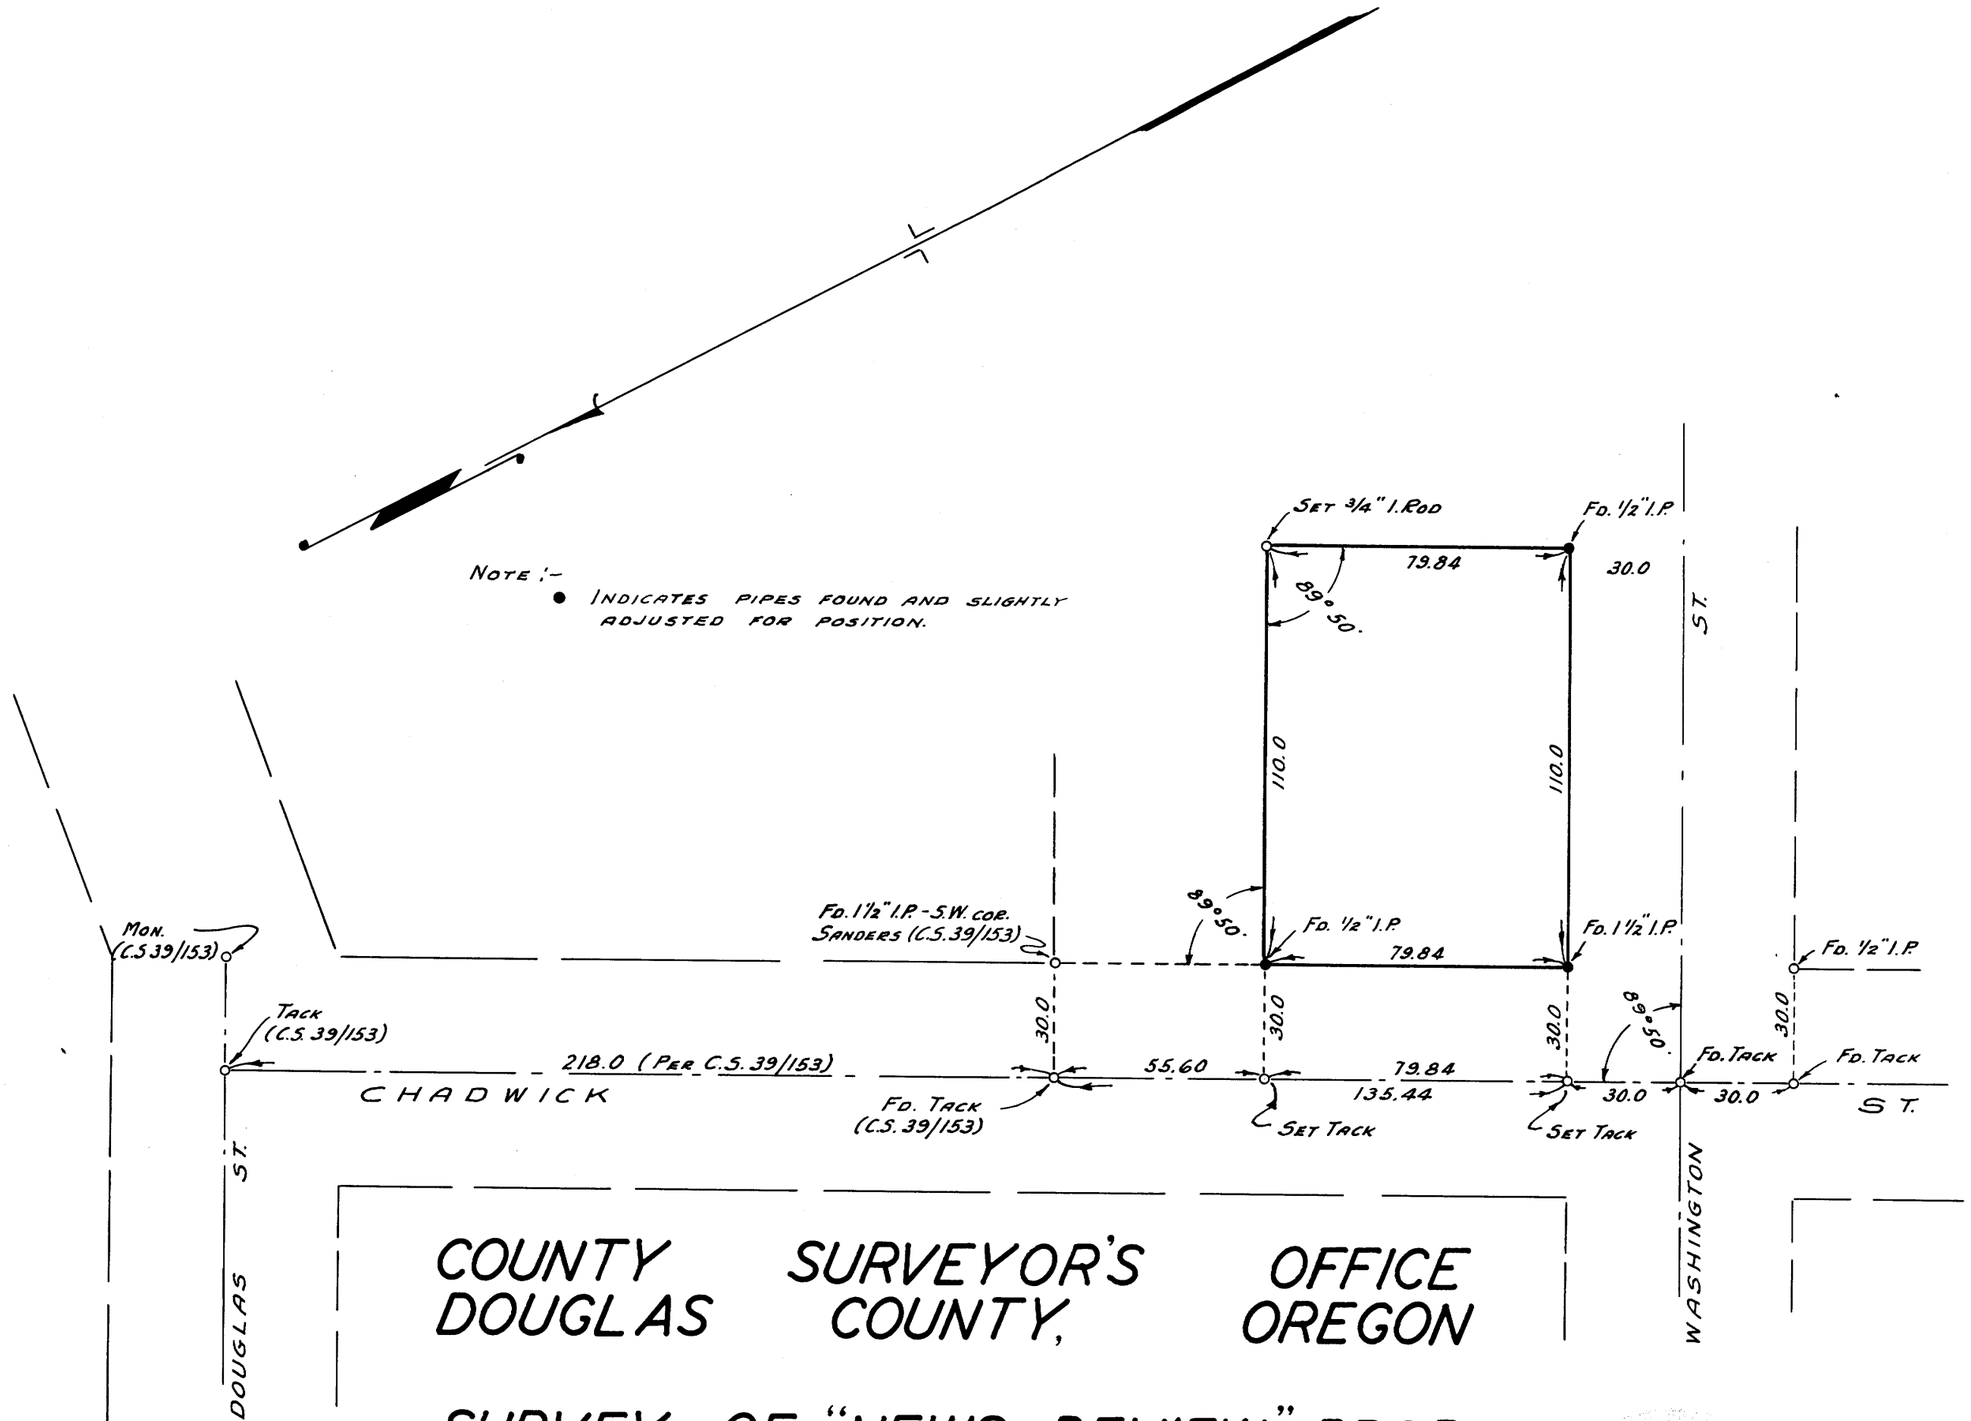

COUNTY SURVEYOR'S OFFICE
DOUGLAS COUNTY, OREGON

SURVEY OF "NEWS-REVIEW" PROPERTY, ROSEBURG, ORE.

SURVEYED JAN. 29, 1953 — SCALE 1" = 40'

BEN B. IRVING — COUNTY SURVEYOR

COUNTY SURVEYORS FILE DR
DO NOT REMOVE FROM OFFI

45/129
MAP FILE M 7-76

45-129