COUNTY SURVEYORS FILE DATA
DO NOT REMOVE FROM OFFICE

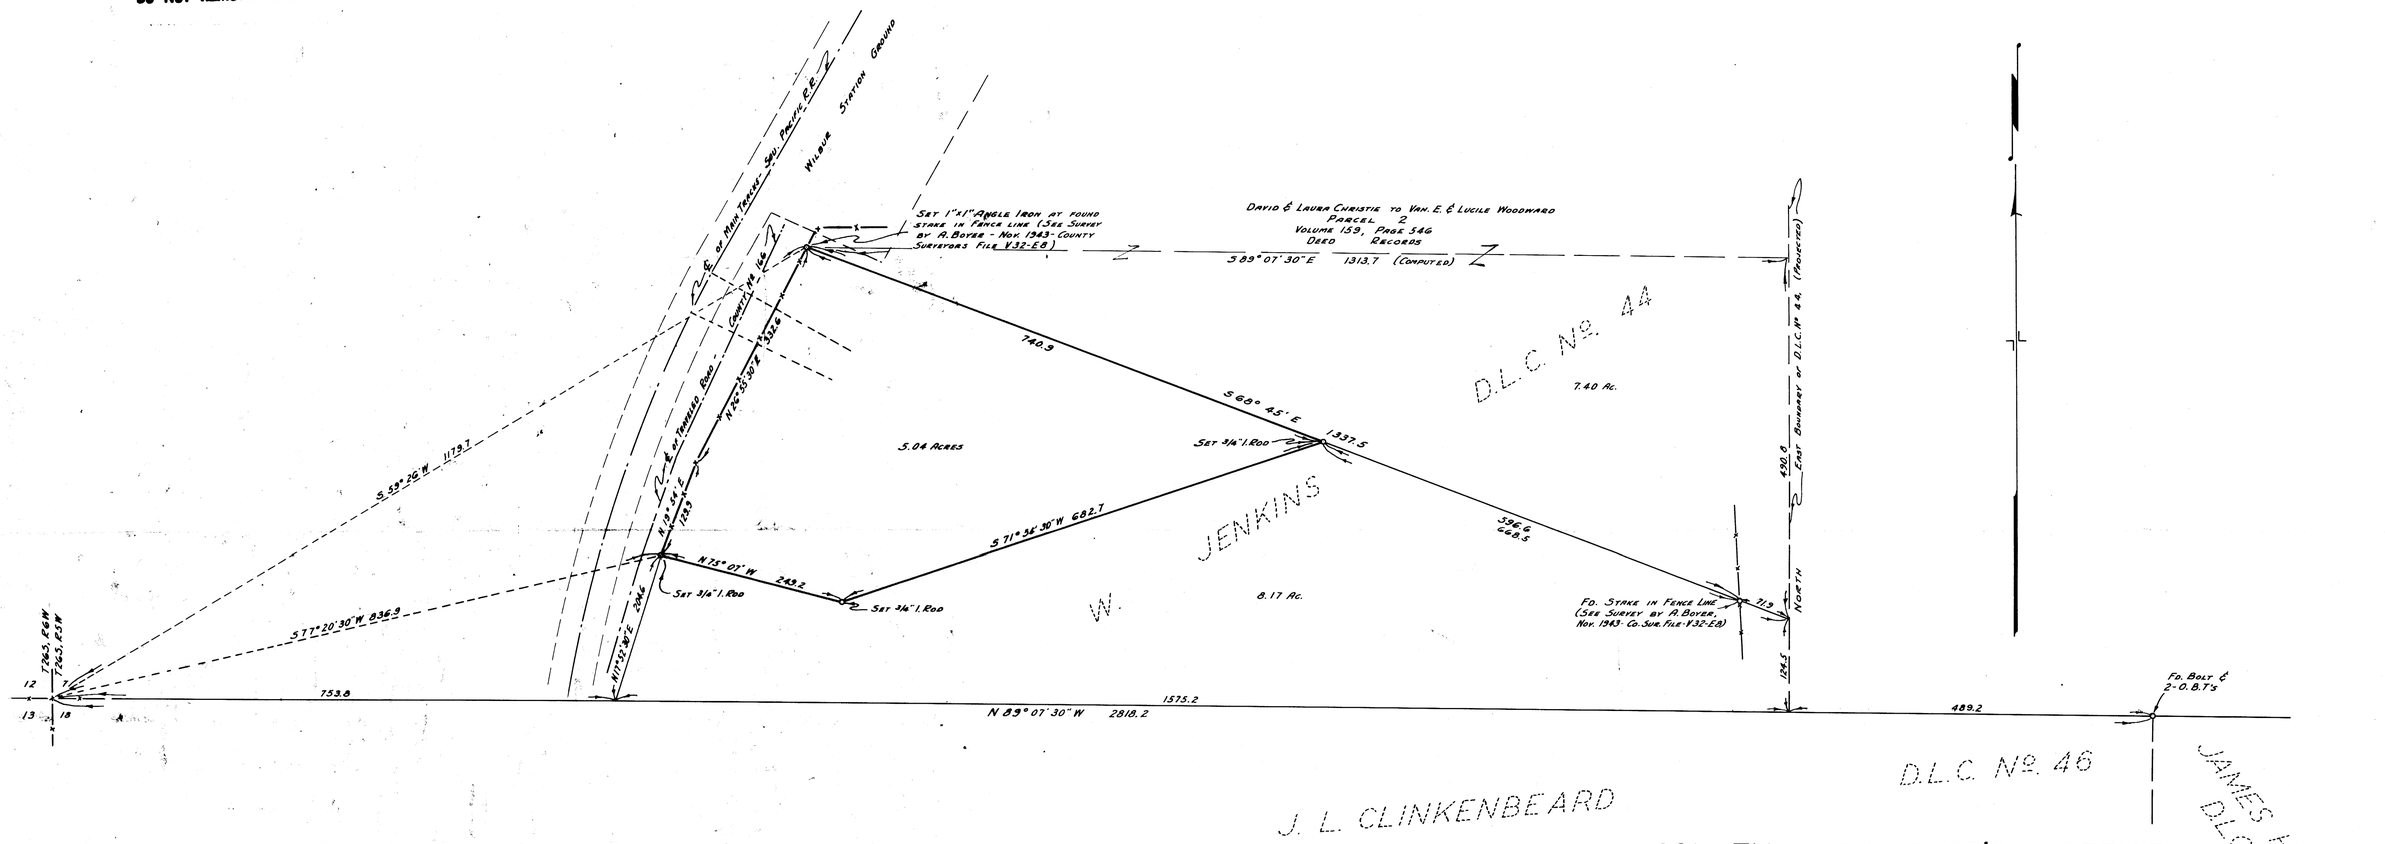

NOTE:-
BEARINGS SHOWN ARE BASED ON DEED BEARING OF S 68° 45' E AS RECITED IN PARCEL TWO, VOLUME 159, PAGE 546 OF DEED RECORDS OF DOUGLAS COUNTY, OREGON.

COUNTY SURVEYOR'S OFFICE
DOUGLAS COUNTY, OREGON

SURVEY FOR DEED DESCRIPTION
IN D.L.C. No 44, SEC. 7, T 26 S, R 5 W.

BEN B. IRVING — COUNTY SURVEYOR
SURVEYED DEC., 1952 — SCALE 1" = 100'

COUNTY SURVEYORS FILE DATA
DO NOT REMOVE FROM OFFICE

C. S. File No. 45/112
MAP FILE M8-32